

Received at WEST HARTLEPOOL Dec. 24.4.00. 100

Lloyd's Register of British and Foreign Shipping.

(Report on Vessel No. 11266 Port, WEST HARTLEPOOL.)WpoolNo. 4269a

SHIP FORGINGS OR CASTINGS.

I have to report that the undermentioned Iron or Steel Forgings or Castings,
 manufactured by Messrs H Gray & Co.
 of Hartlepool for the Vessel No. 612, being built
 by Messrs H Gray & Co. of Hartlepool
 have been inspected by me as set forth below, and found to be, so far as can be seen,
sound.

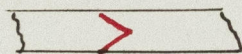
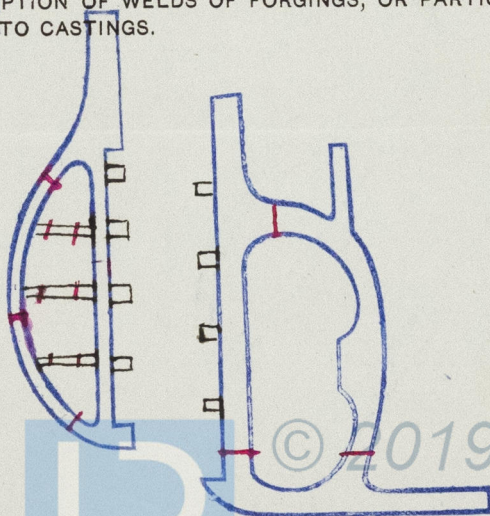
Mark on Forgings.

Lloyd's

No. 4269aW.C.Wm H CameronSunderland23/4/00.

	STERN FRAME.	RUDDER FRAME.	STEM.
Material* ...	<u>Scrap</u>	<u>Scrap</u>	<u>Scrap</u>
How made ...	<u>Forged</u>	<u>Forged</u>	<u>Forged</u>
Dimensions ...	<u>11" x 6"</u>	<u>8 1/2" - 4 1/4"</u>	<u>10 1/2" x 2 3/4"</u>
Progress on Inspection	<u>Forged & Smithed</u>	<u>Forged & Smithed</u>	<u>Forged</u>
Date when Inspected	<u>July 1st to March 8/1900</u>	<u>March 1st to April 10/1900</u>	<u>July 1/1900</u>

SKETCHES OF FRAMES SHOWING POSITION AND DESCRIPTION OF WELDS OF FORGINGS, OR PARTICULARS OF
 TESTS APPLIED TO CASTINGS.

Weld

Fee (if any chargeable) £ : :

To be paid at

* If of Iron, state whether scrap or puddled Iron.