


1100DS
21.3.00
ONION

Under deck tonnage about 2840 tons.

S. S. 612. PUMPING ARRANGEMENT.

SCALE 1/8 INCH = 1 FOOT

Note - In lieu of separate hand pumps for each hold, one vertical fly-wheel hand pump placed on deck to be of a suitable size to pump from the ends of vessel, with 3" suction, will be connected to steam suction pipes leading from each hold.

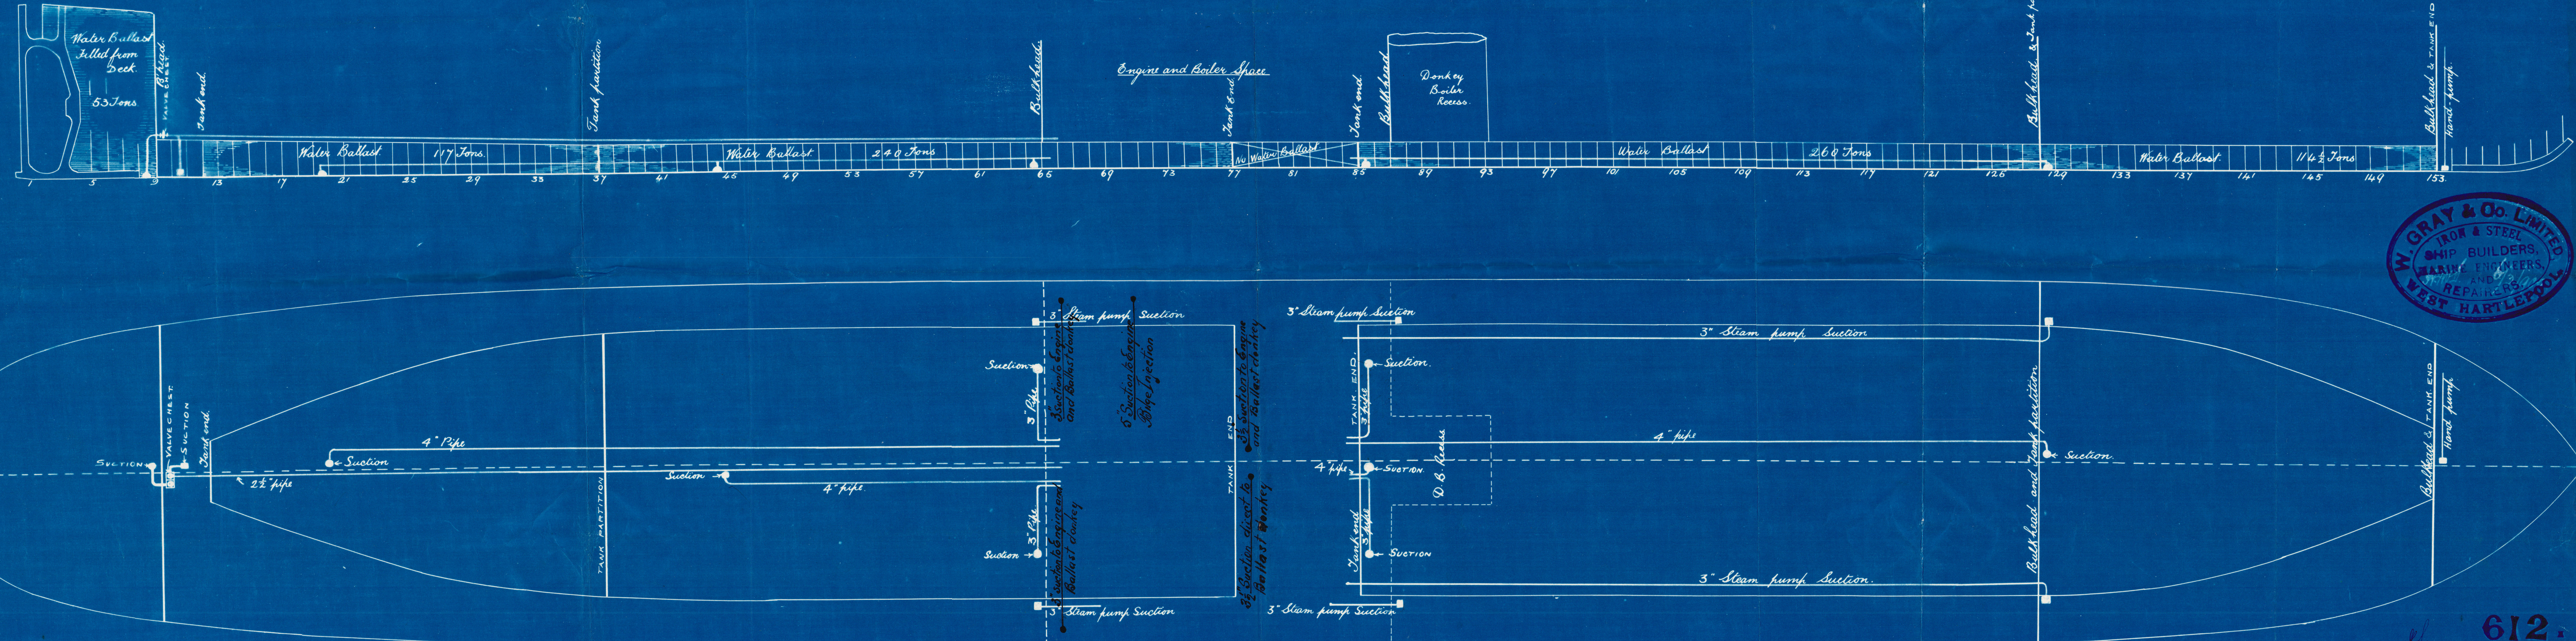

W. GRAY & Co. LIMITED
IRON & STEEL
SHIP BUILDERS,
MARINE ENGINEERS,
AND
REPAIRERS
WEST HARTLEPOOL

612.

612.

See accompanying paper to be fitted.

HP 612-1-0237
Foundation


Wray Co.

No. 52

Pumping Plan.

Yarborough

Hpl. Report No. 11266

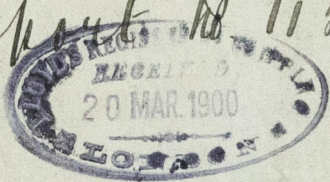

HPL389-0237



© 2020

Lloyd's Register
Foundation