

W Gray Ho.

No. 612

Elections forward
"Yanborough"

Hpl. Report No. 11266

HPL389-0238



© 2019

Lloyd's Register
Foundation


S.S. 612

SECTIONS AT FRAMES 149 & 151

ABFT. COLLISION BULKHEAD

SCALE $\frac{1}{4}" = 1 \text{ FOOT}$

20-1-00

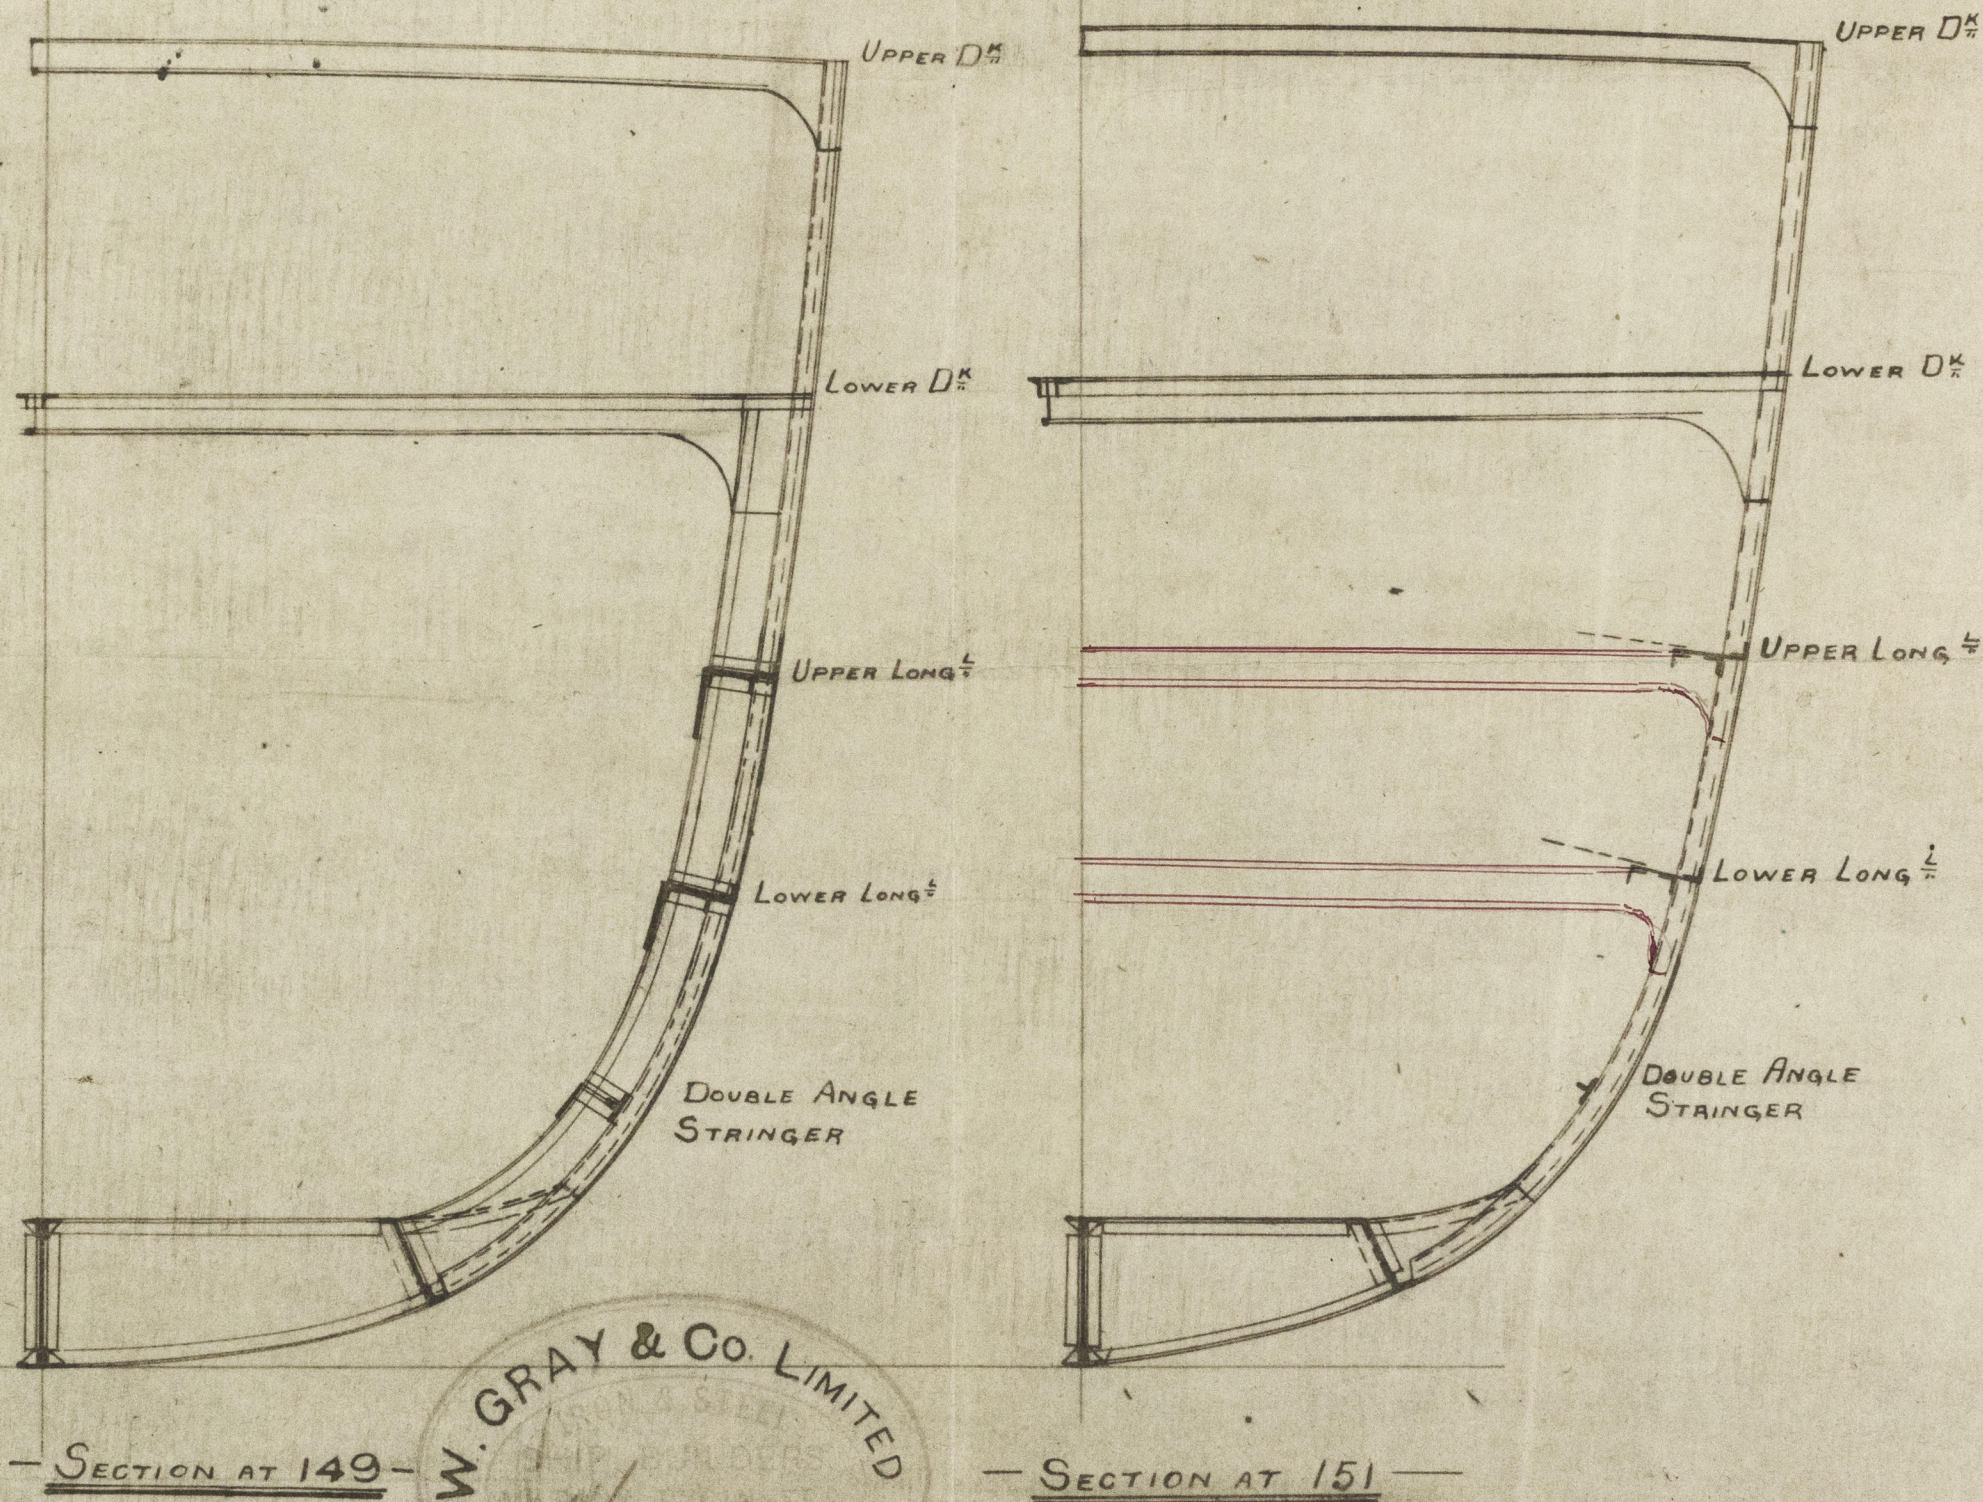

W. GRAY & Co. LIMITED
SHIP BUILDERS
WEST HARTLEPOOL
16/1/1900



© 2019

Lloyd's Register
Foundation

HPL 389-0238