


WORKING PRESS = 160 LBS TO LLOYDS.

SCALE 1" = 1 FT

Shell plates to have an ultimate tensile strength of 27 to 30 tons

Main stays " " " " " " 27 to 32 tons

Other plates & stays " " " " 26 to 30 tons.

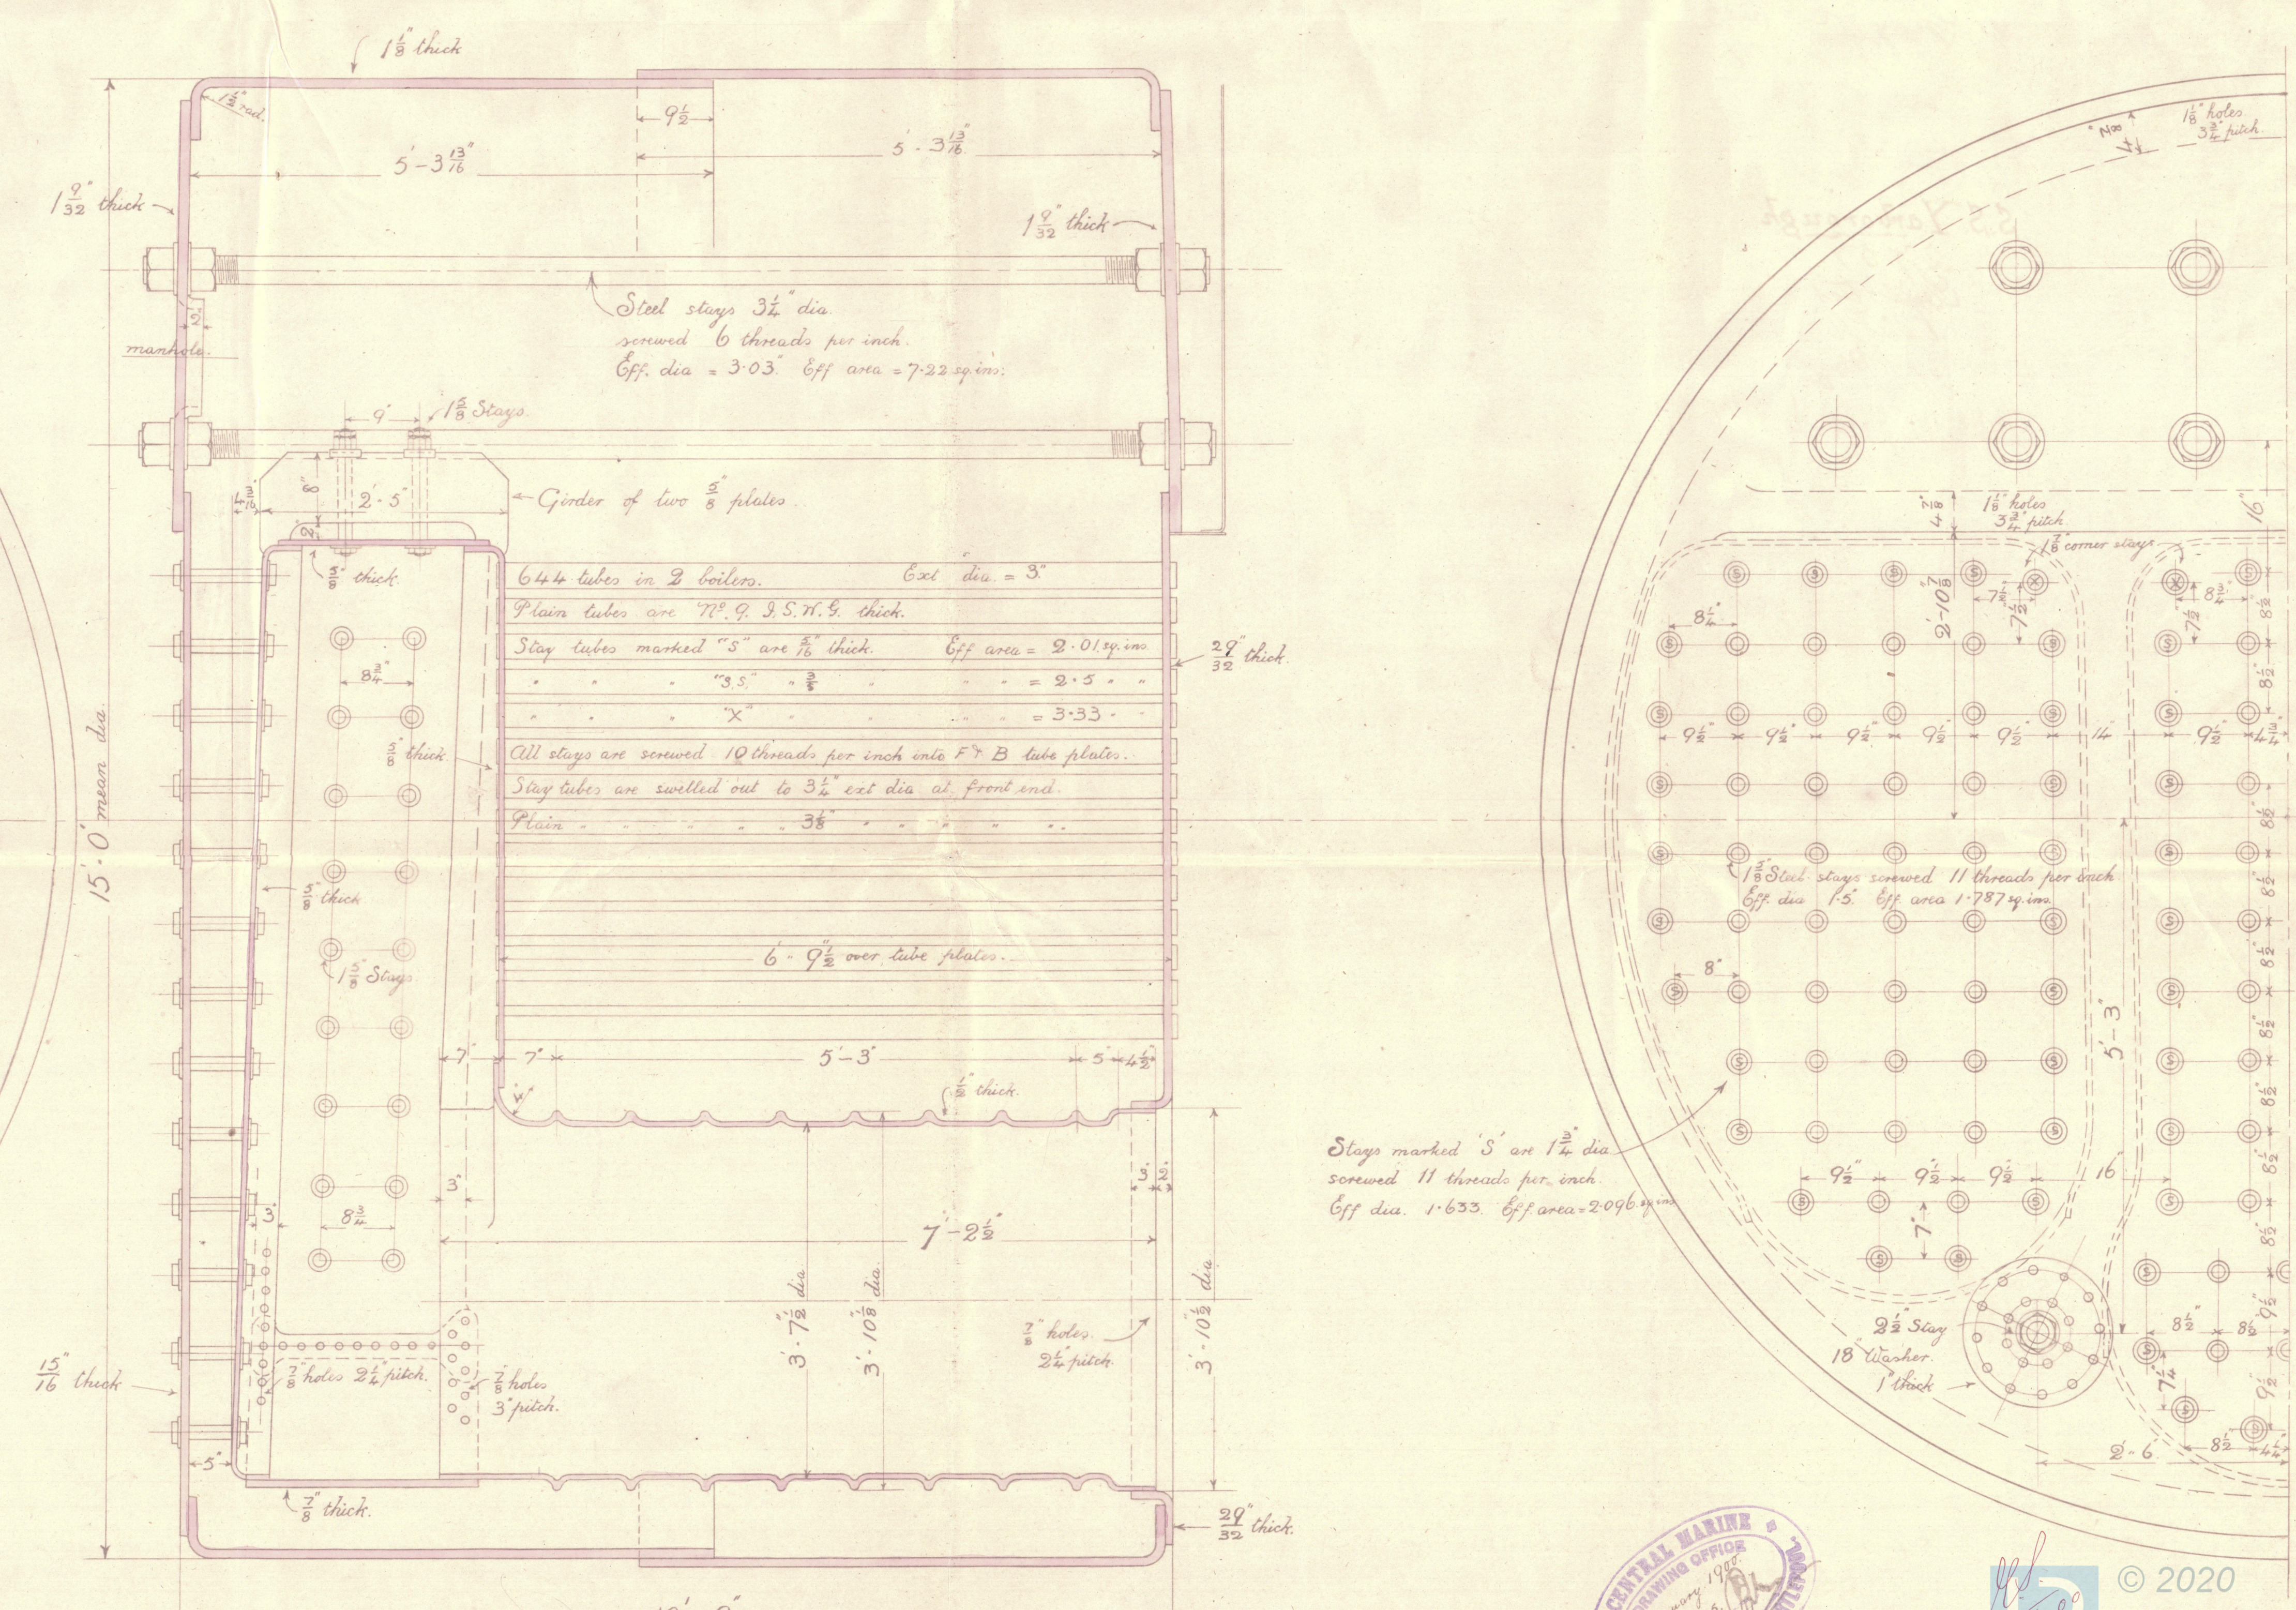

**N<sup>o</sup> 612.**



B. Gray & Co 6/2  
R. P. 160



S.S. "Yarborough"

2751

Lloyd's test

1320 lb

14. 18.00

Hpl. Report No. 11266

HPL389-0240



© 2020

Lloyd's Register  
Foundation