

[illegible]

170 Rec'd 8 Dec 99

Dec 7th/99 *[Signature]*
N^o 249

Furness Withy & Co.
H no 249.



Pumping Plan.

'Marine'

HPL Report No. 11282

AP. 5/1/01
5/1/01

HPL390-0019

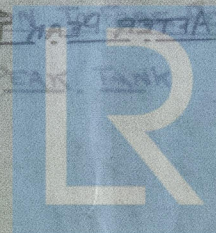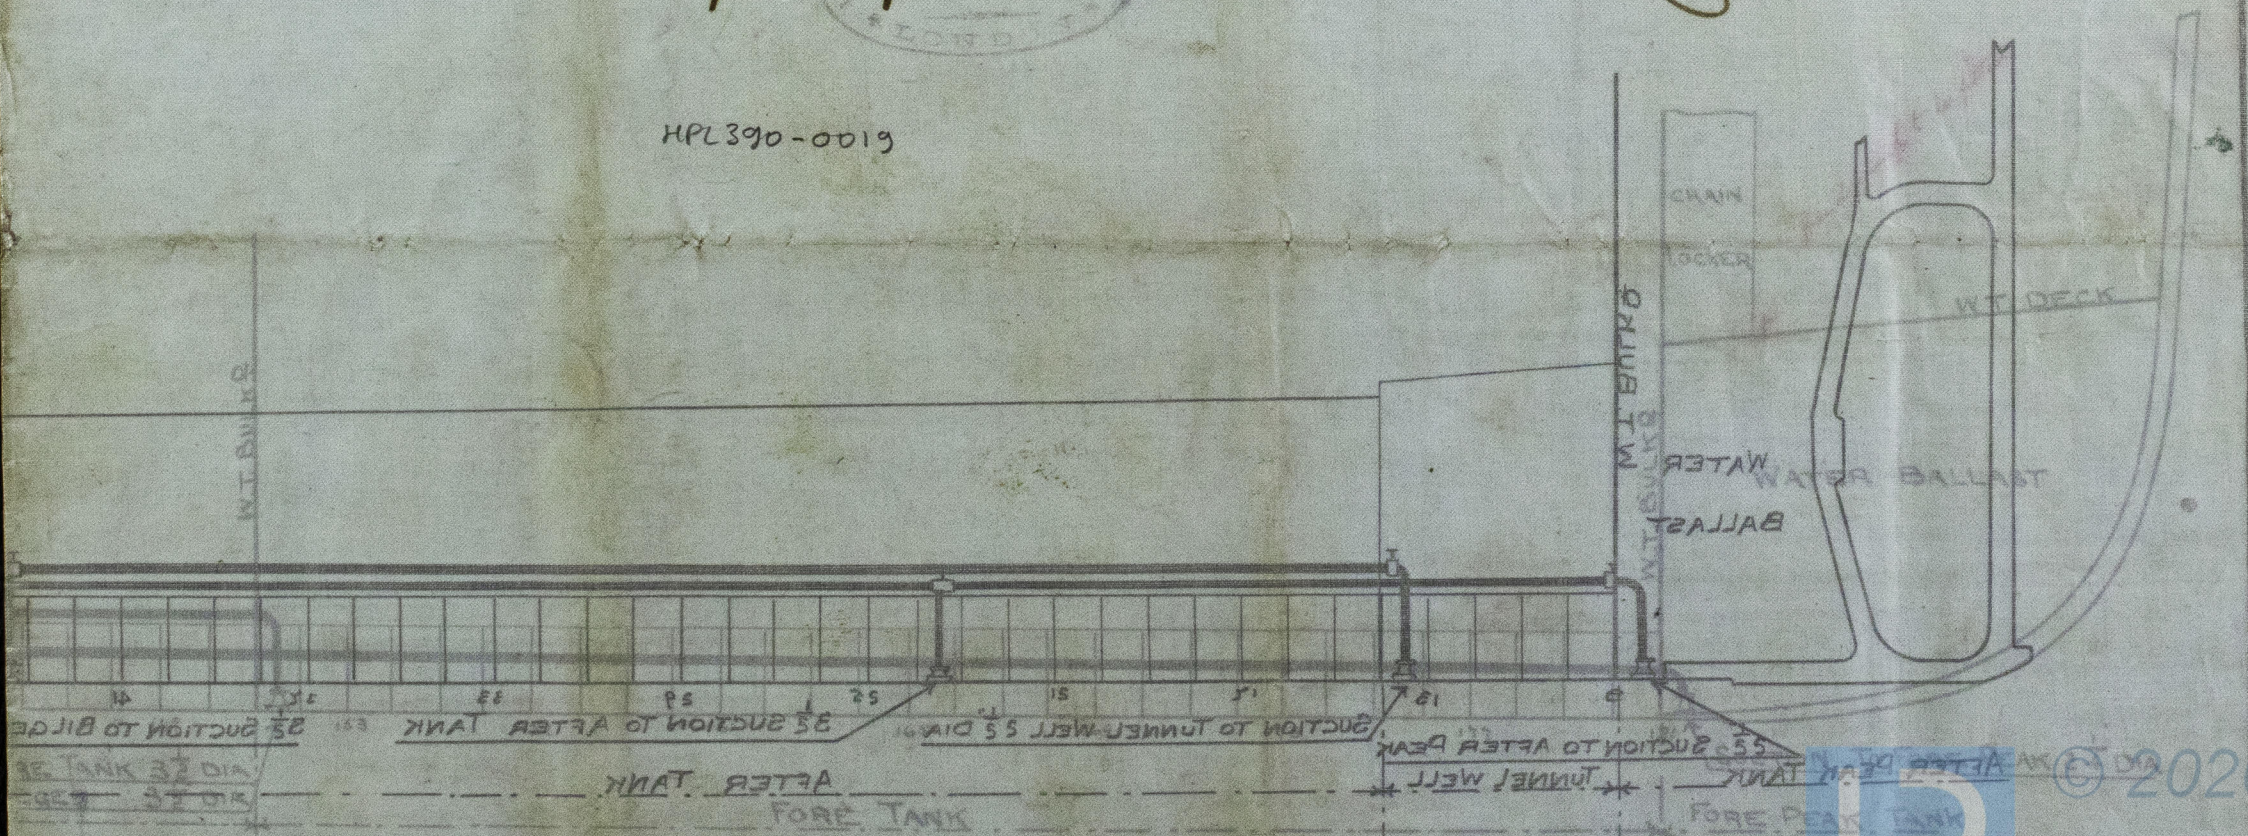

© 2020

Lloyd's Register
Foundation