

C.S. Stern frame

11 Marina 7

Hpl Report No. 11282

HP 390-0021

2107015

1-578

in view of passing




© 2019

Lloyd's Register
Foundation

SCALE $\frac{1}{2}'' = 1 \text{ FOOT.}$



TO PASS LLOYDS SURVEY.

KEEL	-----	$\frac{3}{4}$
D. MOULDED	-----	$32 \frac{1}{2}$
SHEER	-----	$4 \cdot 0$
CROP	-----	5
TOTAL HEIGHT	-----	$36 \frac{1}{4}$

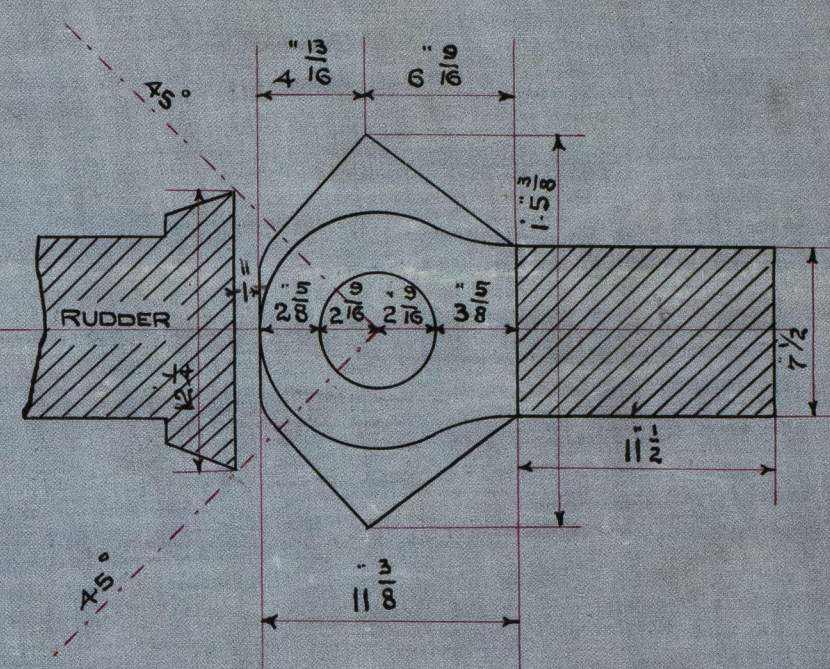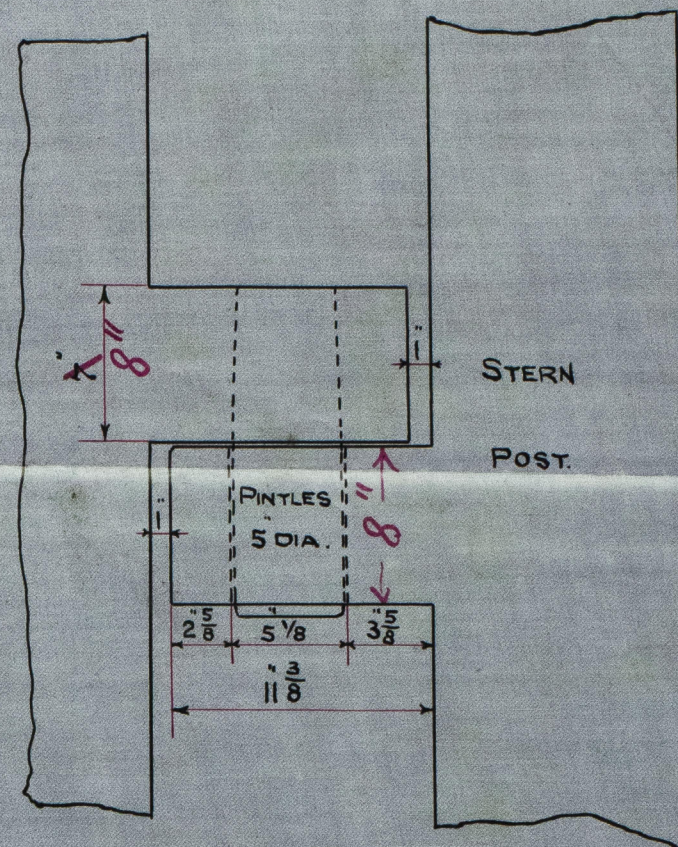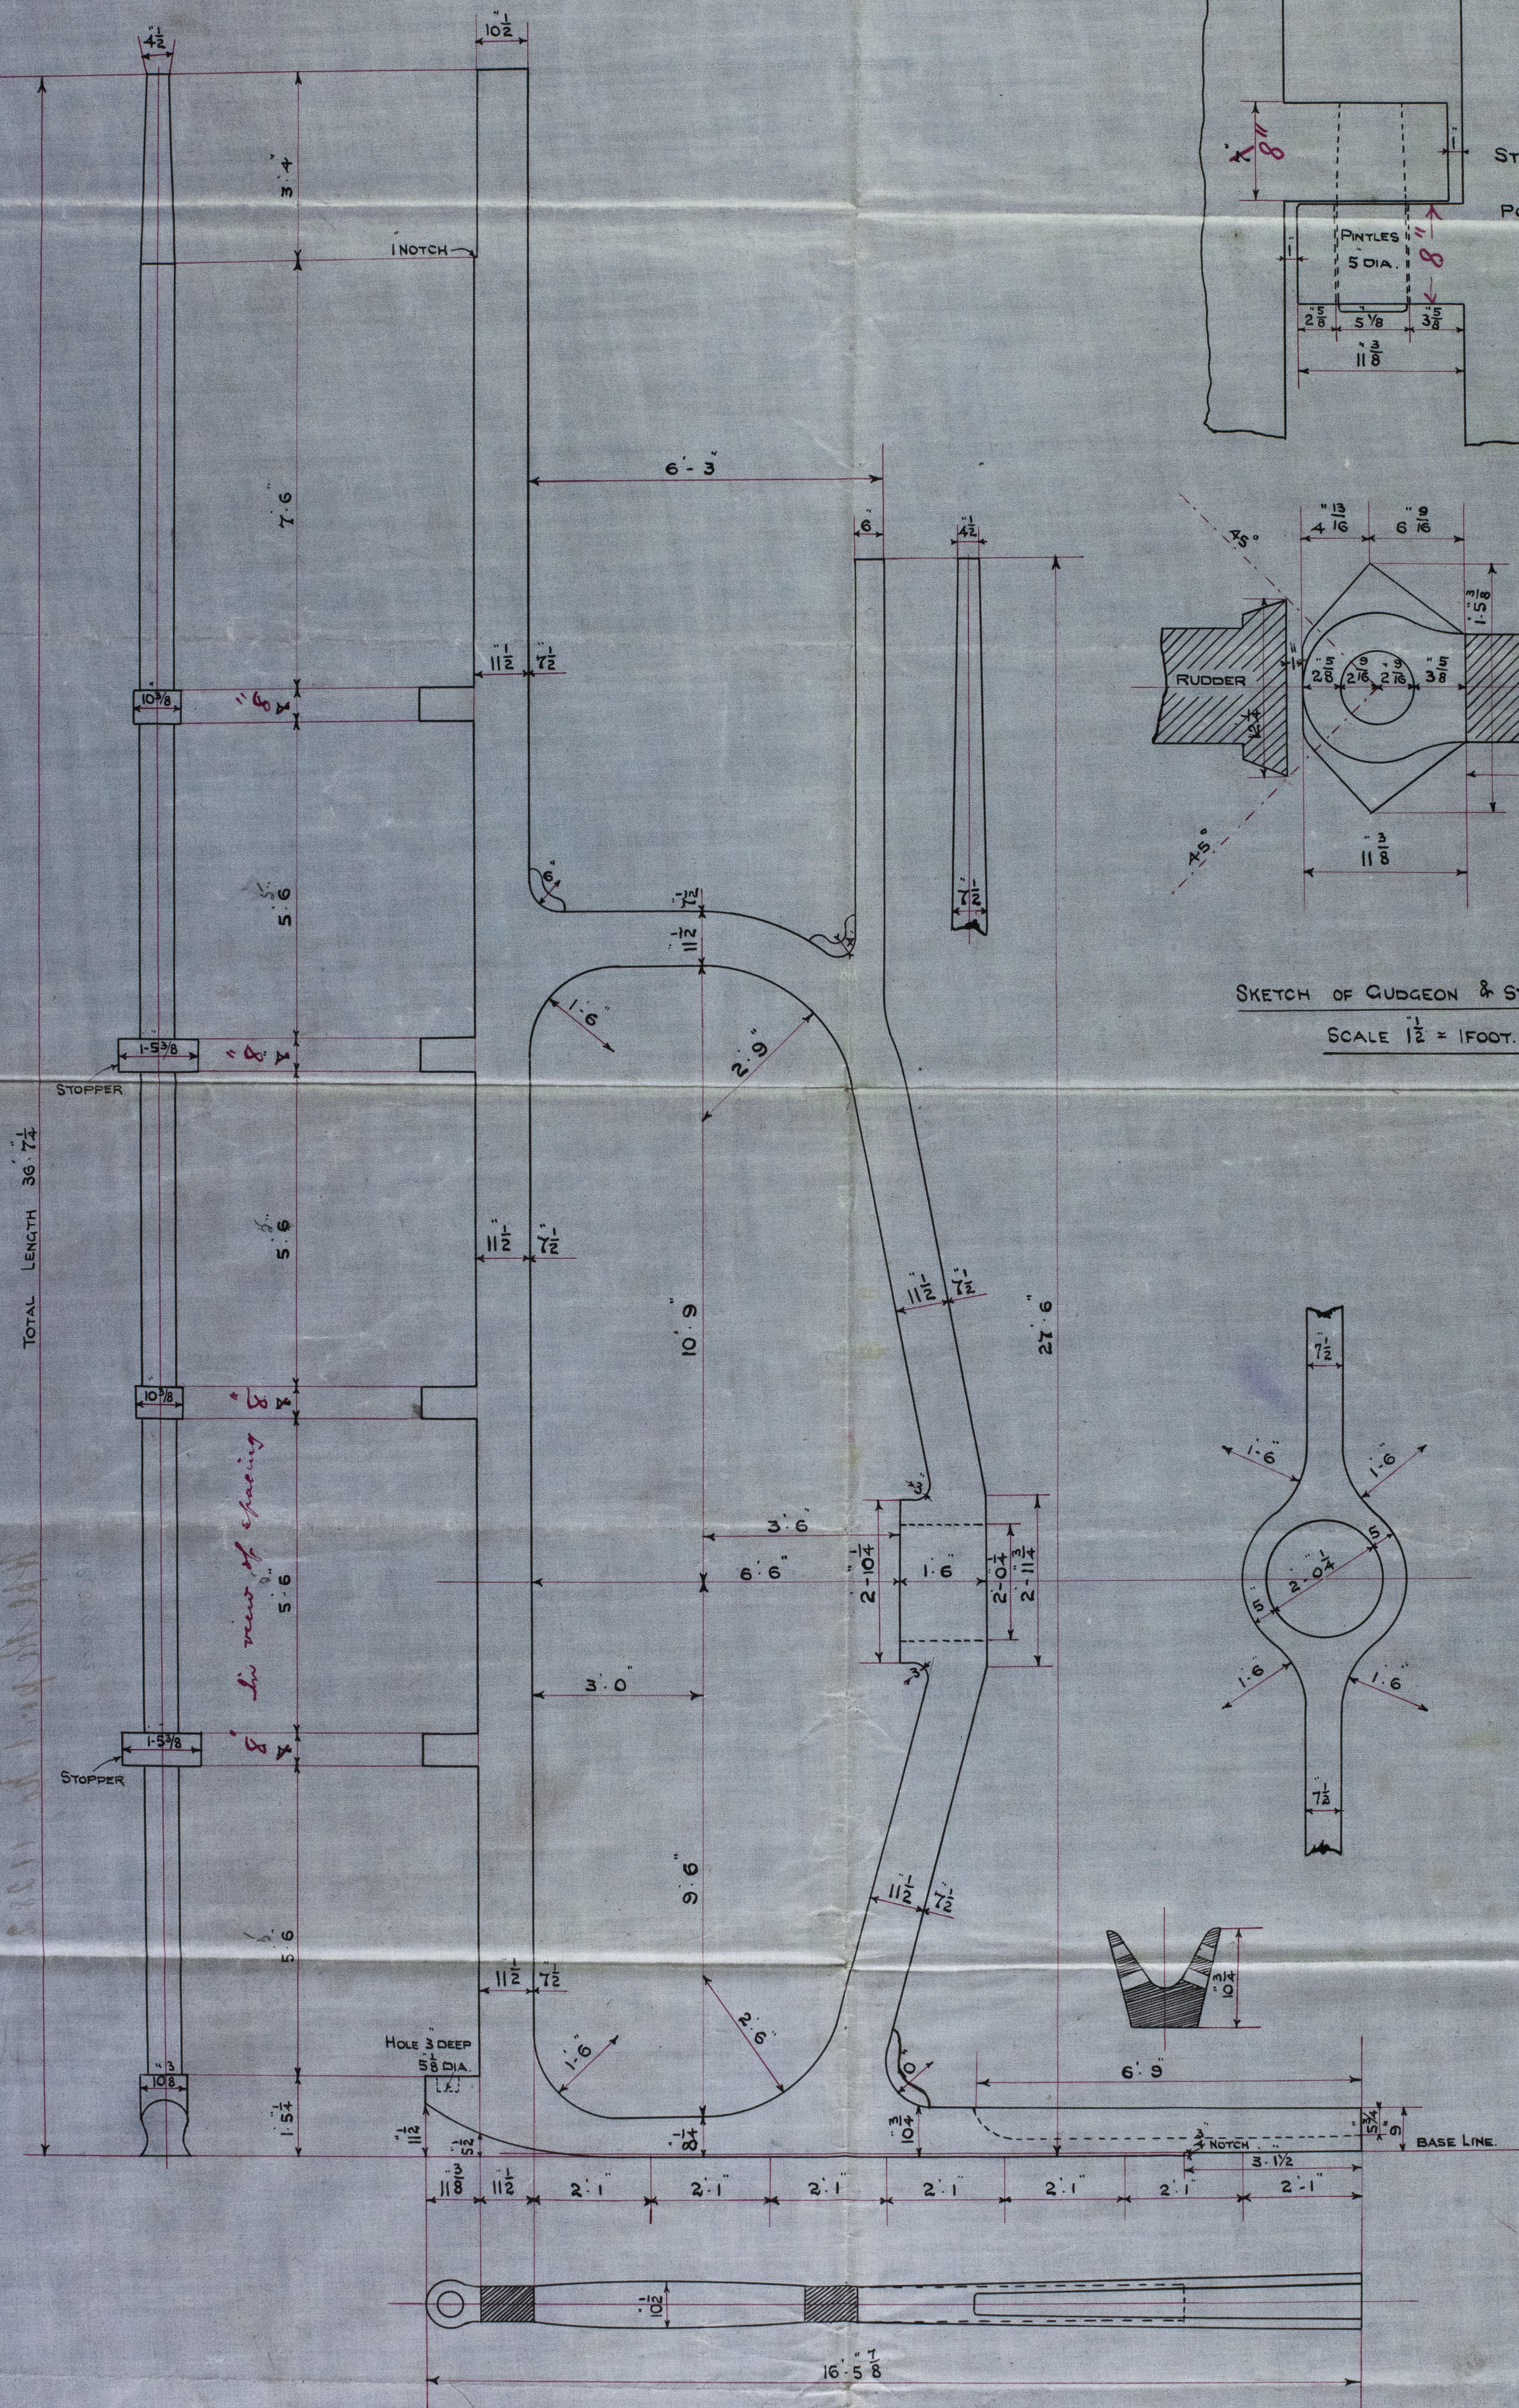

SKETCH OF GUDGEON & STOPPER

SCALE $\frac{1}{2}'' = 1 \text{ FOOT.}$

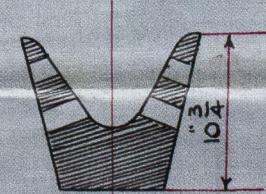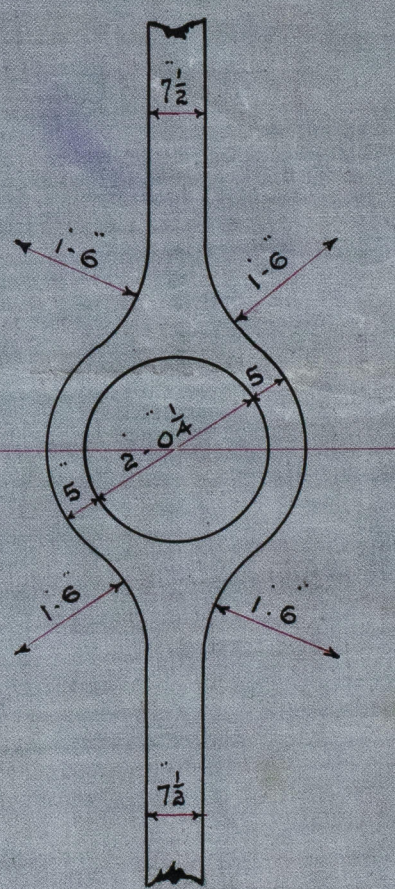

FURNESS, WITBY & Co. LIMITED

WEST HARTLEPOOL

Sept. 8th/99 W. J.

HPL390-002

N^o 249