

Furness. Wilby & Co's Ltd


St. No 249

clia See

St. Marina

Hpl 11282

20.6.1909  
22.8.28

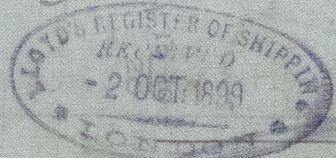

HPL390-0022

No 249

MIDSHIP

400 x 25



STRIK LATE

BEAM ON EVERY FRA

DECK LIFT

3 X 1000 BEAMS IN F









4 RIVETS  
S/S LINES DEPTH OF BEAM  
KNEES 1/80

Lloyd's Register  
Foundation




$$400' - 0'' \times 52' - 0'' \times 32' - 1\frac{1}{2}'' \text{ D.M.}$$

SCALE  $\frac{1}{2}" = 1$  FOOT.

SHADE DECK.

STRINGER PLATE	GO	$\times \frac{10-7}{20}$	10-7-20
"	ANGLE	$3\frac{1}{2} \times 3\frac{1}{2}$	$\times \frac{10-7}{20}$
BEAMS ON EVERY FRAME	7	$\times 3$	$\times \frac{9-2}{20}$ BULB ANGLE ✓
"	AT HATCH ENDS	$9 \times 3$	$\times \frac{10-2}{20}$ ✓
STRONG BEAMS IN ENGINE SPACE	9	$\times 3$	$\times \frac{14-2}{20}$ BULB ANGLE
STEEL DECK	19		

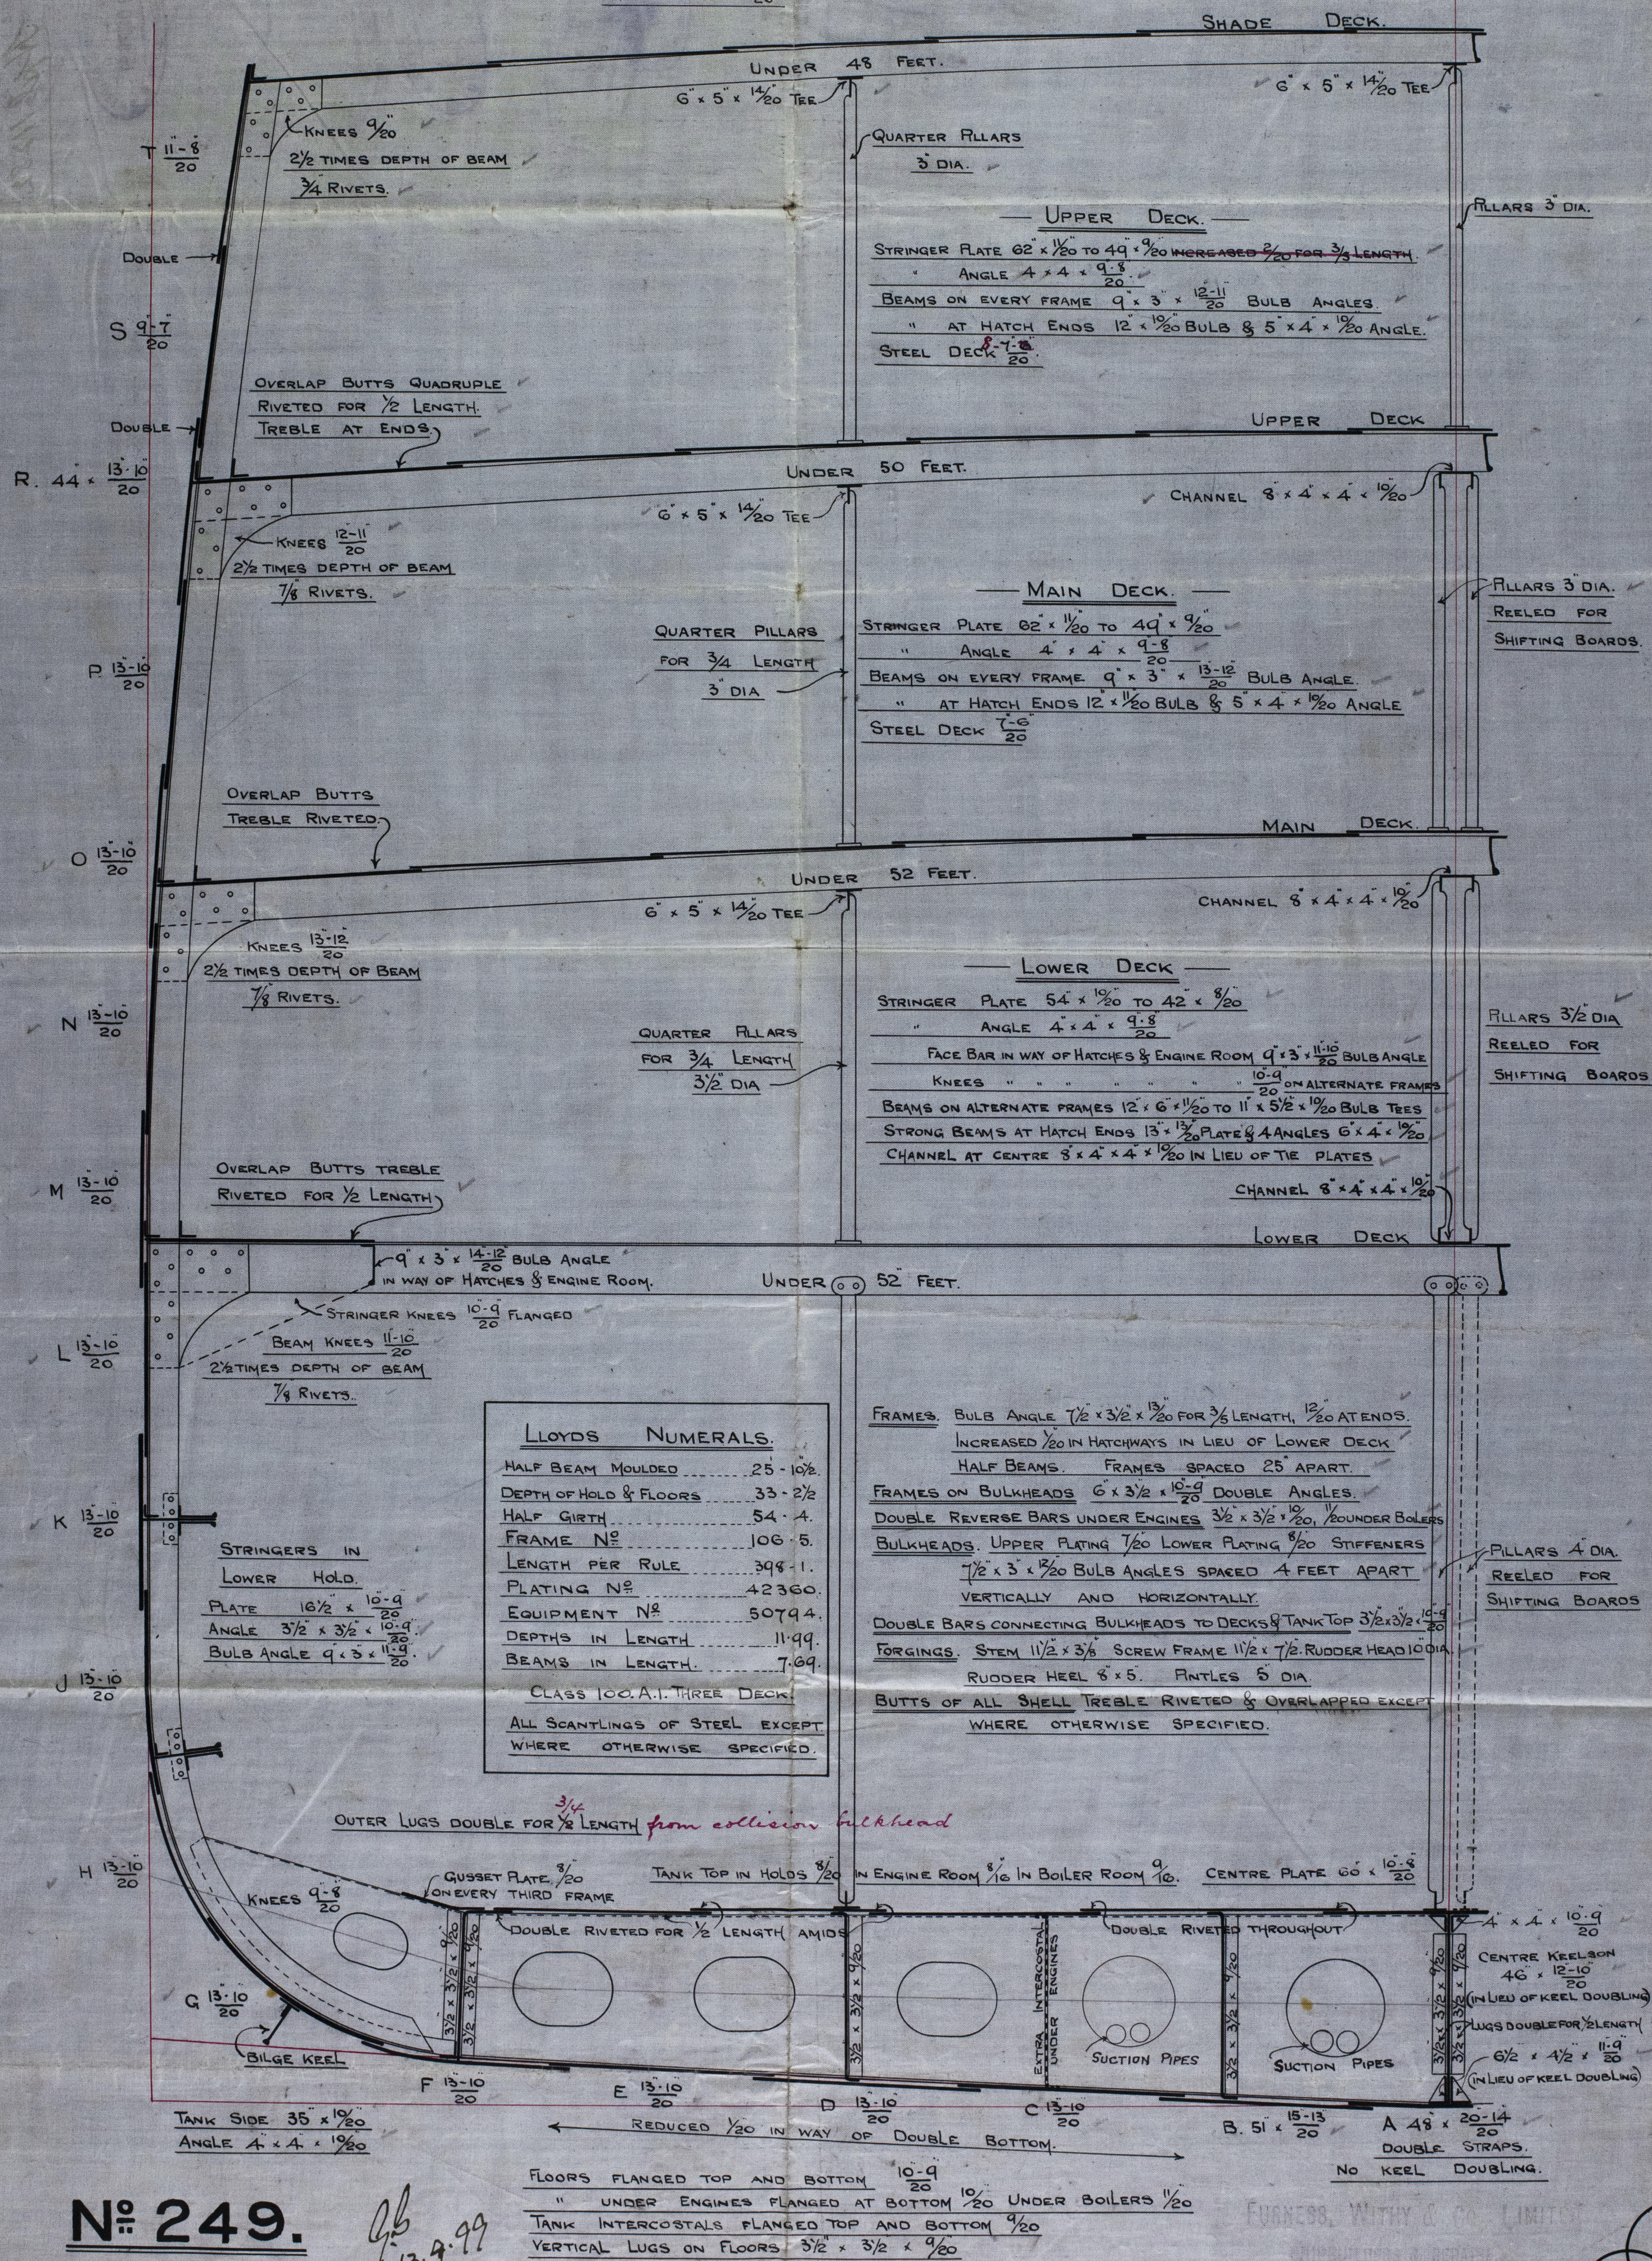

Nº 249.

Sept 8<sup>th</sup> /99 N.Y.

HPL390-0022