


— SCALE $\frac{1}{8}'' = \text{ONE FOOT}$ —

— DIMENSIONS 400' x 52' x 32' 1½ D.M. —

 

№ 249

№ 249

WEST HARTLEPOOL

Sept 9^m 1999 U.J.


Lloyd's

Furness Withy & Co Ltd
S. P. No 249.

Profile
"Marina"

Hpl. Report No. 11282

HPL390-0023

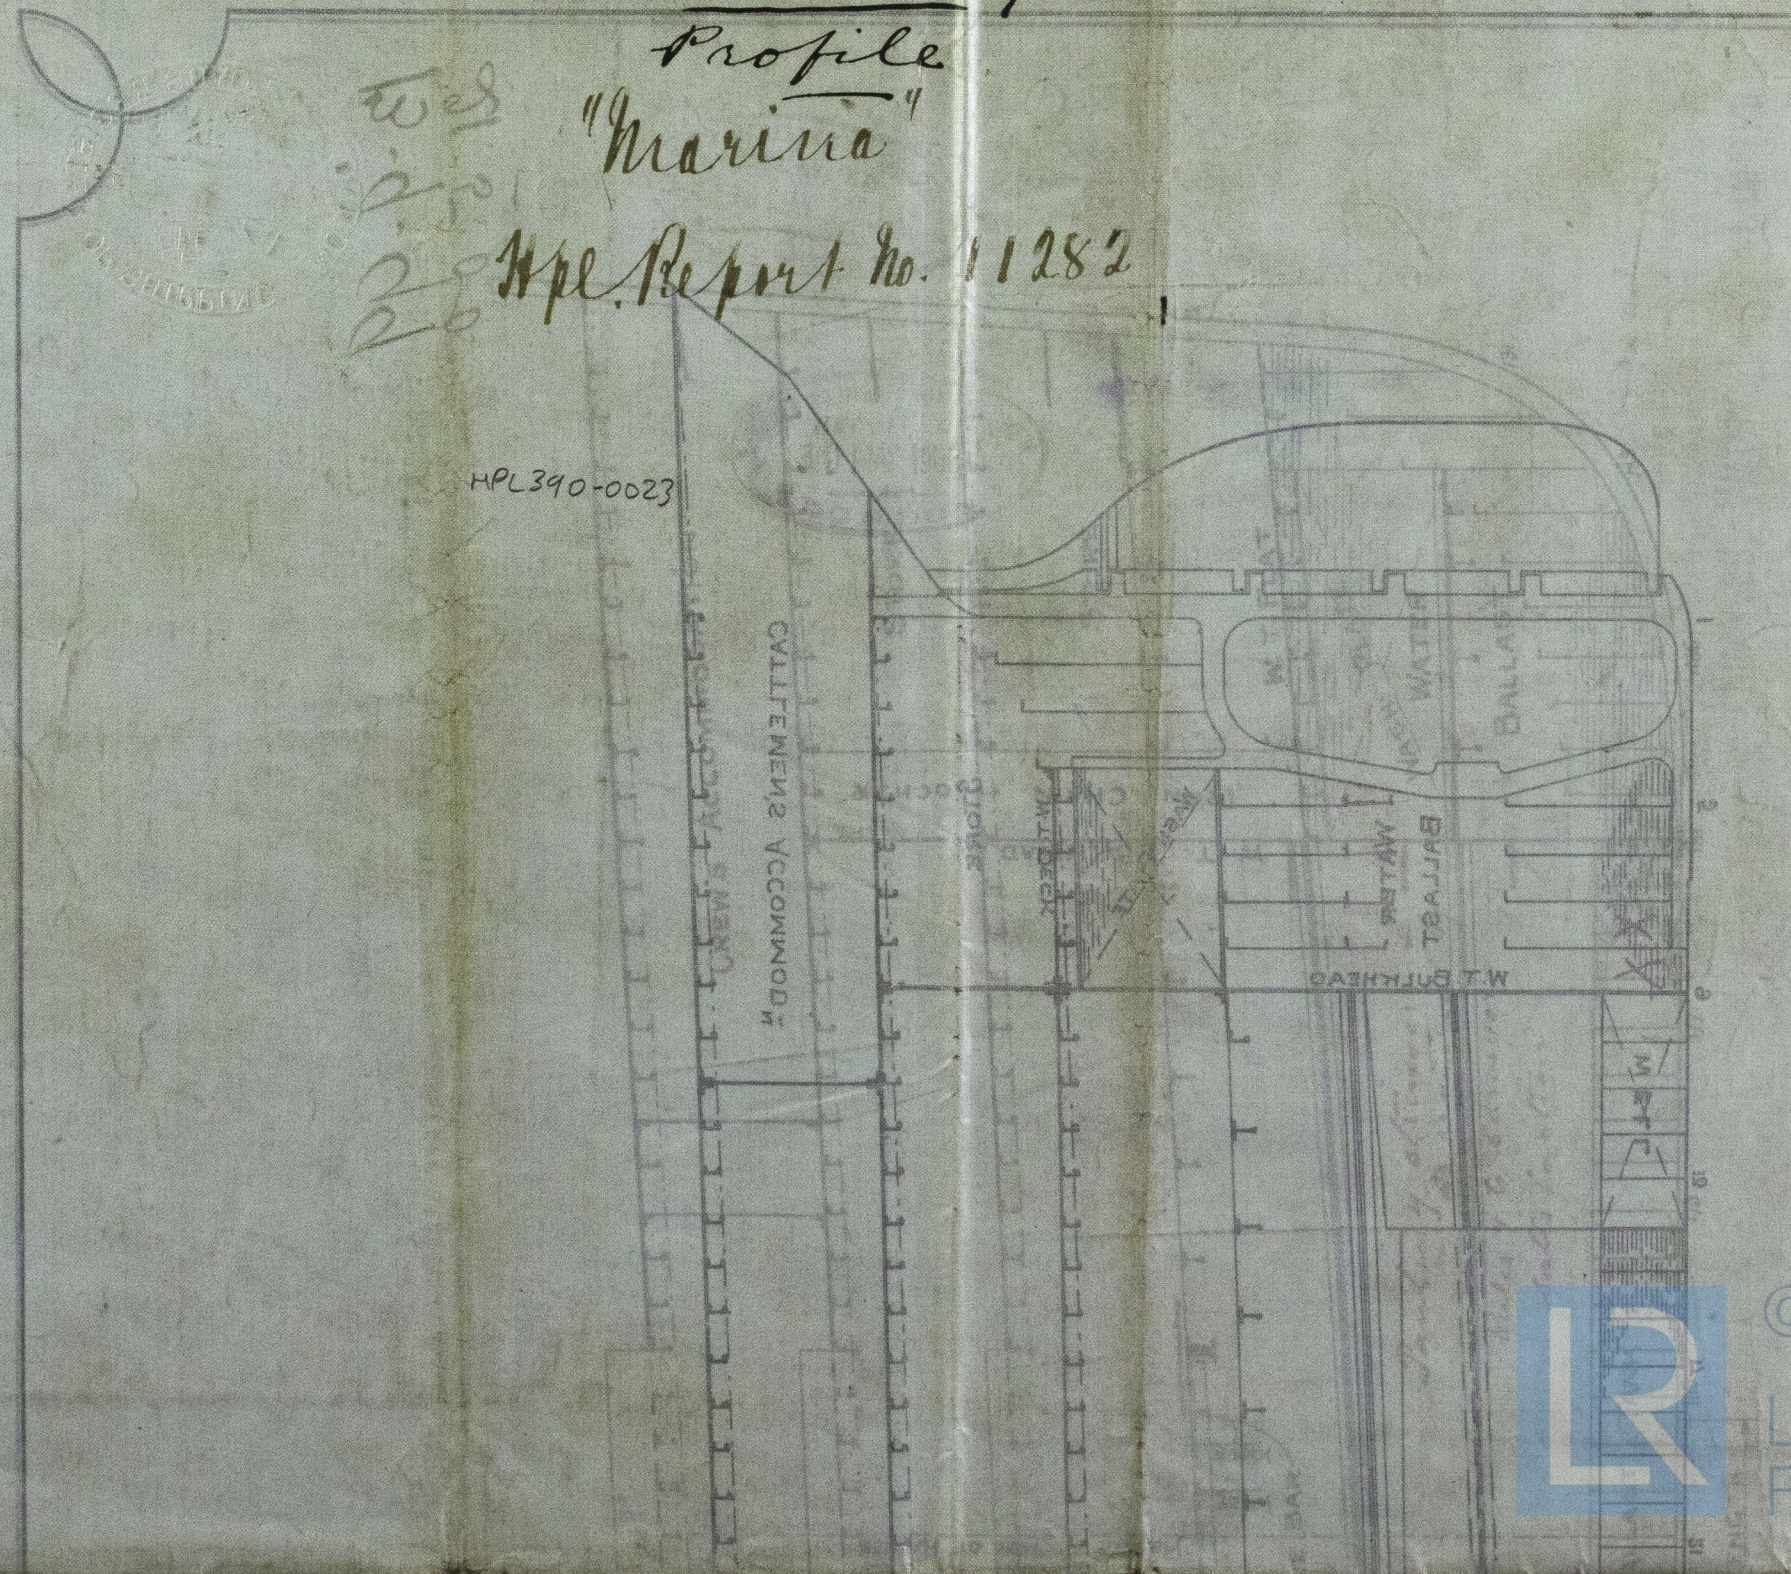

-No 549278N-



© 2020

Lloyd's Register
Foundation