

Received at **WEST HARTLEPOOL**, 24.4.00.

Lloyd's Register of British and Foreign Shipping.

Wpool

(Report on Vessel No. *11285* Port **WEST HARTLEPOOL**.)

Roijstan

No. *4216a*

SHIP FORGINGS OR CASTINGS.

The words FORGINGS or CASTINGS, IRON or STEEL, should be struck out as may be required.

I have to report that the undermentioned Iron ~~or Steel~~ Forgings ~~or Castings~~,
 manufactured by *Imper & Gray Co.*
 of *Warrlepool* for the Vessel No. *613*, being built
 by *Imper & Gray Co.* of *Warrlepool*
 have been inspected by me as set forth below, and found to be, so far as can be seen,
sound.

Mark on Forgings.

Lloyd's
 No. *4216a*
106

W. J. H. Carnison


Sunderland
23/4/00

	STERN FRAME.	RUDDER FRAME.	STEM.
Material*	<i>Scrap</i>	<i>Scrap</i>	<i>Scrap</i>
How made	<i>Forged</i>	<i>Forged & Built</i>	<i>Forged</i>
Dimensions	<i>11 x 6"</i>	<i>9" - 4 1/2" - 6 3/4" Dia at heel</i>	<i>10 1/2" x 2 3/4"</i>
Progress on Inspection	<i>Forged Smithed</i>	<i>Forged Machined</i>	<i>Forged</i>
Date when Inspected	<i>Dec 1st to 21/99</i>	<i>Jan'y 9th to April 10/1900</i>	<i>Dec 1/99</i>

SKETCHES OF FRAMES SHOWING POSITION AND DESCRIPTION OF WELDS OF FORGINGS, OR PARTICULARS OF TESTS APPLIED TO CASTINGS.



Welds

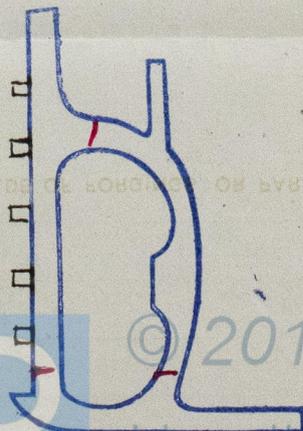

Fee (if any chargeable) £ : :

To be paid at

* If of Iron, state whether scrap or puddled Iron.

