
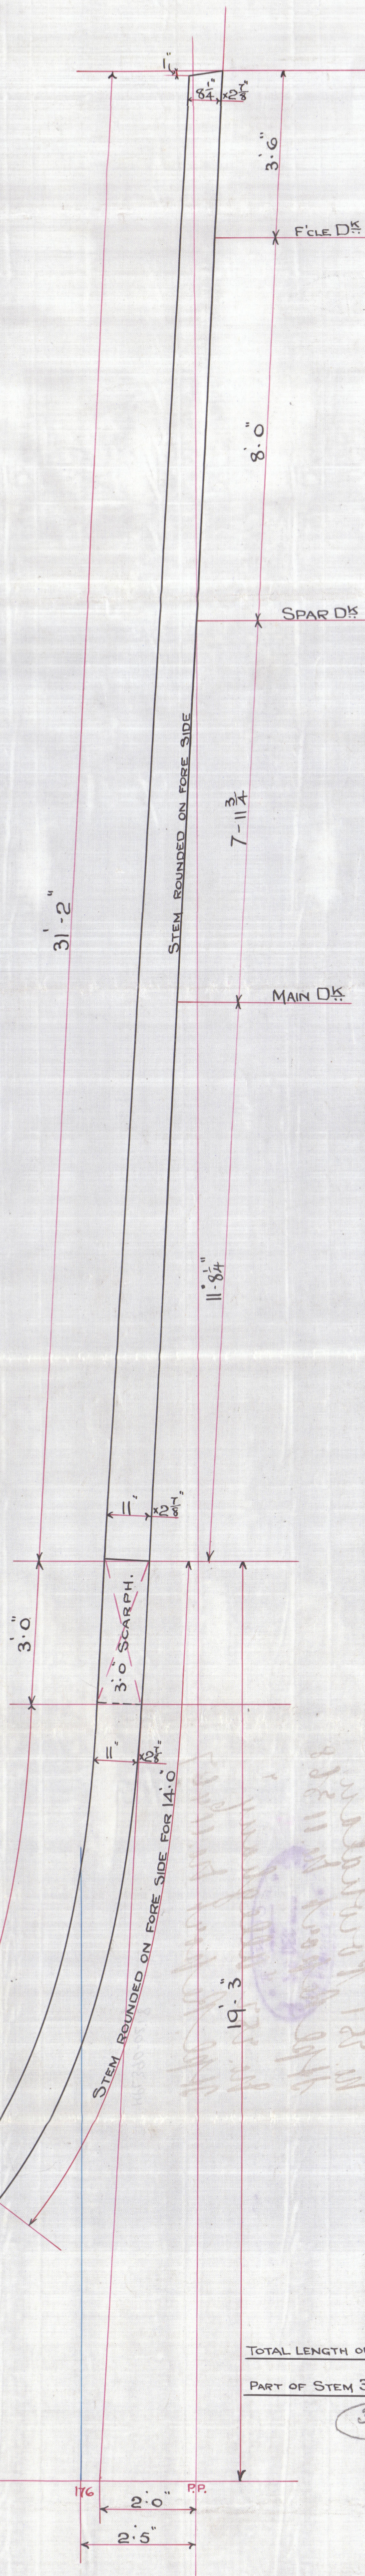
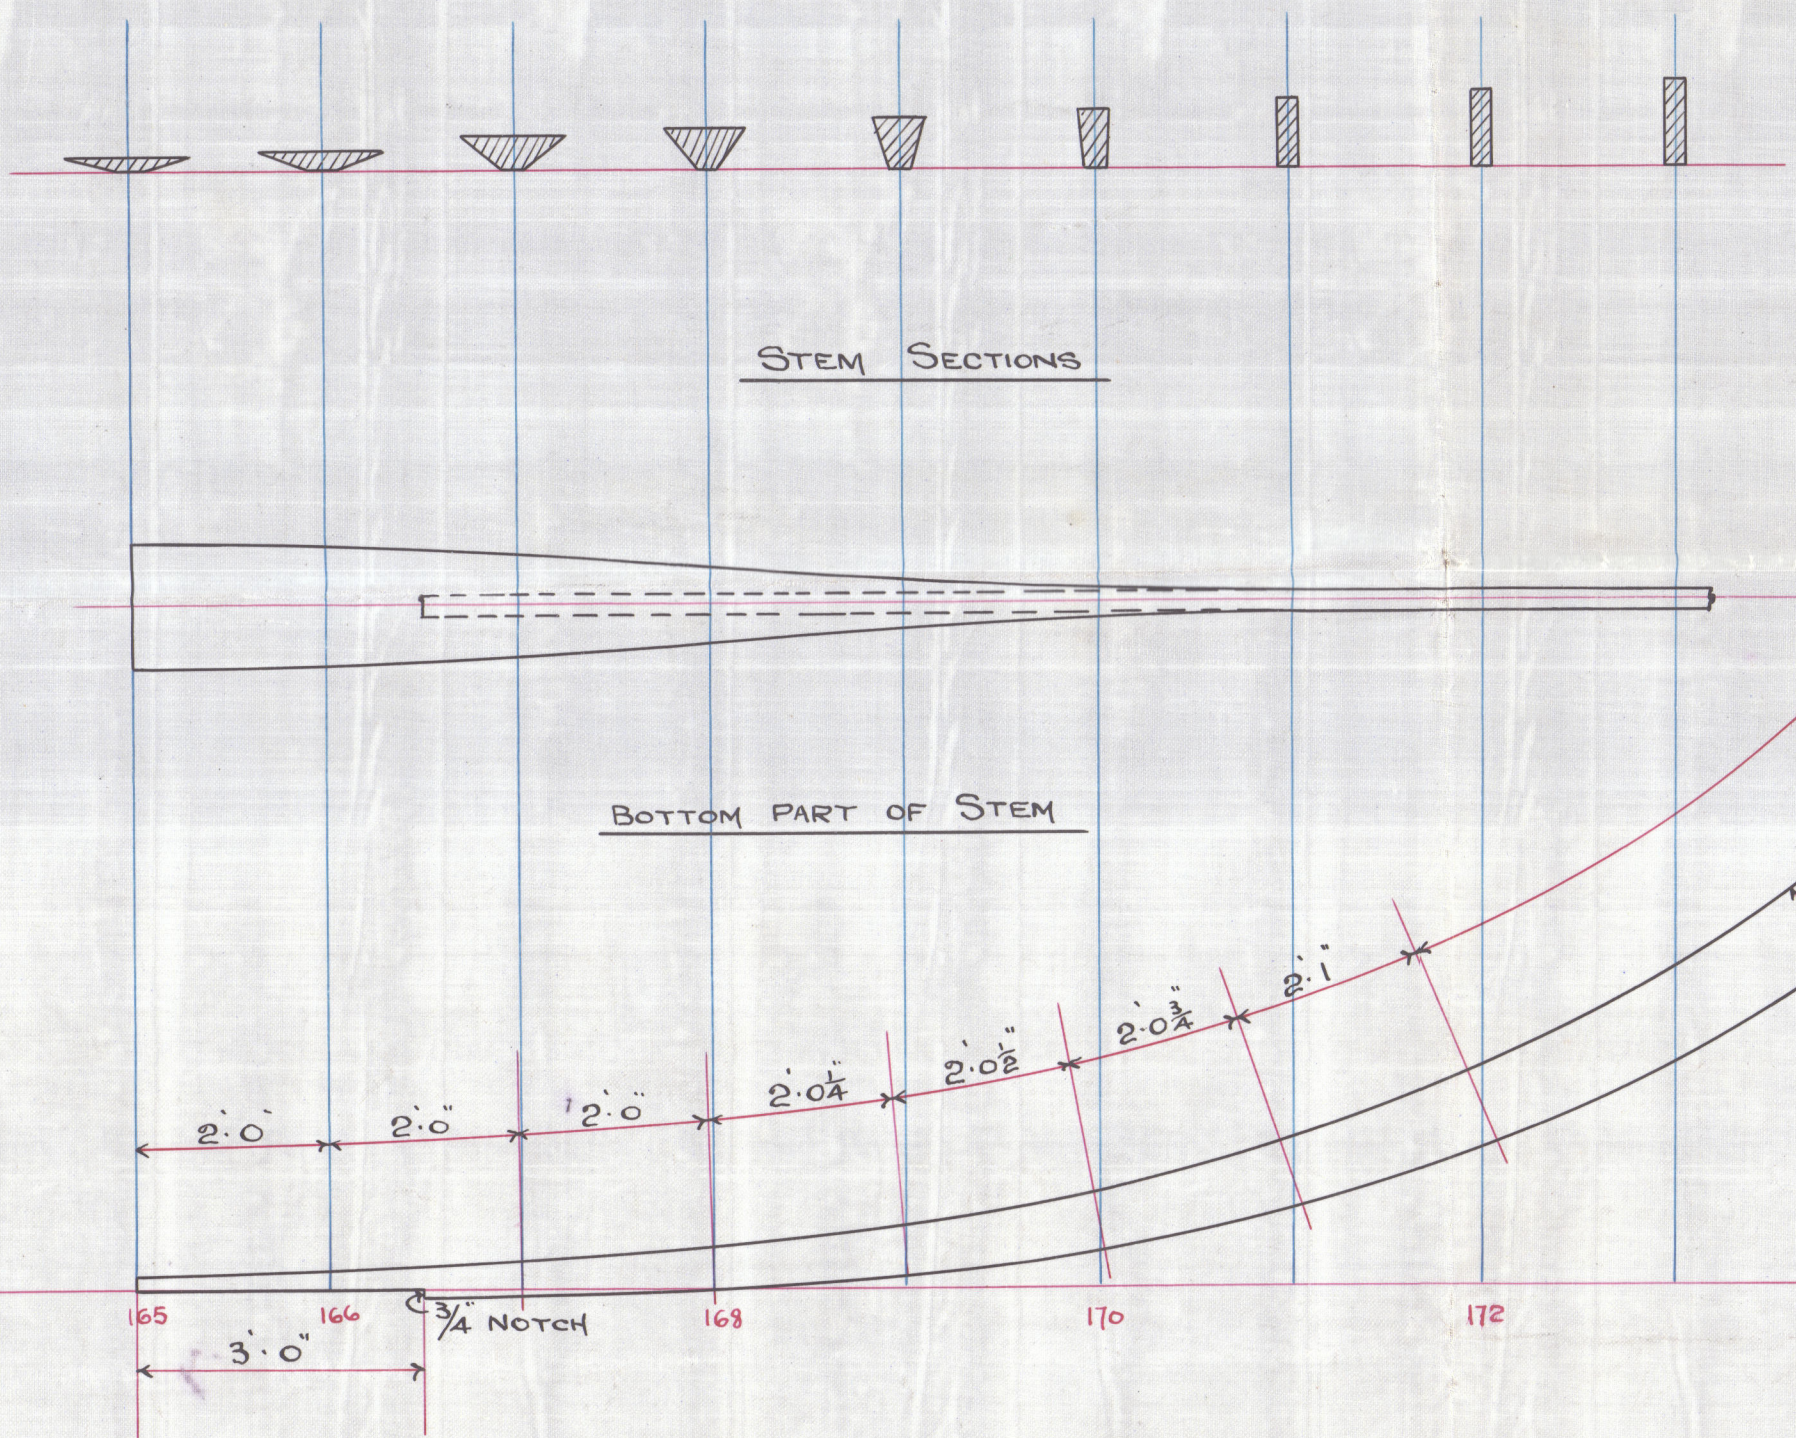


30.12.99

Cast Steel STEM BAR.

SCALE $\frac{1}{2}'' = 1 \text{ FOOT.}$

TO PASS LLOYDS SURVEY.

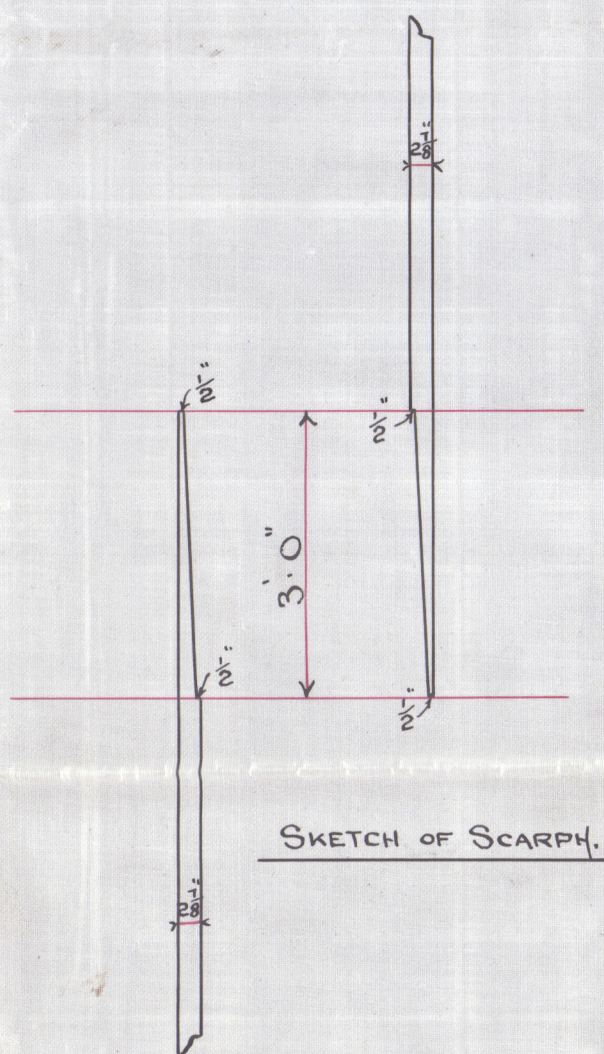


TOTAL LENGTH OF LOWER
PART OF STEM 32'4"

35-4

FURNESS, WITBY & CO. LIMITED.
SHIPBUILDERS & REPAIRERS,
WEST HARTLEPOOL.

Dec 20th 1999 O.J.

N^o 251 & 2.

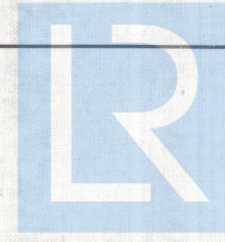

© 2020
Lloyd's Register
Foundation

MPL390-0218

Ar. n^o 251 & 252

Castell Chem

no. 251 Powhatan
Hpl Report no. 11368

No. 252 "Alleghany"
Hpl. Report No. 11467

HPL390-0218

4PL390-0218






© 2020

Lloyd's Register
Foundation