


13-12-99  
4-1-00

# PROFILE.

SCALE  $\frac{1}{8}$ " = 1 FOOT.

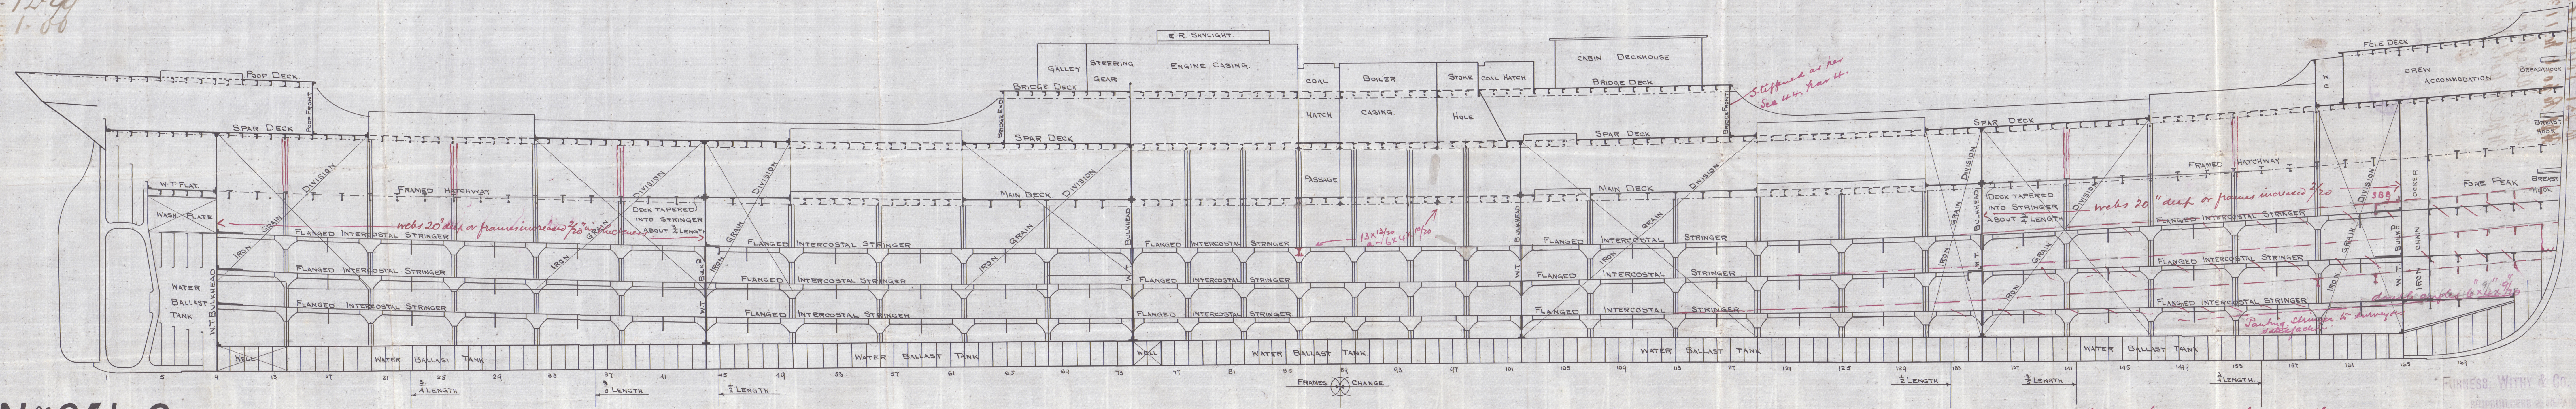

N<sup>os</sup> 251 & 2.

Bottom forward to be strengthened  
as per Circular No 1012.

44/1  
13/12/99

FURNESS, WITBY & CO. LIMITED.  
SHIPBUILDERS & REPAIRERS  
WEST HART  
Dec 5th/99 41.9



Furness Withy & Co

No nos 257 & 252

Profile

No. 251 "Powhatan"


Hpl. Report no. 11368

No. 252 "Alleghany"

Hpl. Report no. 11467

HPL390-0219

YCCGWN000YLLIOH  
GBEM

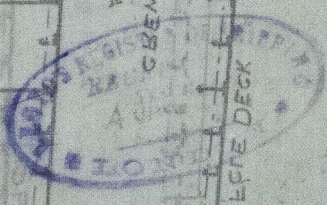

© 2020

Lloyd's Register  
Foundation

