
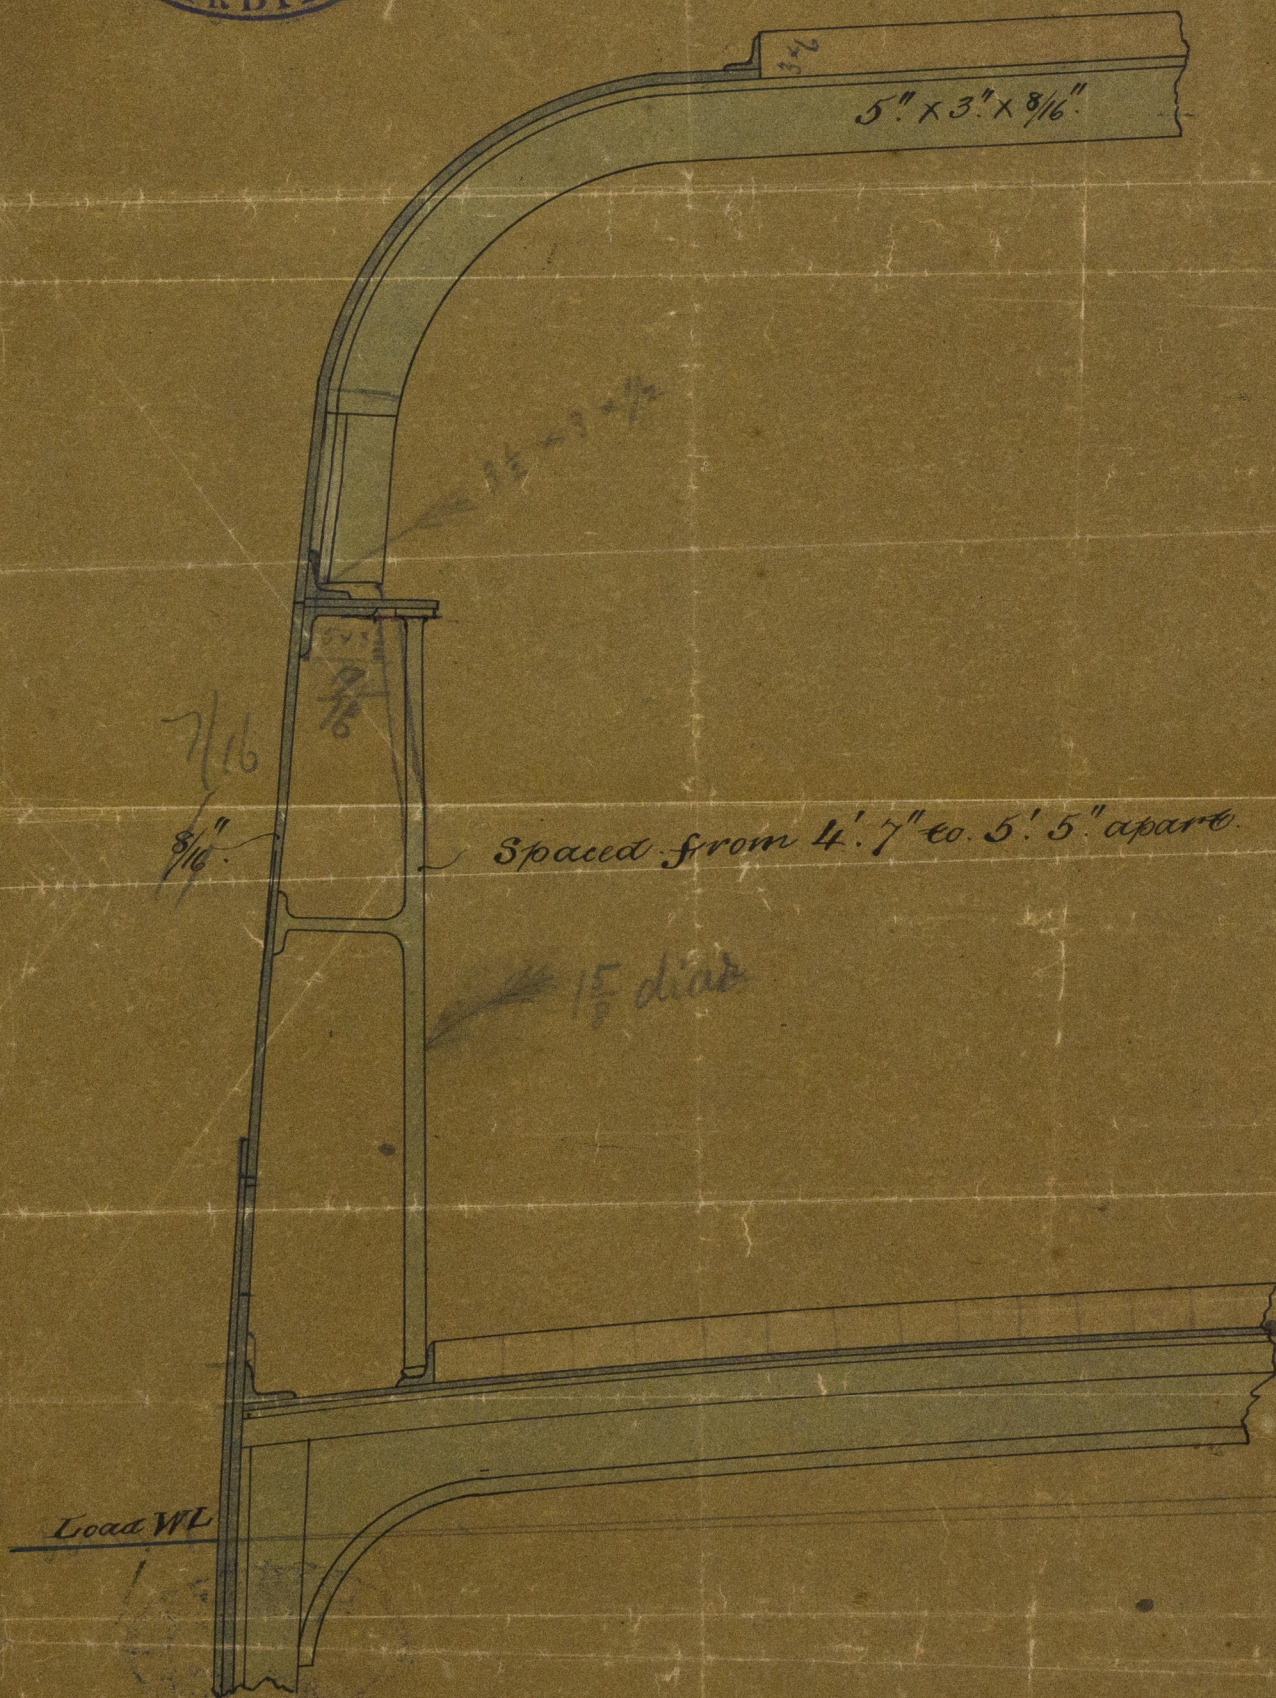


# SS "Tyne Queen."

Scale. 1 in. = 1 foot.

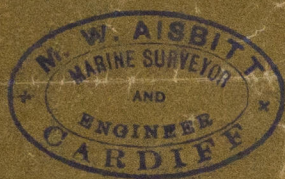

© 2021

Lloyd's Register  
FHP 31/12/81.  
Foundation

HUL395-0833