
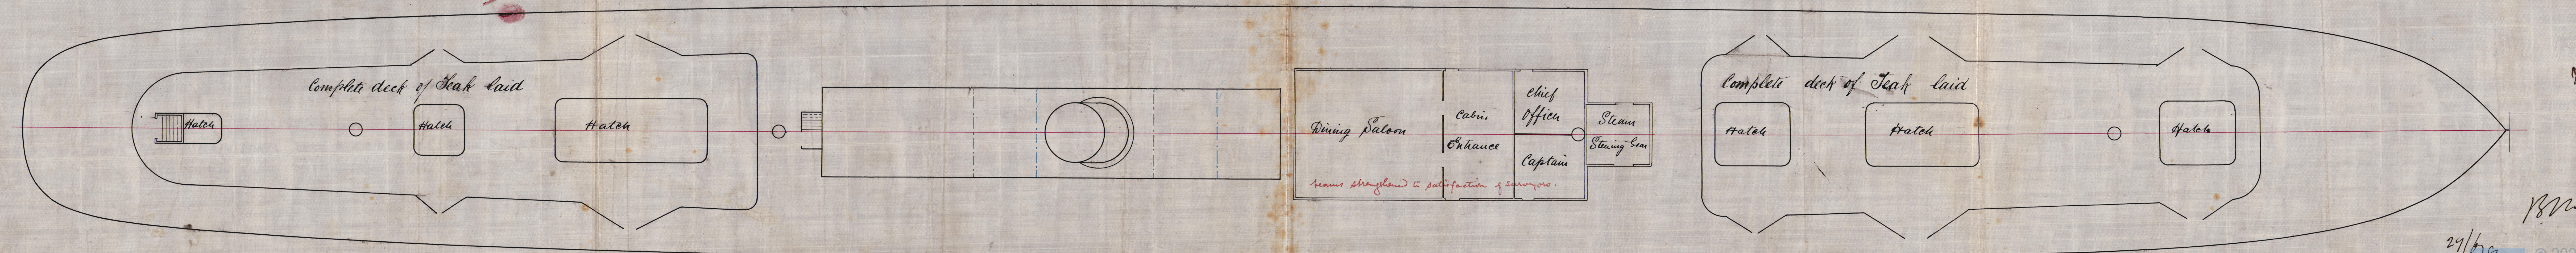


H.M.S. "Grecian Monarch" Hull Report No: 5182.
 No 241

Note
 Web Frames are shown in Burnt Sienna
 Reverse frames left off in way of Web frames

Outline Profile Showing Arrangement of
 Web Frames. Waterlight B. Has & Panting beams &c
 Scale 1/8" = one foot

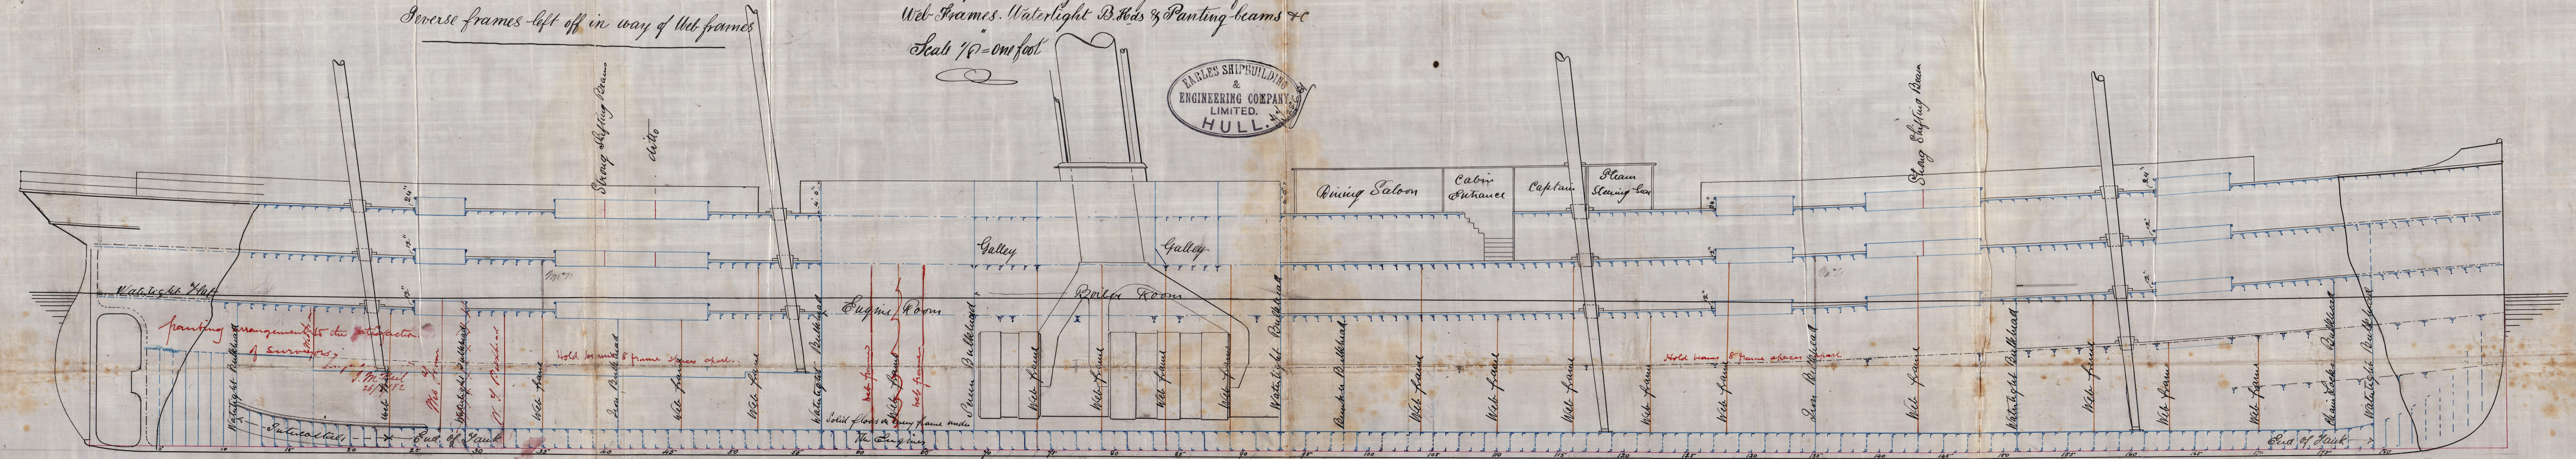

25/6/87

1802

29/6/87

Hull 395-0049