


Rudder S.S. "Grecian Monarch"

Scale 1 in = 1 foot

Hull 5782

HUL895-0050

Shape of
original web

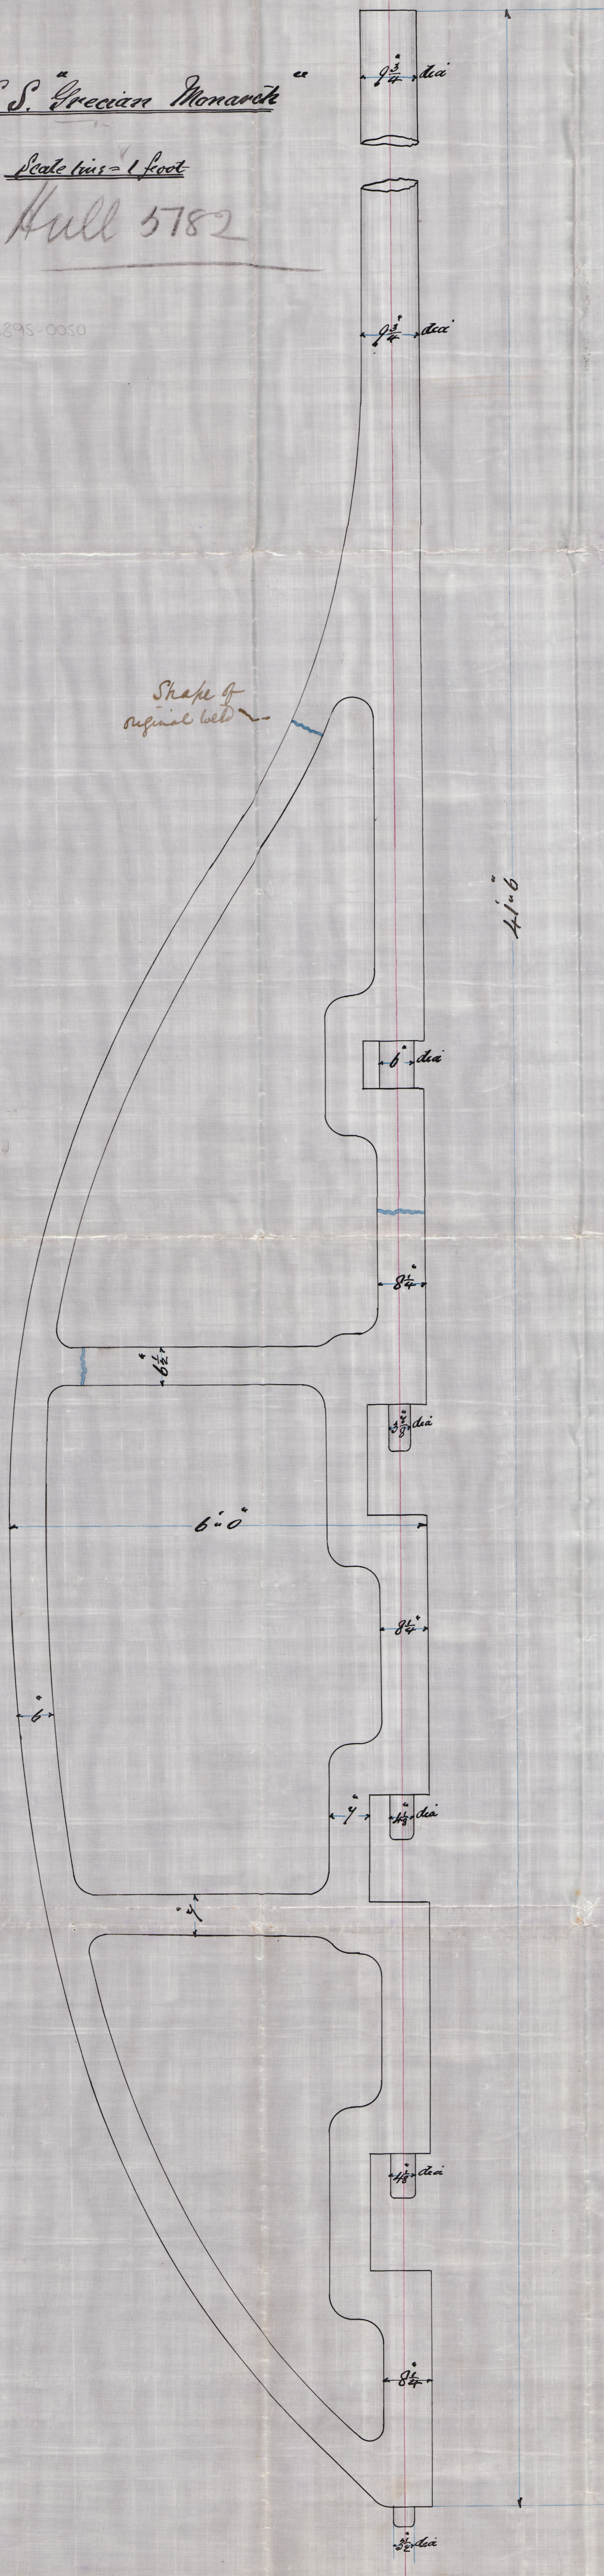

17154
28754



© 2021
Lloyd's Register
Foundation

HUL895-0050 BR 2011

HUL895-0050

46171
46782



© 2021

Lloyd's Register
Foundation

HOL 395-0050