
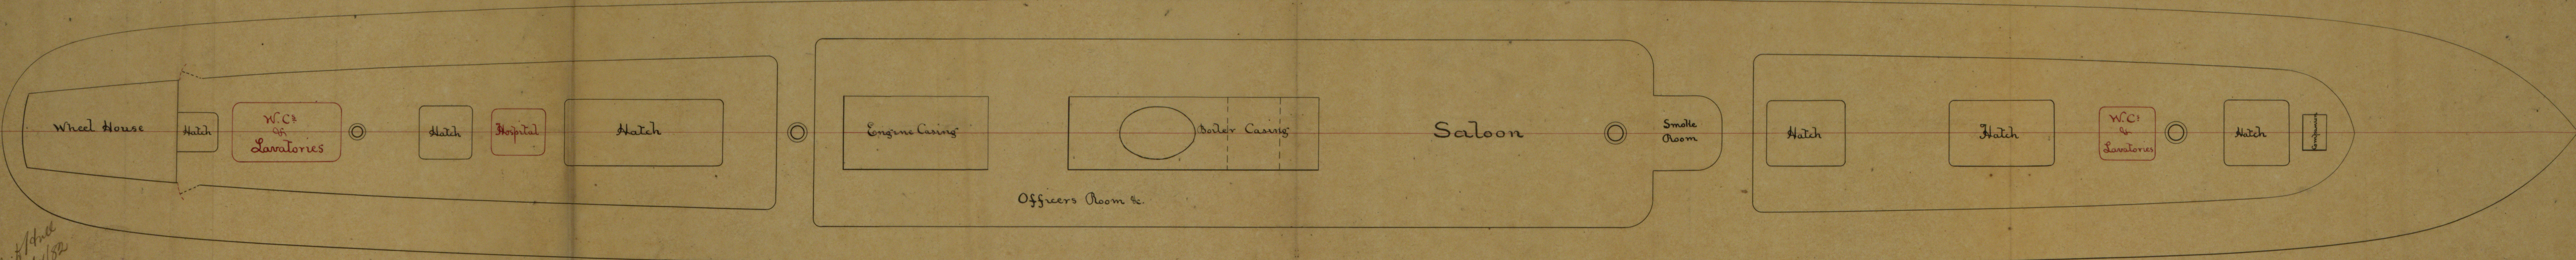


N<sup>o</sup> 241 "Grecian Monarch." Hull Report N<sup>o</sup> 5183.

General Arrangement  
Shewing Additional Erections in red beyond those Approved.

Scale  $\frac{1}{8}$  = 1 foot

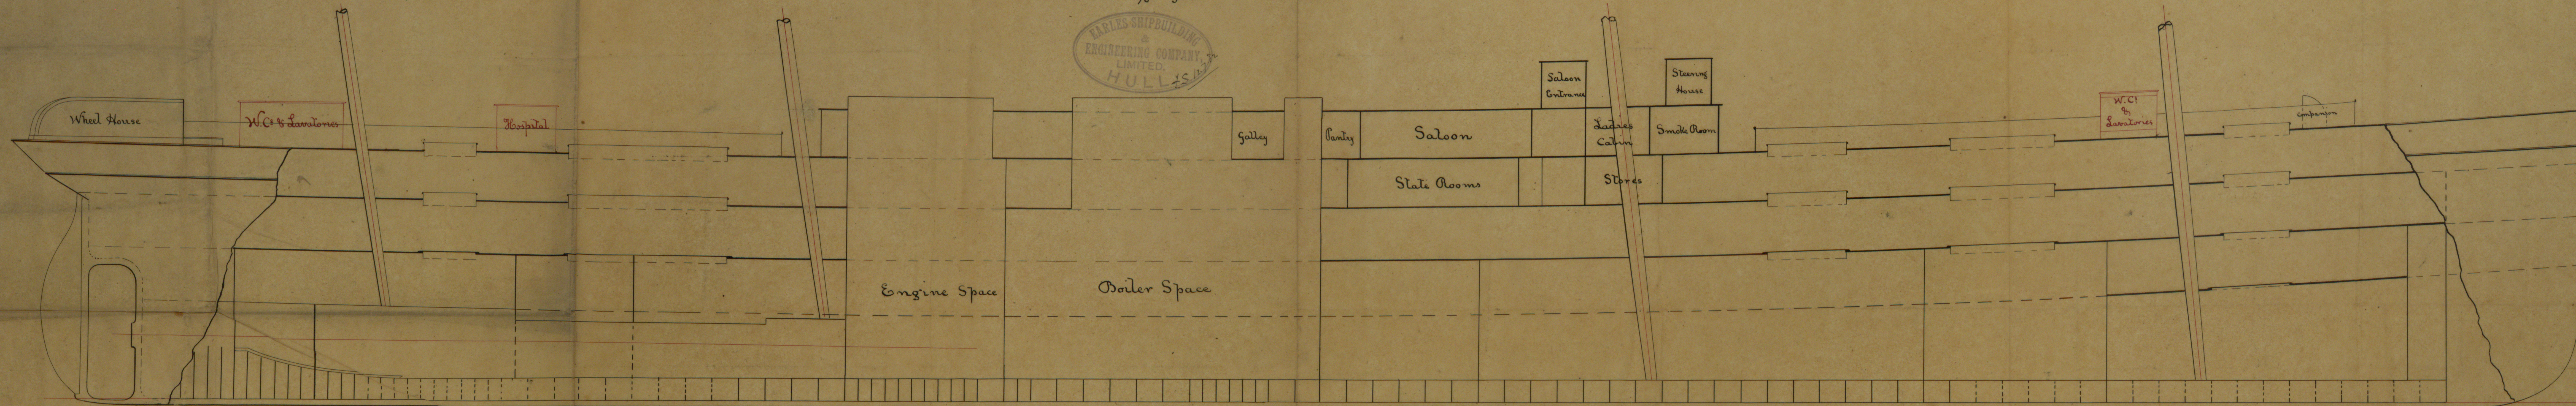

Officers Room &c.

Awning Deck.

27/7/32  
5/1/34

See Plan  
2/1/32



H4L395-0051





© 2021

Lloyd's Register  
Foundation