

Numbers 963 & 36411


Under 13 depths to Main deck
Over 8 1/2 breadths.

S. S. Midship Section - No 241

Dimensions per rule 378.17 x 42.5 x 29.25
Clap 100.0 - Awning deck.



1/2 Breadth = 21.25
Depth = 29.25
1/2 pitch = 45.8
96.30 x 378.17 = 36411

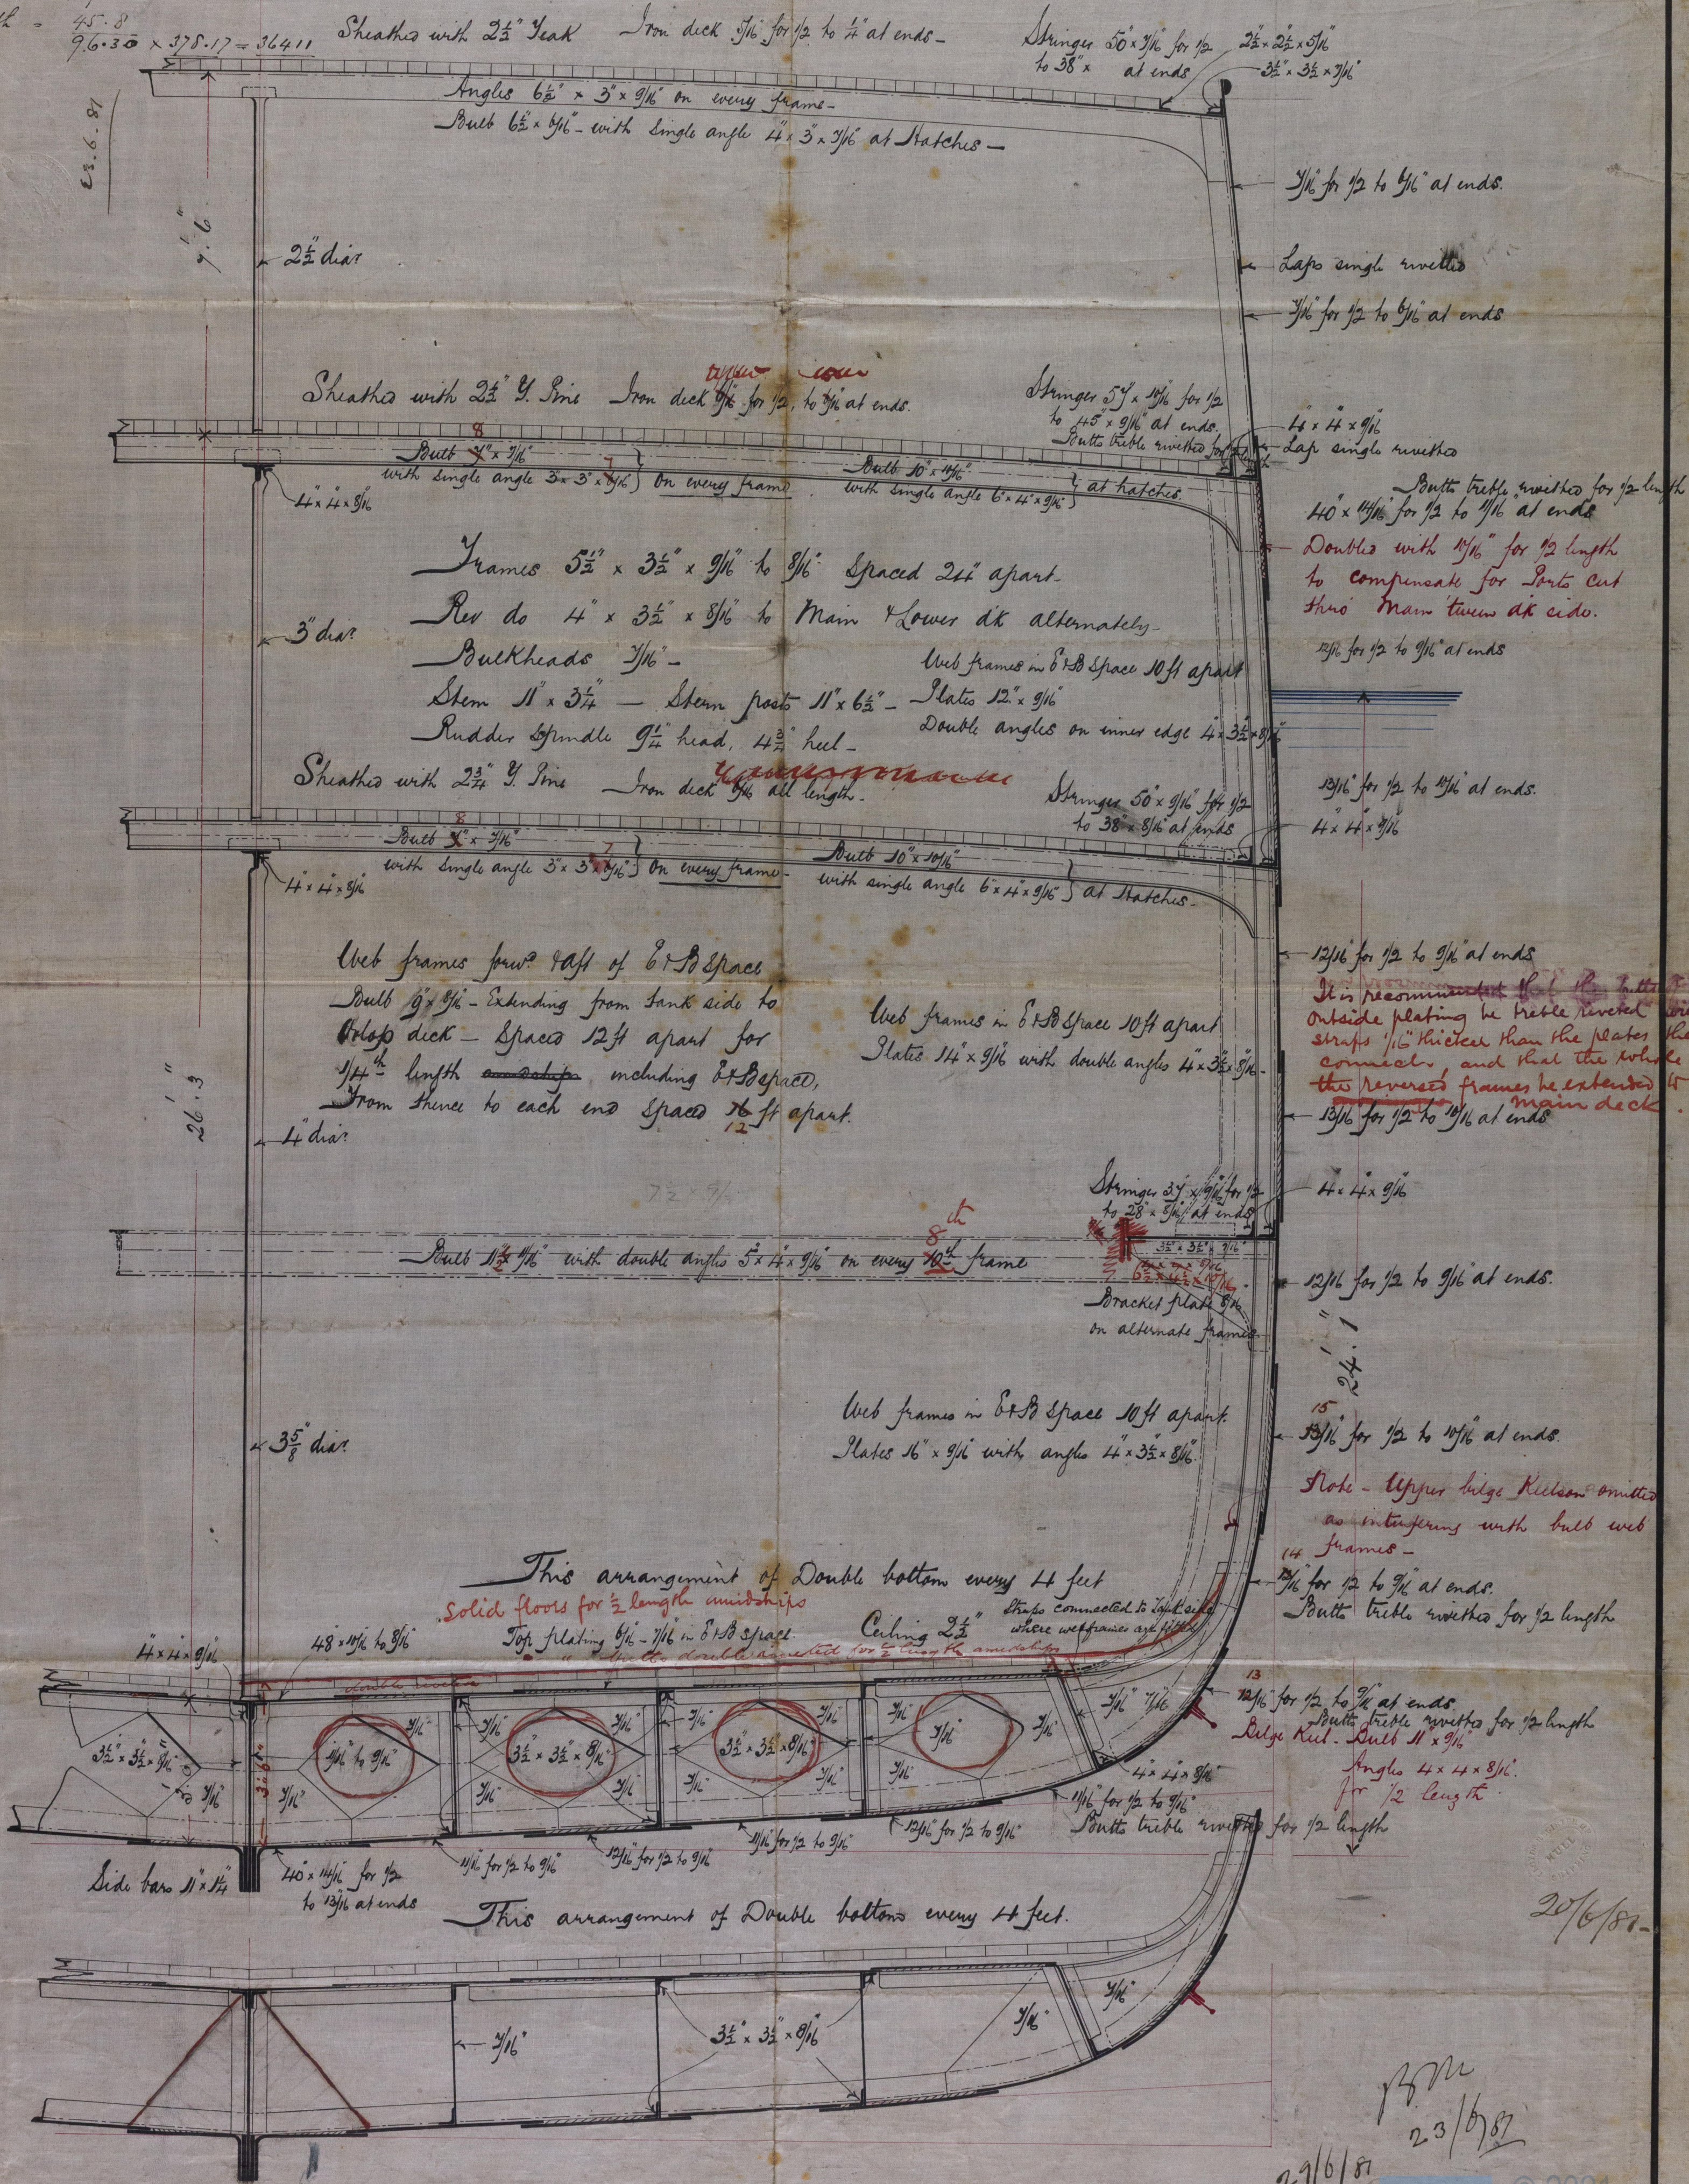

29/6/81
23/6/81
20/6/81