

2/9/81  
20/7/82

20/7/82


No 241

Sketch of Iron House on Downing deck


$\frac{1}{8}$  <sup>th</sup> Scale



EARLES SHIPBUILDING  
&  
ENGINEERING COMPANY,  
LIMITED.  
HULL. 251 J. P. D.

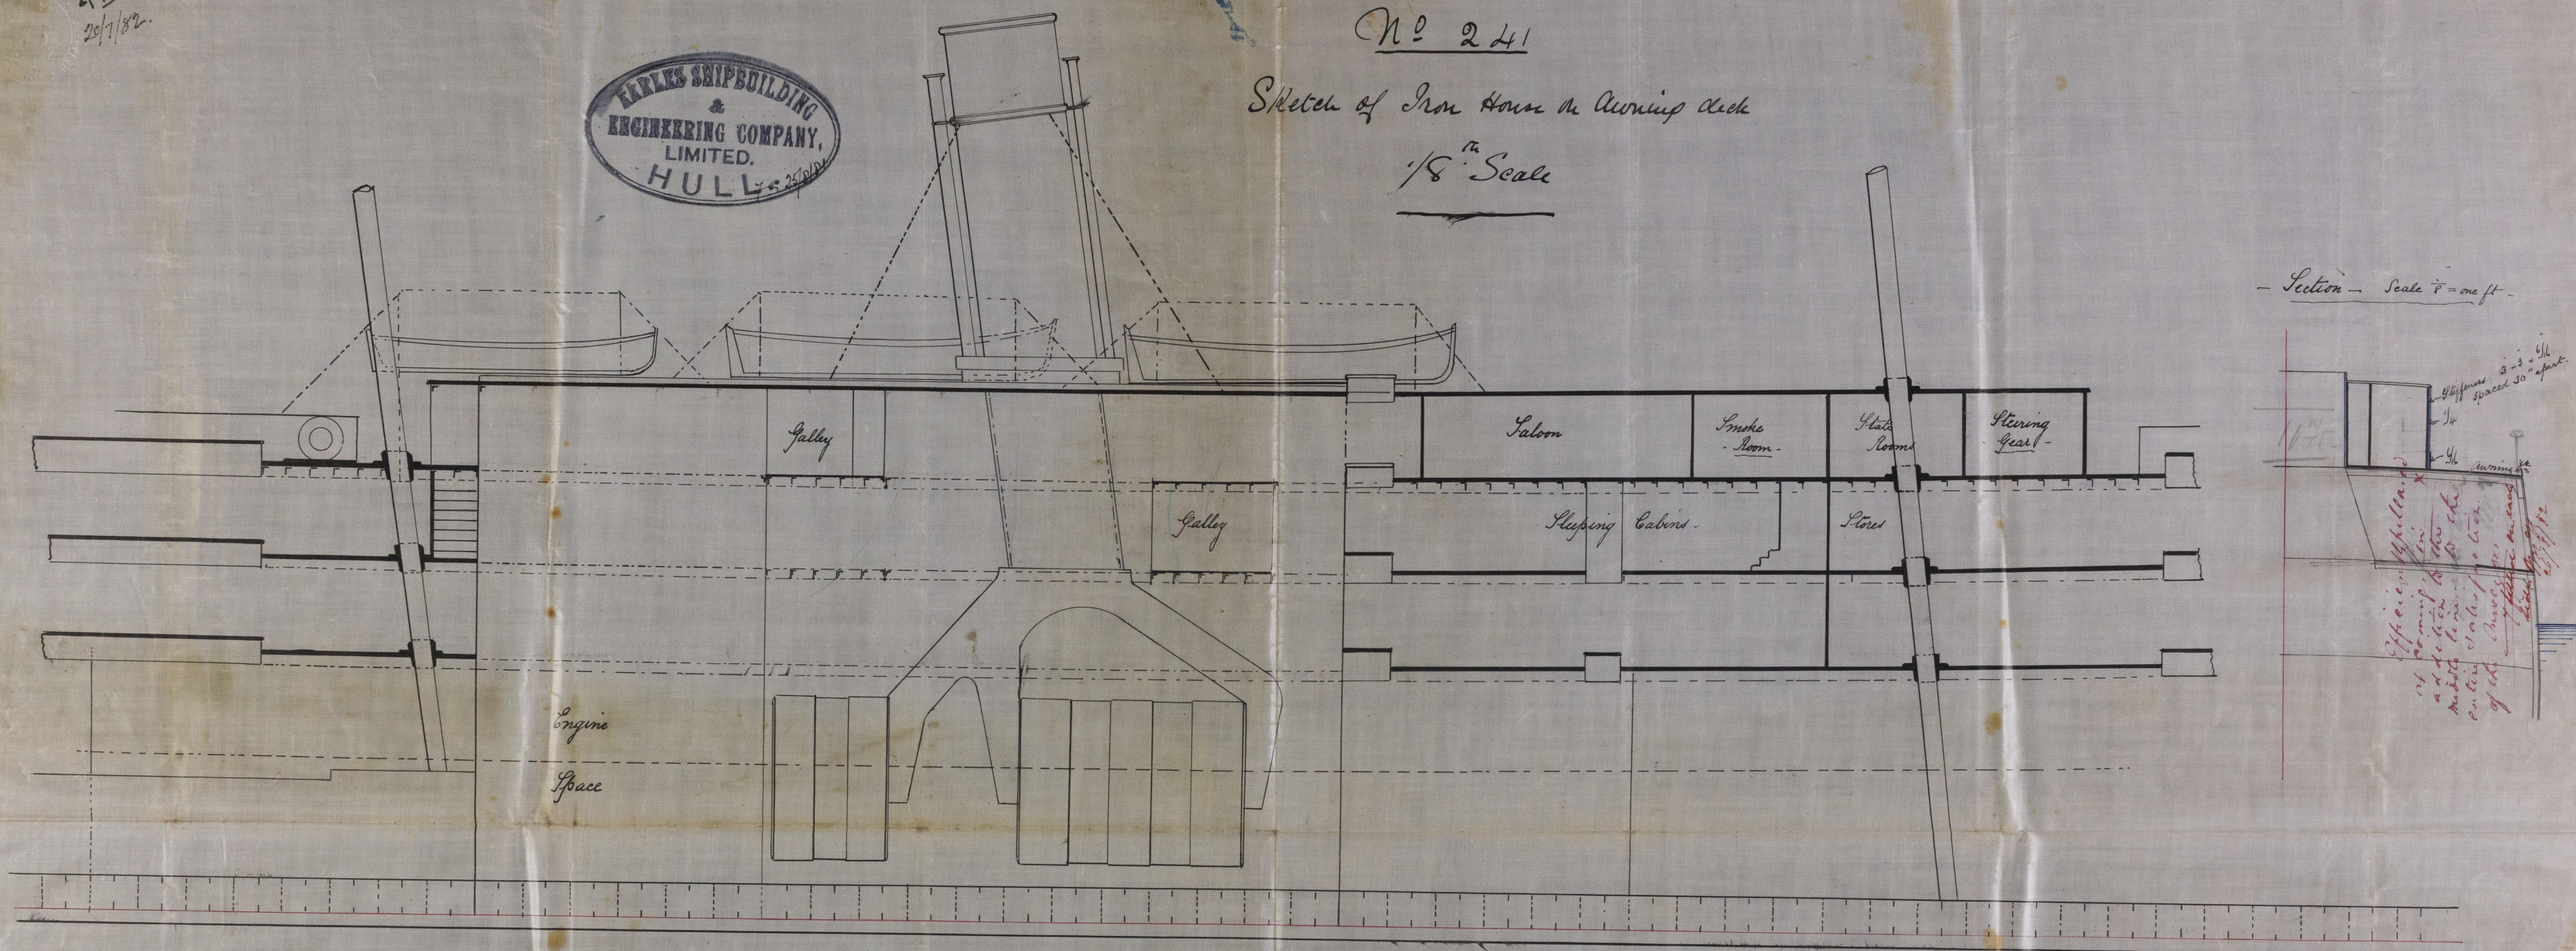

Crowning Deck plan

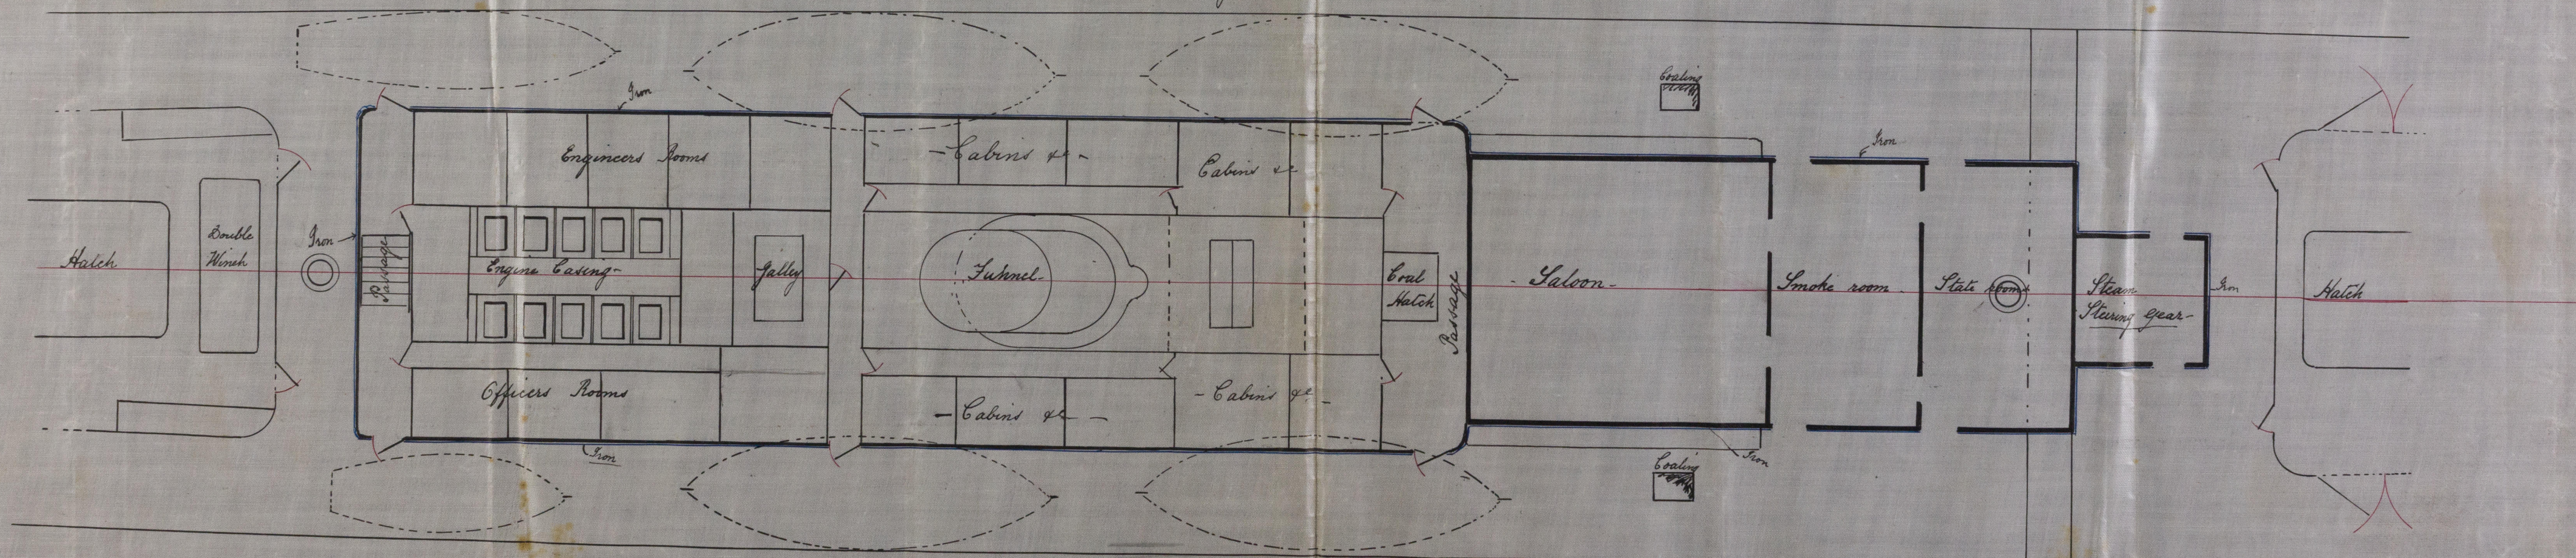

18th

