


Iron Screw Steamer No- by Messrs Scarr at Beverley.
Dimensions

Length P.O.P.	115 feet
Beam moulded	17 " 9 inches
Depth moulded	9 " 4 "
" hold to floor	9 " 0 "
" top keel to top of beams	9 " 11 "
Class 90 A	

RECEIVED APR. 89.

Midship Section $\frac{3}{4}$ Scale

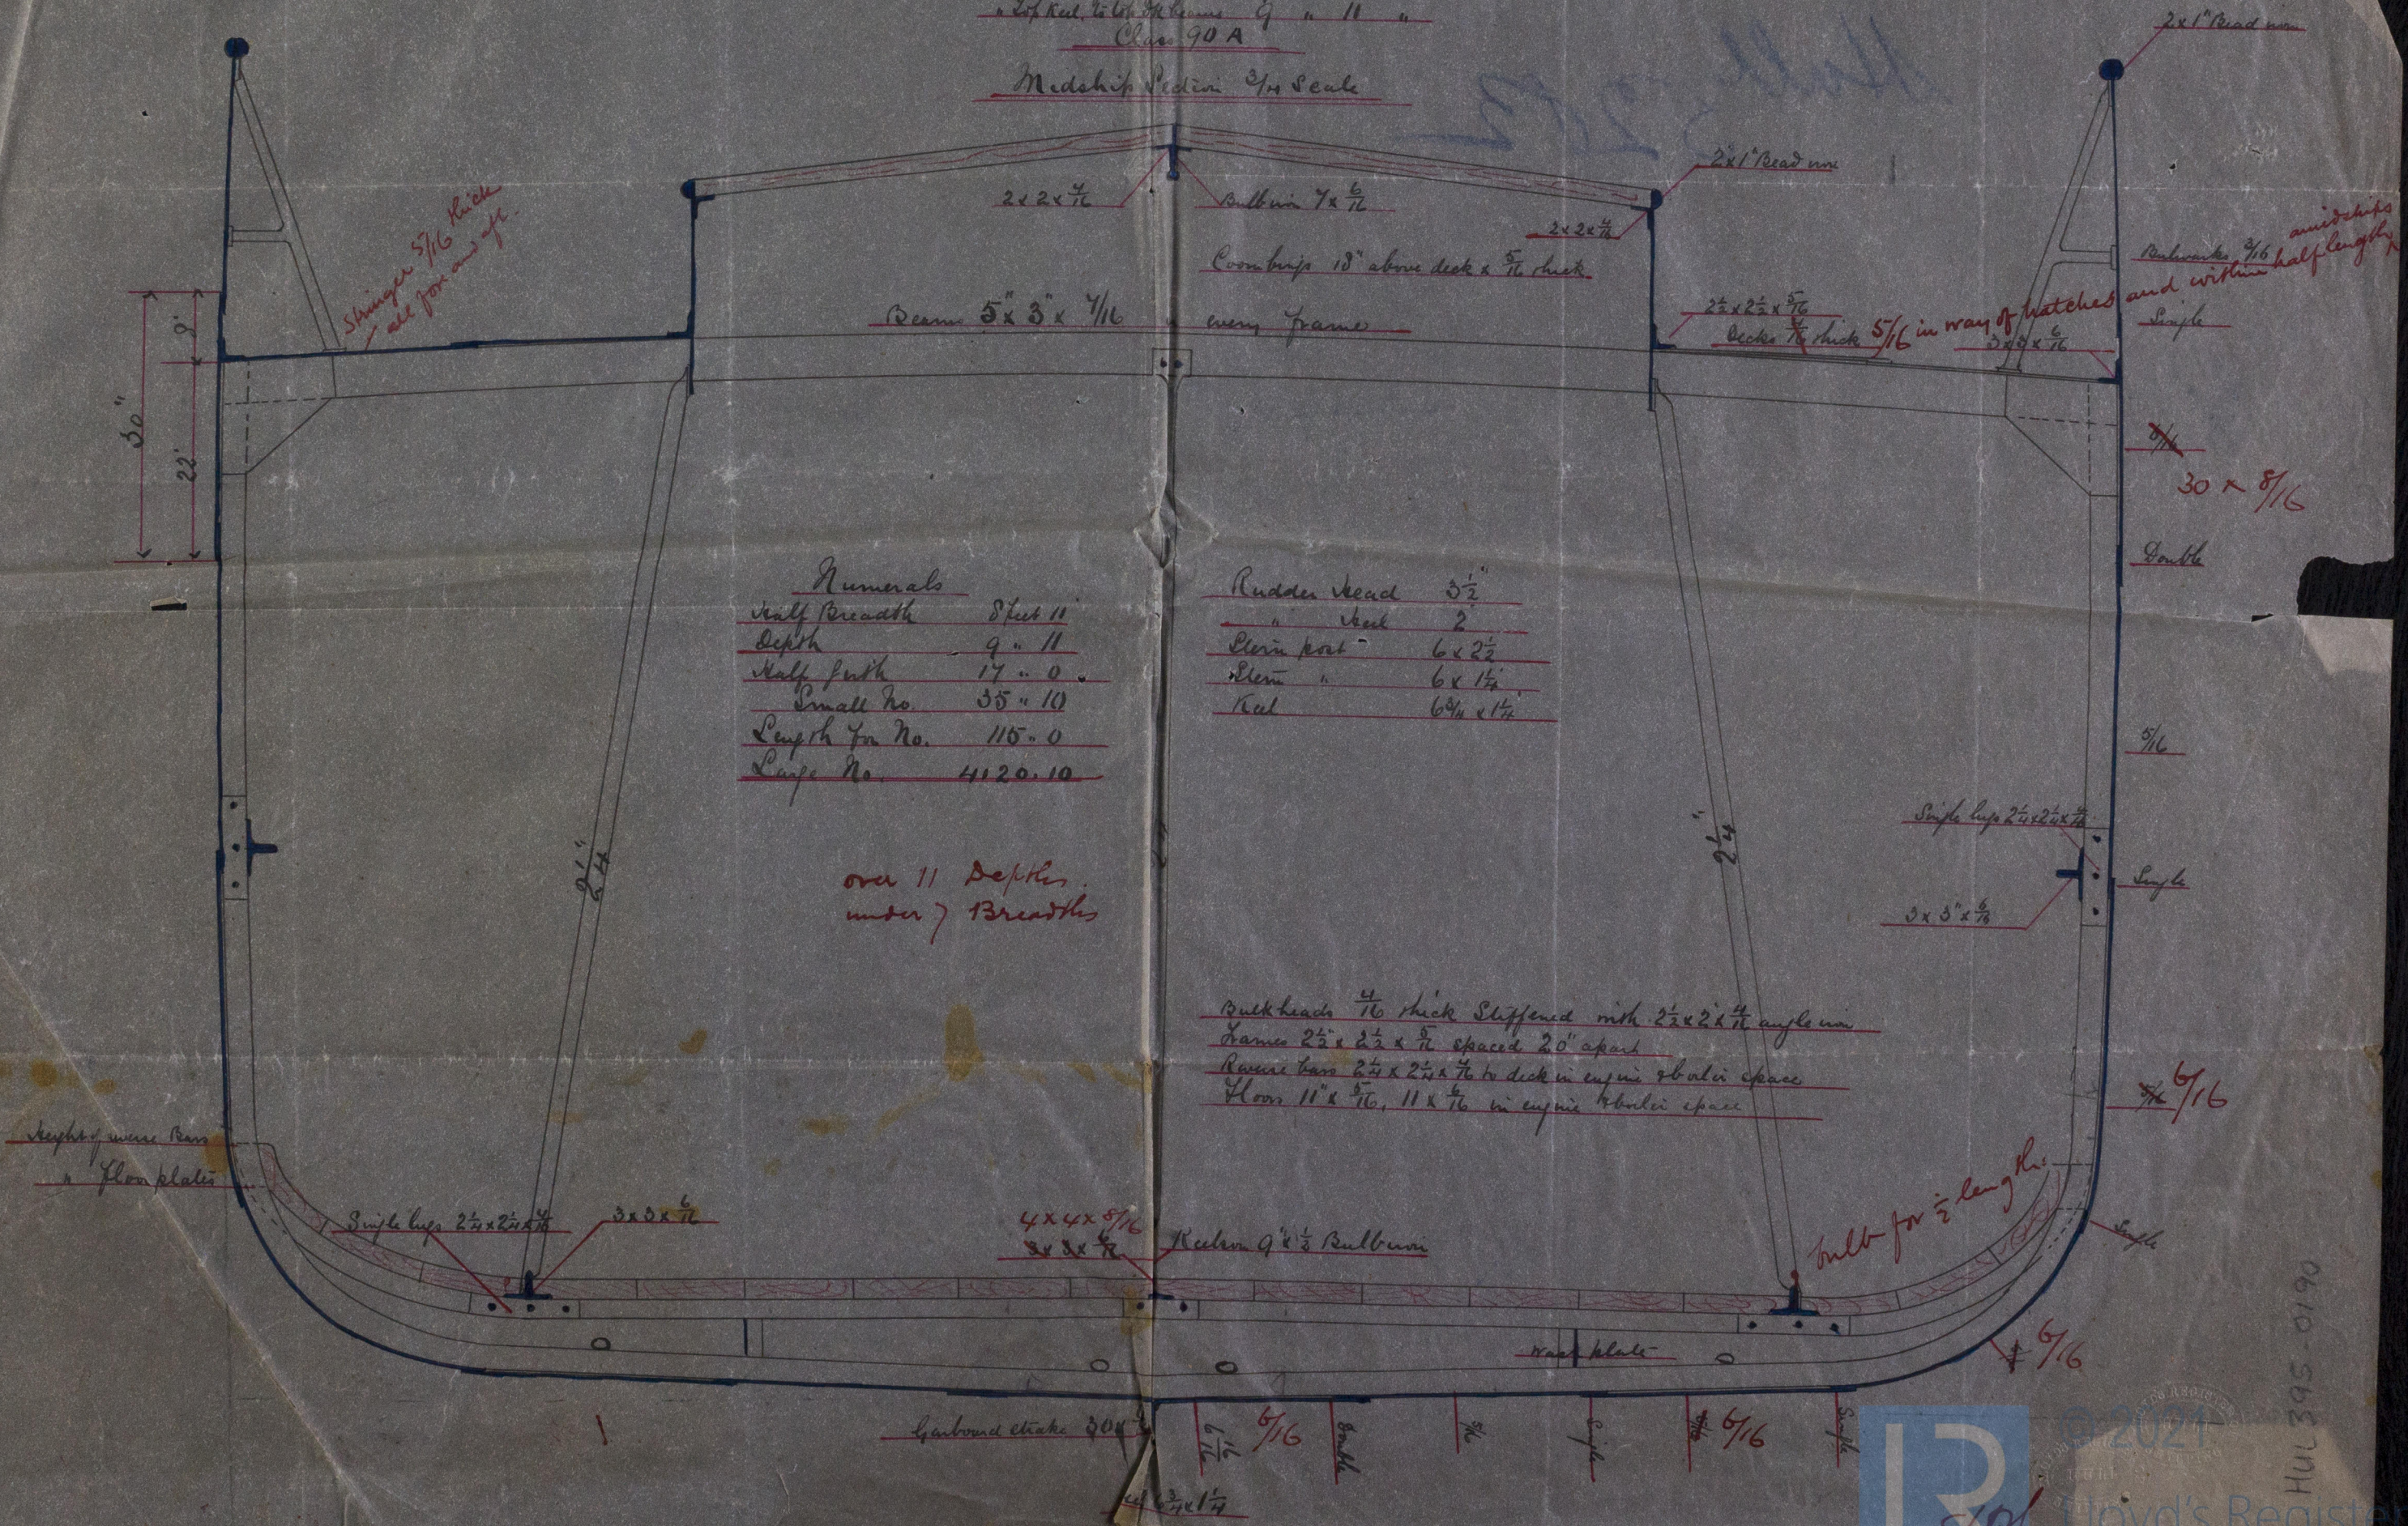






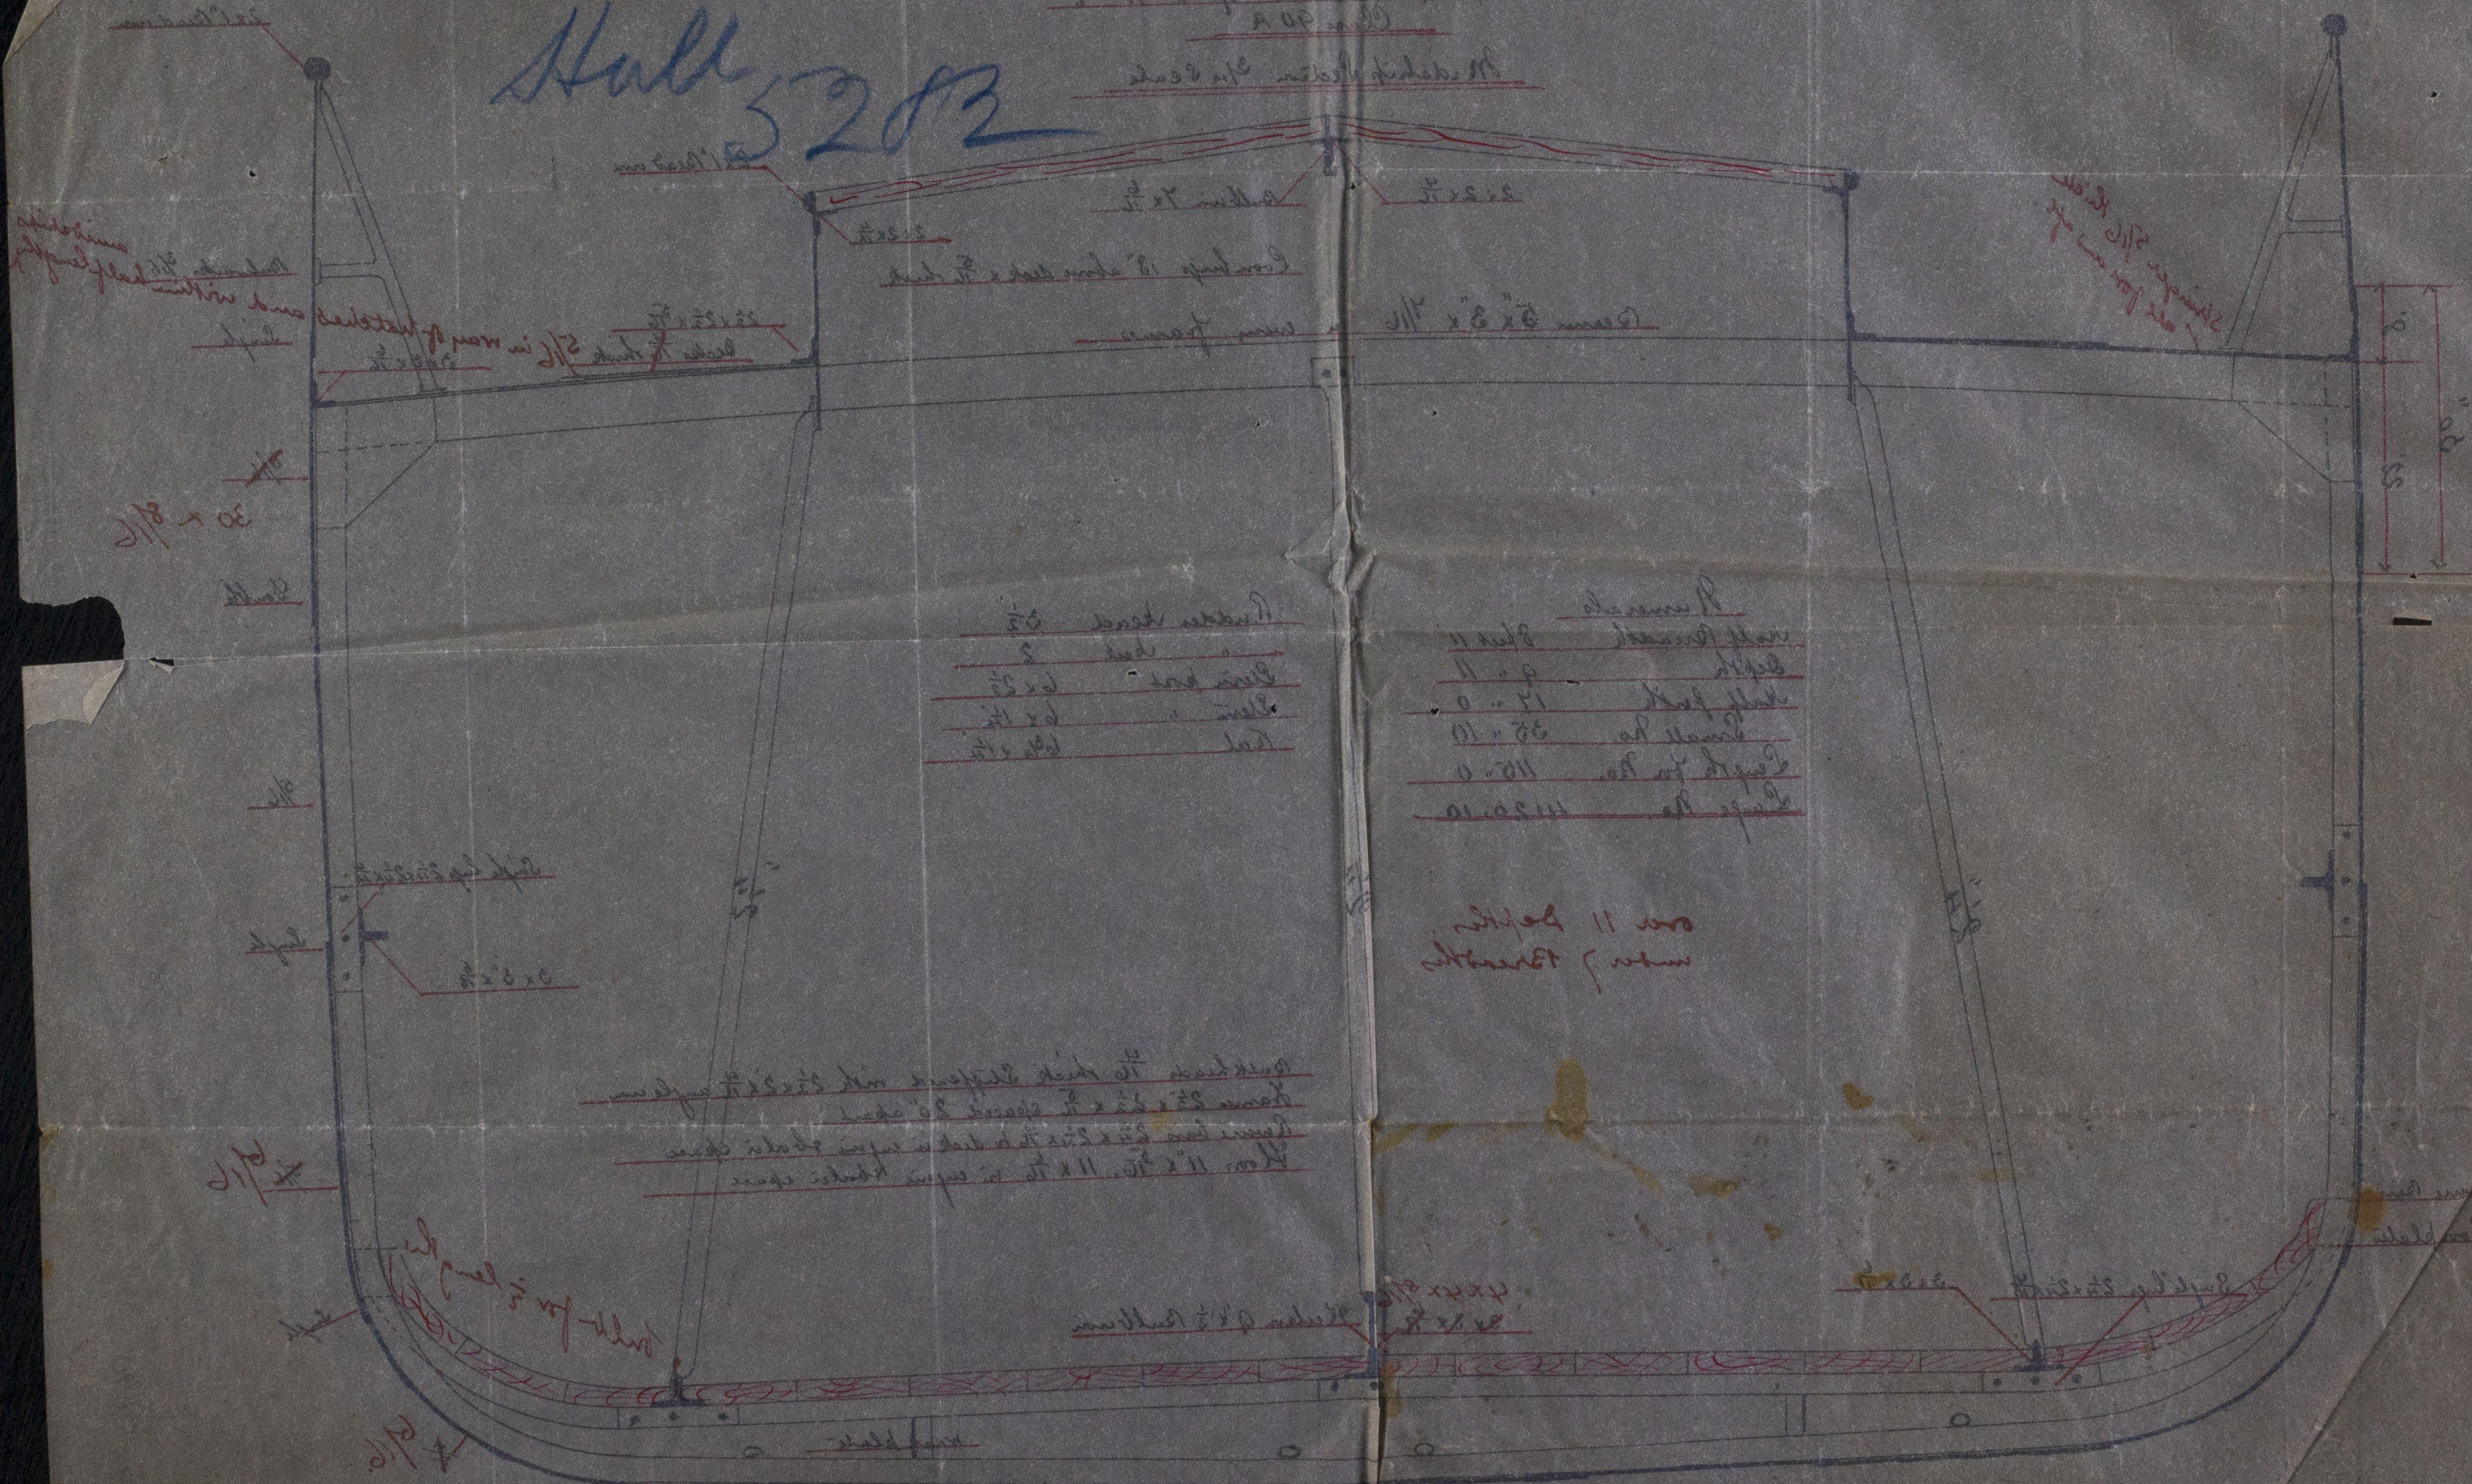


over 11 feet


