RECEIVED 2nd MAY 82.

— Iron Screw Steamer "Alice" Hull Report No: 5282 —

Amended Sketch of Midship Section of a

—— Steam Barge to be built by Messrs H & J. Scarr ——
of Beverley near Hull
— Scale 3/4 in = 1 Foot —

—Dimensions—

	ft	in
Length between Perpendiculars — —	115	0
Breadth moulded — — — —	17	9
Depth of Hold — — — —	9	0
" moulded — — —	9	7

3.5.82

— to class 90 A —

—Lloyds Numbers—

½ Girth — —	16.54
½ Breadth —	8.88
Depth — —	9.58
	35.00

35.33 × 4045

35.33
114.5
17665
14132
3533
4045 28.5

—First No 35 × 114.5 = Second number 4005—

—Raised Quater Deck 33'-6" long, Forecastle 14'-6" long

6.4 Breadths
11.5 Depths

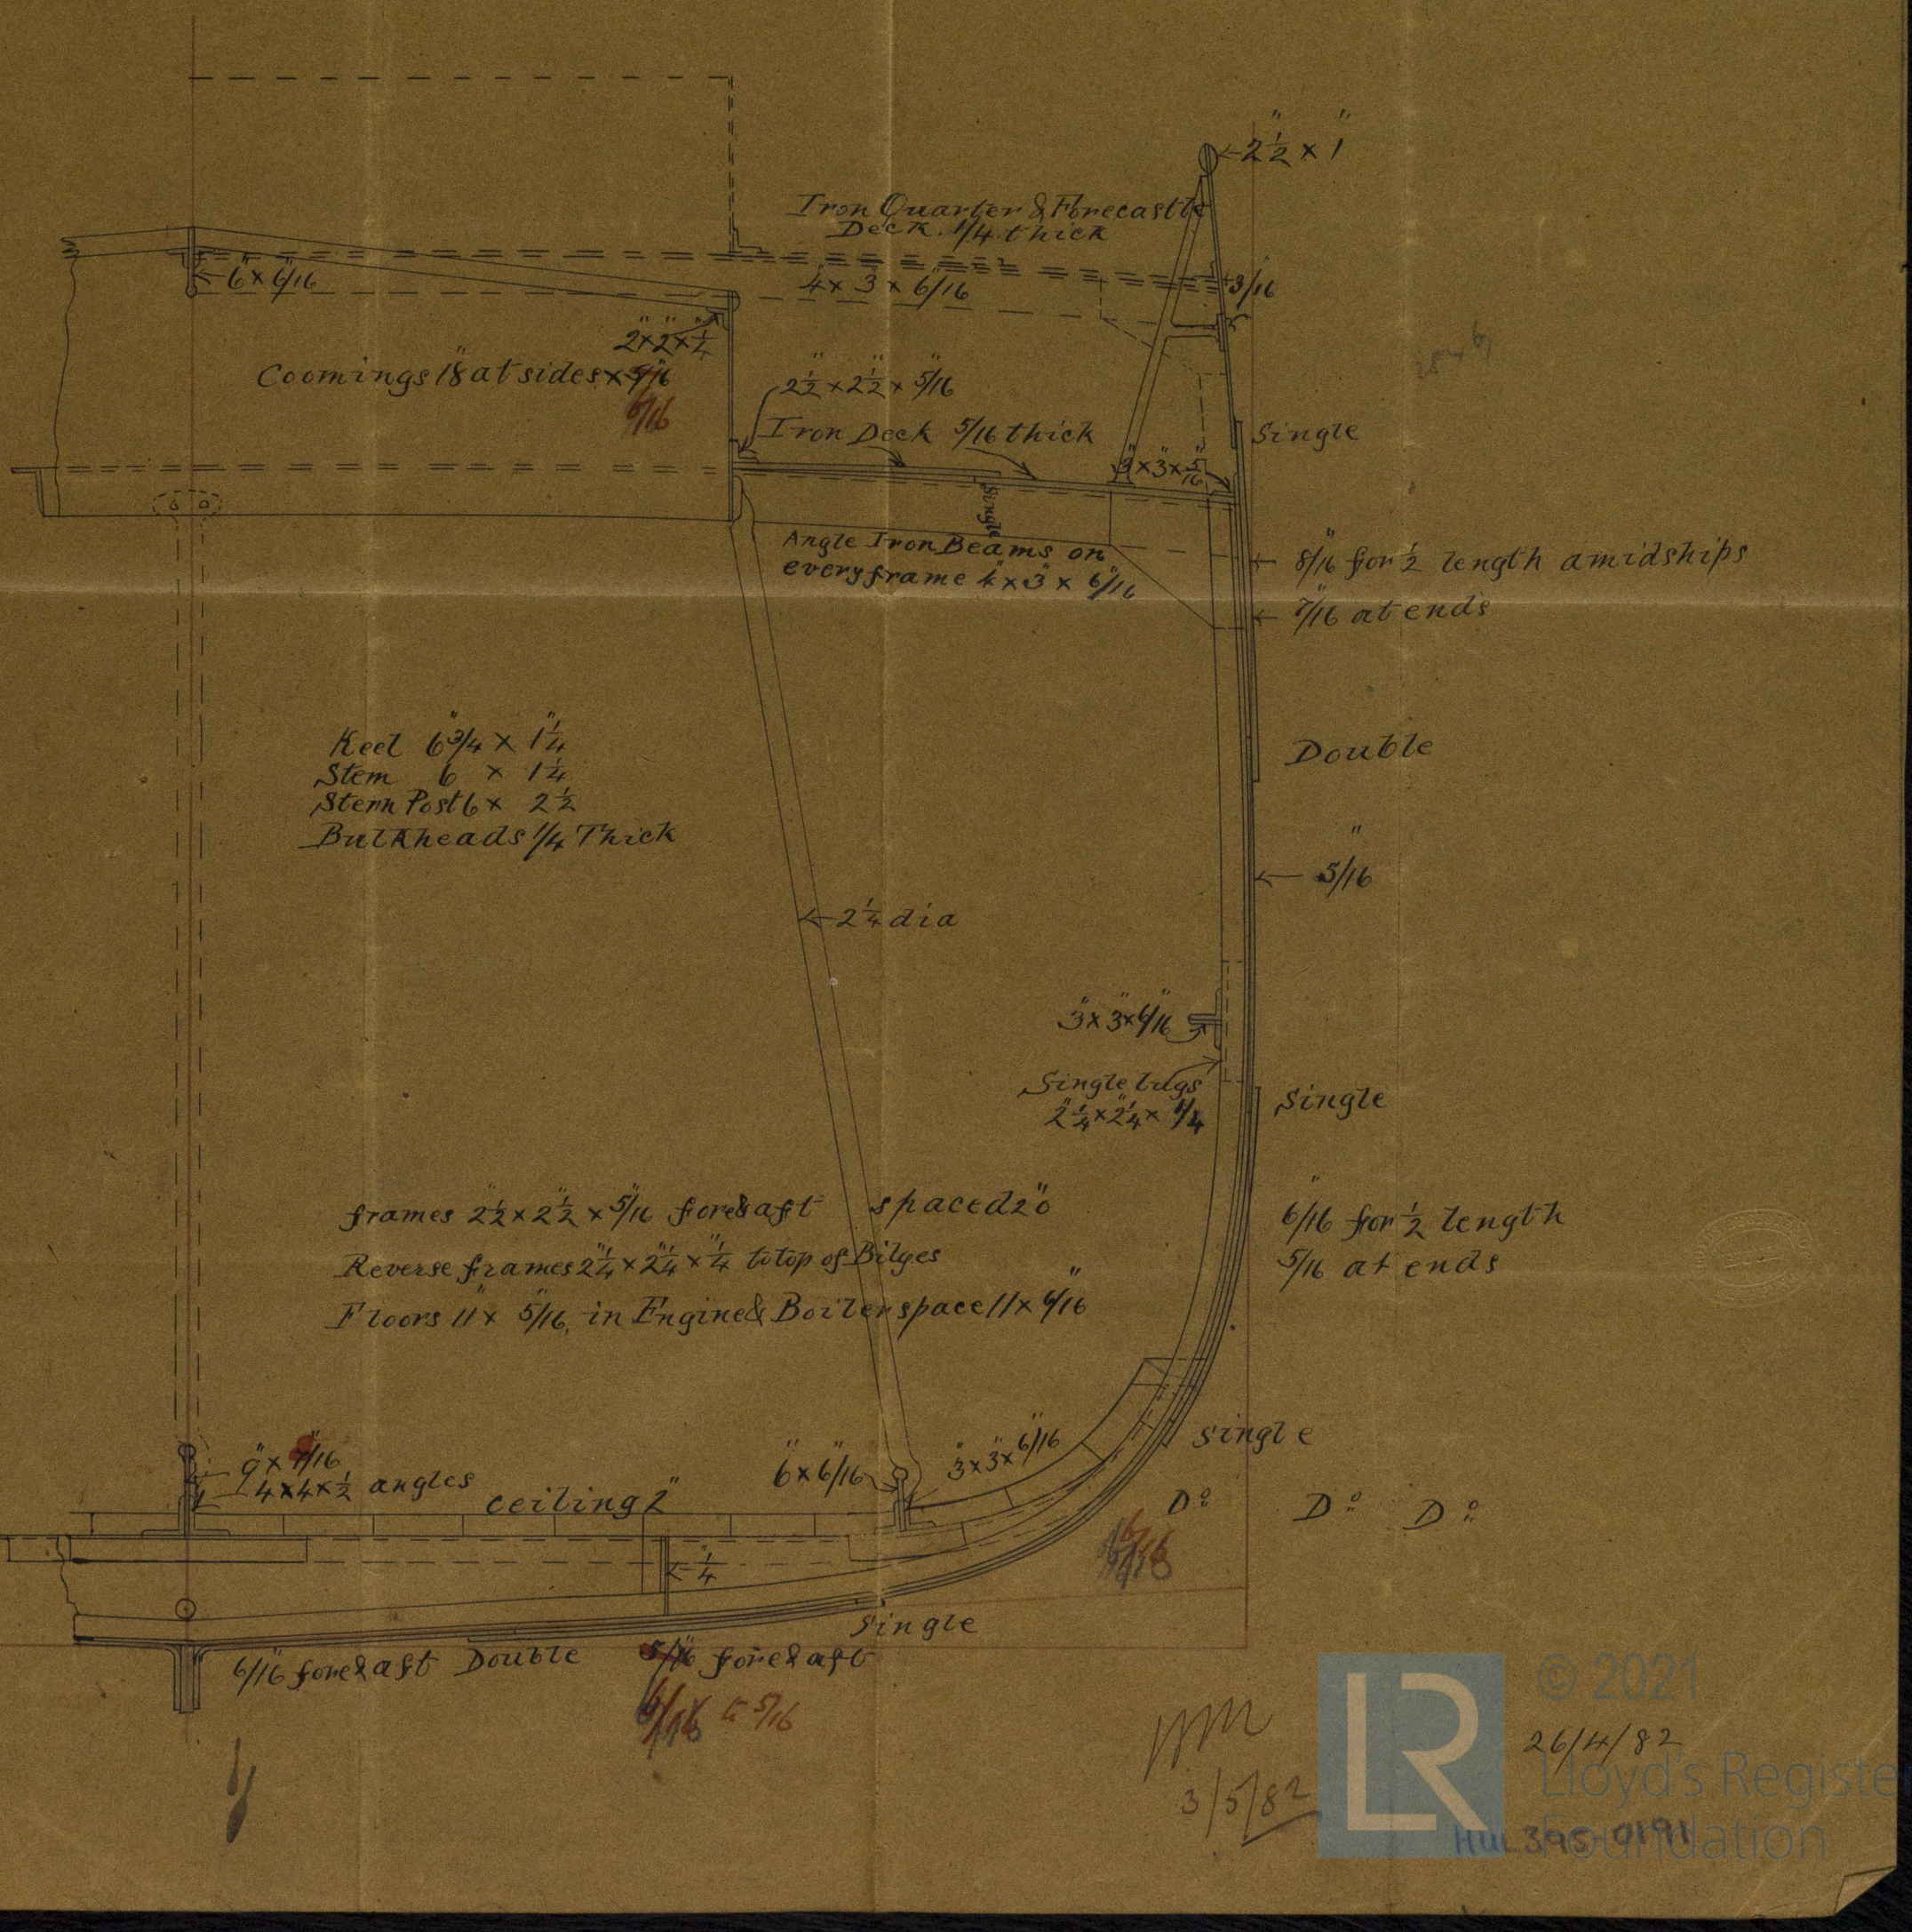

3/5/82

26/4/82

© 2021 Lloyd's Register Foundation