

Long Joint of Shell Copper  
 dble riveted - holes punched  $1\frac{1}{8}$ " dia &  $2\frac{1}{2}$ " pitch  
 Cir. - single riveted.  $1\frac{1}{8}$ " dia &  $2\frac{1}{2}$ " pitch


Boiler for steamer building at Brainerd  
 by Mr. Scan  
 S.S. "Alice" True Repat Co.

GOOD & MENZIES,  
 LATE  
 THOMPSON & STATHER  
 ENGINEERS,  
 HULL

Let to Hull  
 3/6/82  
 17/6/82

D.G.  
 3/6/82  
 17/6/82

Shell single riveted circum.  
 double longitudinal  
 Working pressure 140 lbs } per sq m.  
 Tested with water to 80  
 Heating surface in tubes 1405 sq ft  
 Total in B<sup>4</sup> 310  
 Scale 1" = 1 foot

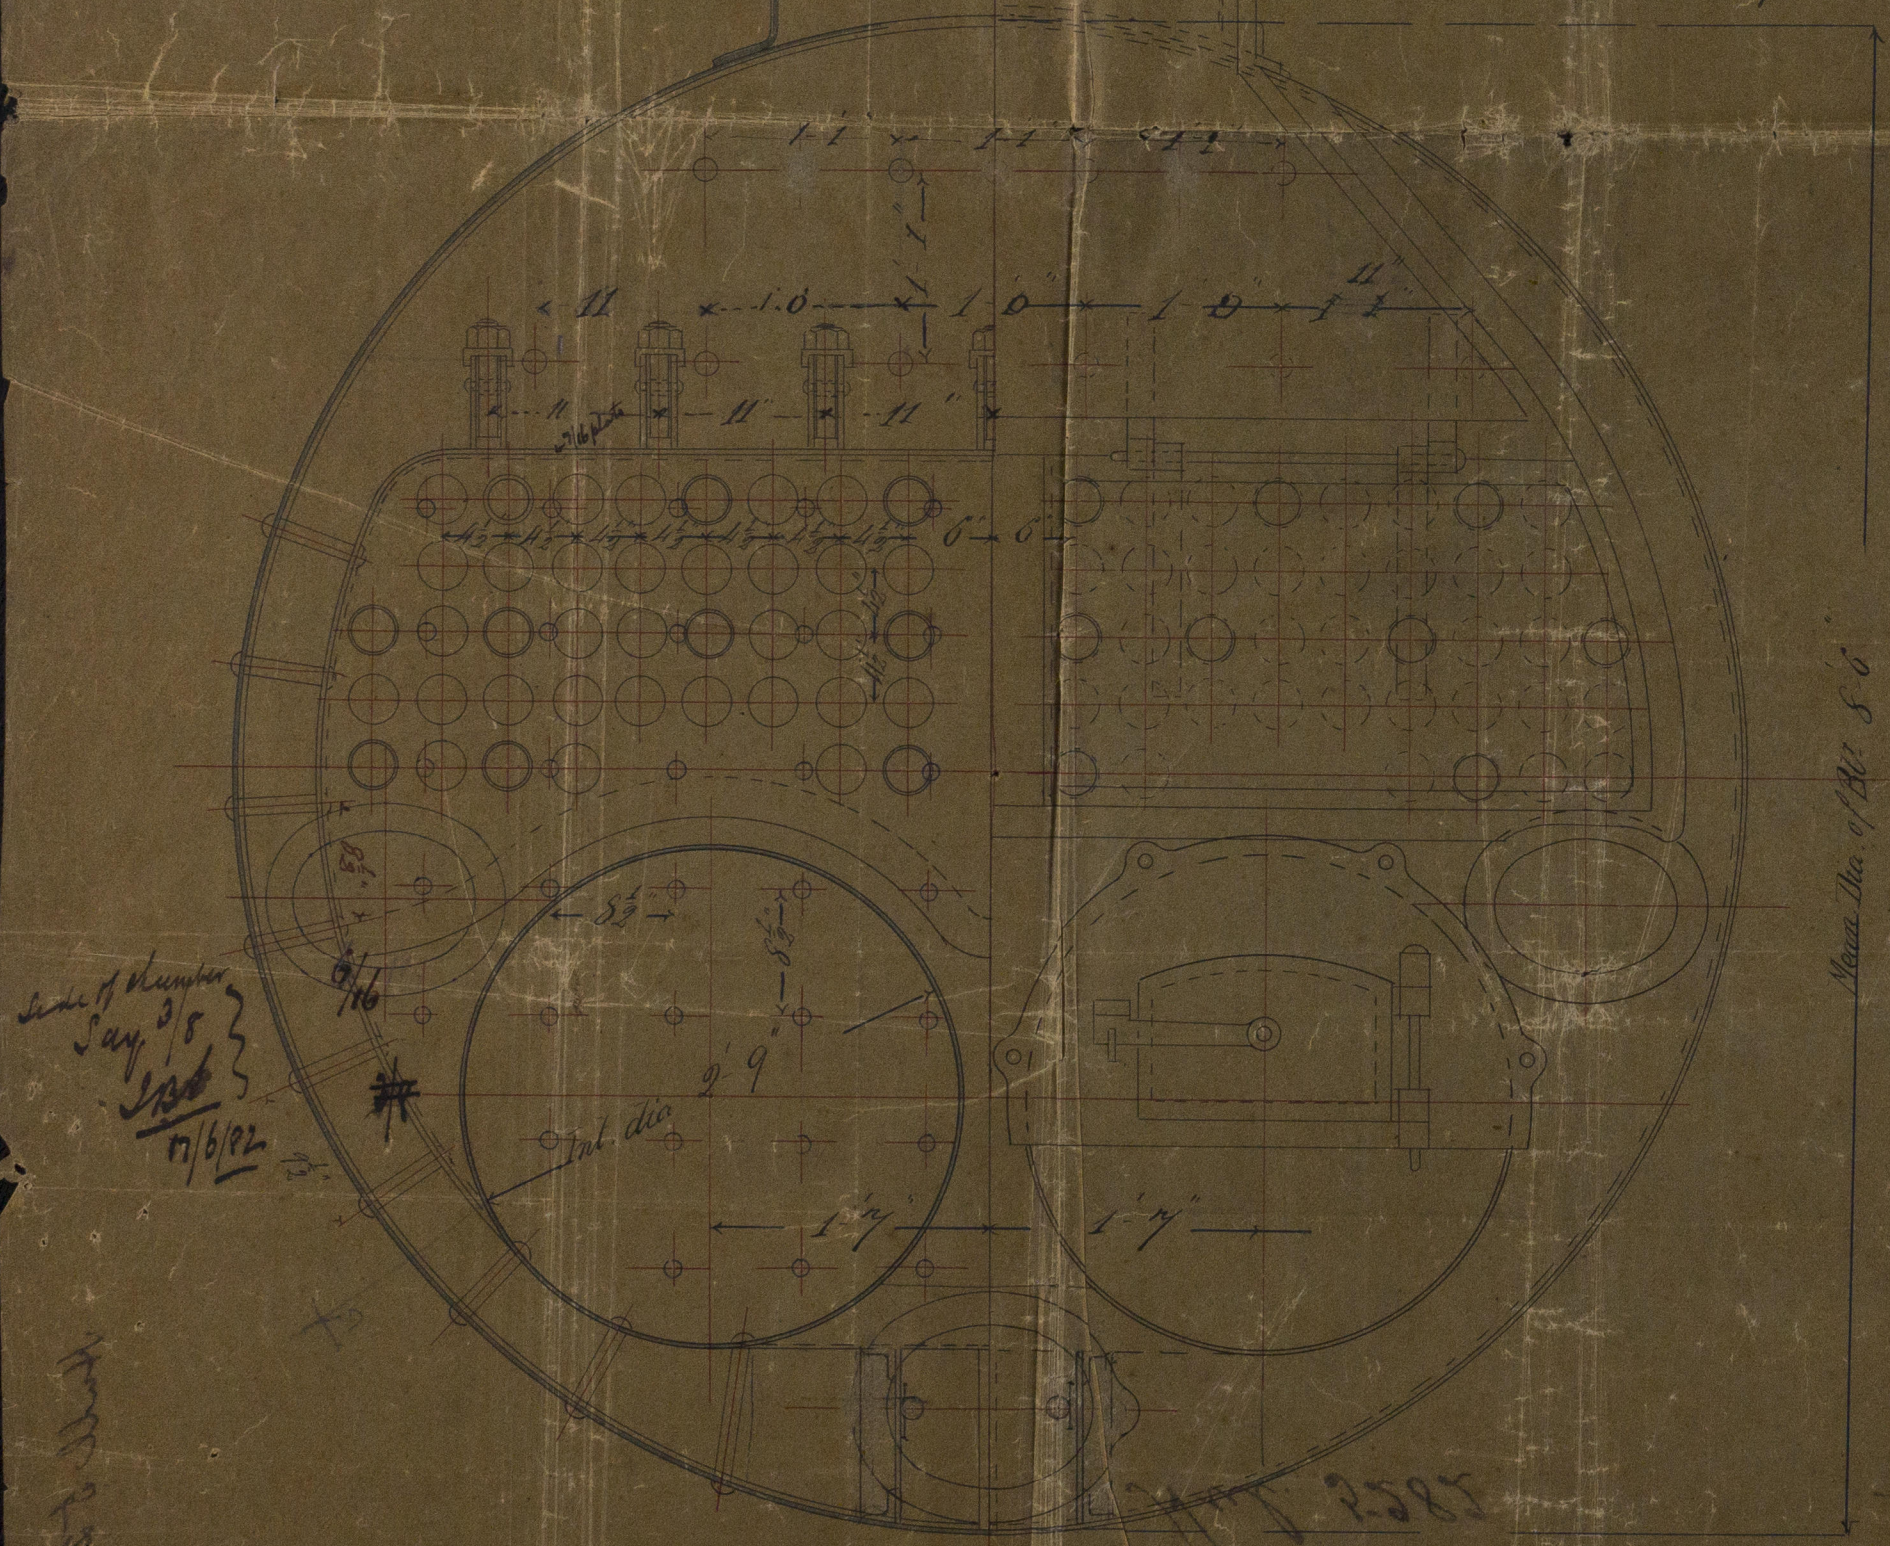


Let to Hull  
 3/6/82  
 17/6/82

2585



Plan of Steam Chest

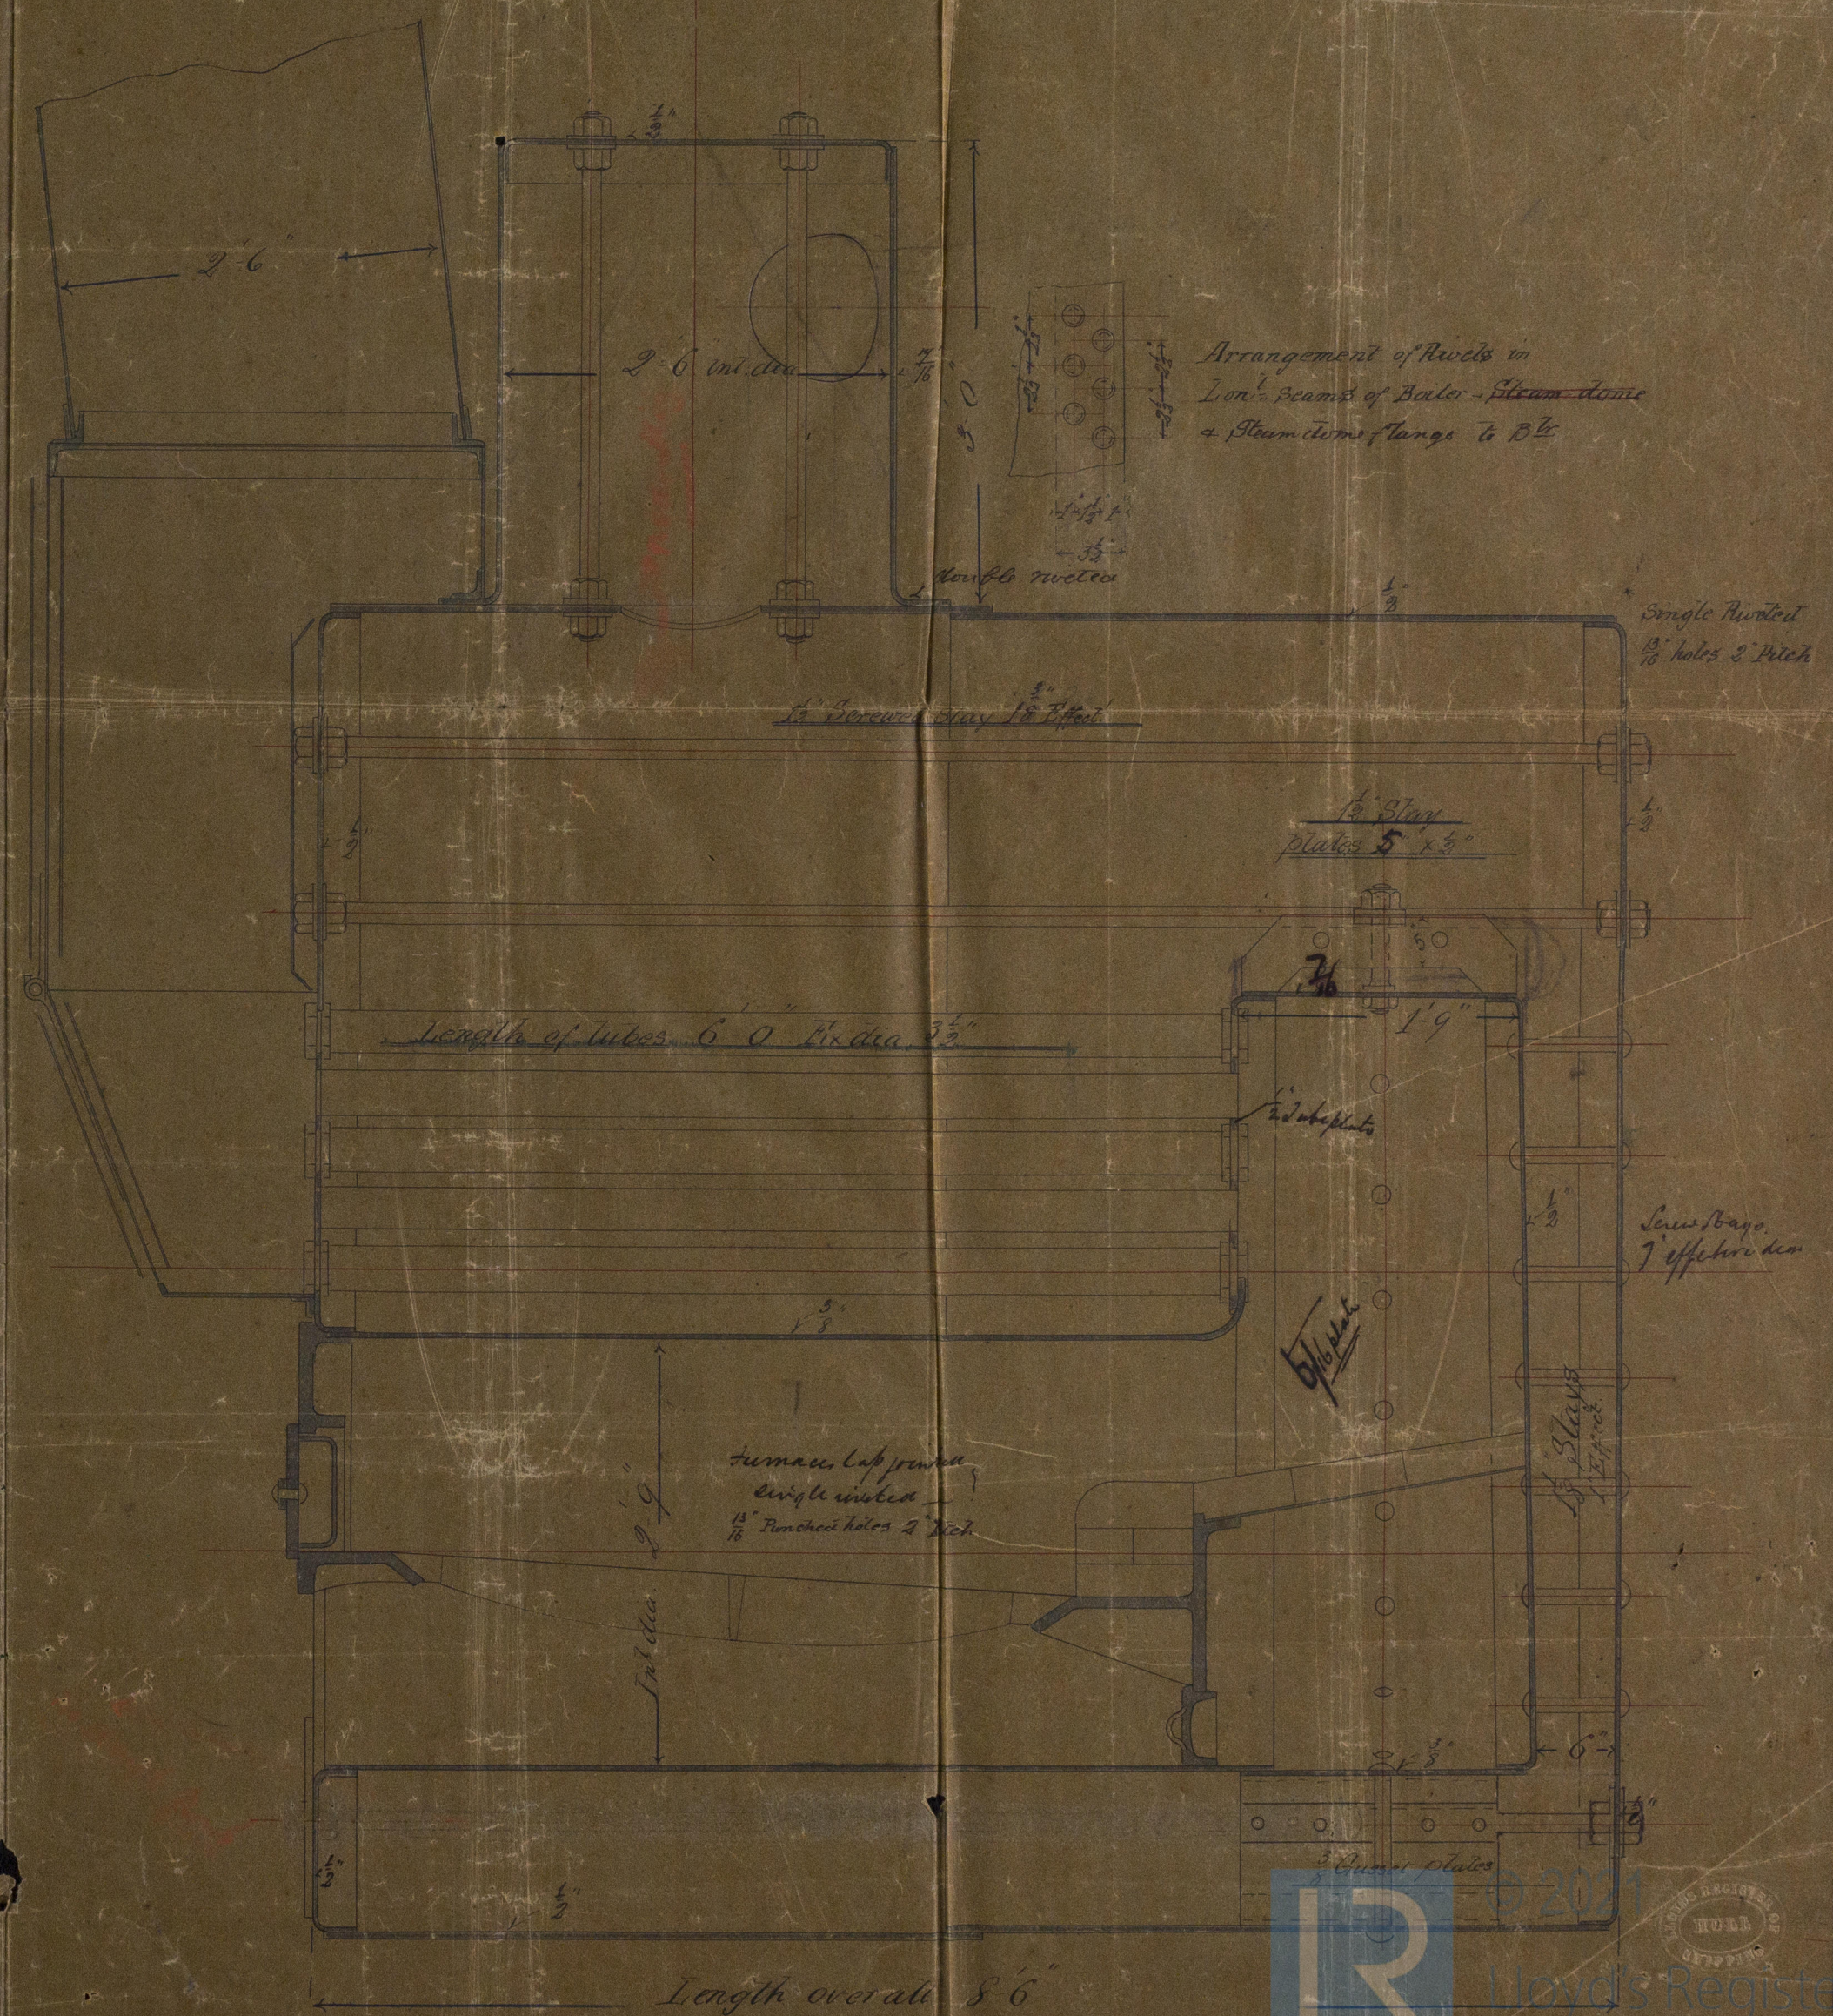



Hull 5282


HWL395-0193

Price


Hull 5282

2nd 2nd 10/10/10  

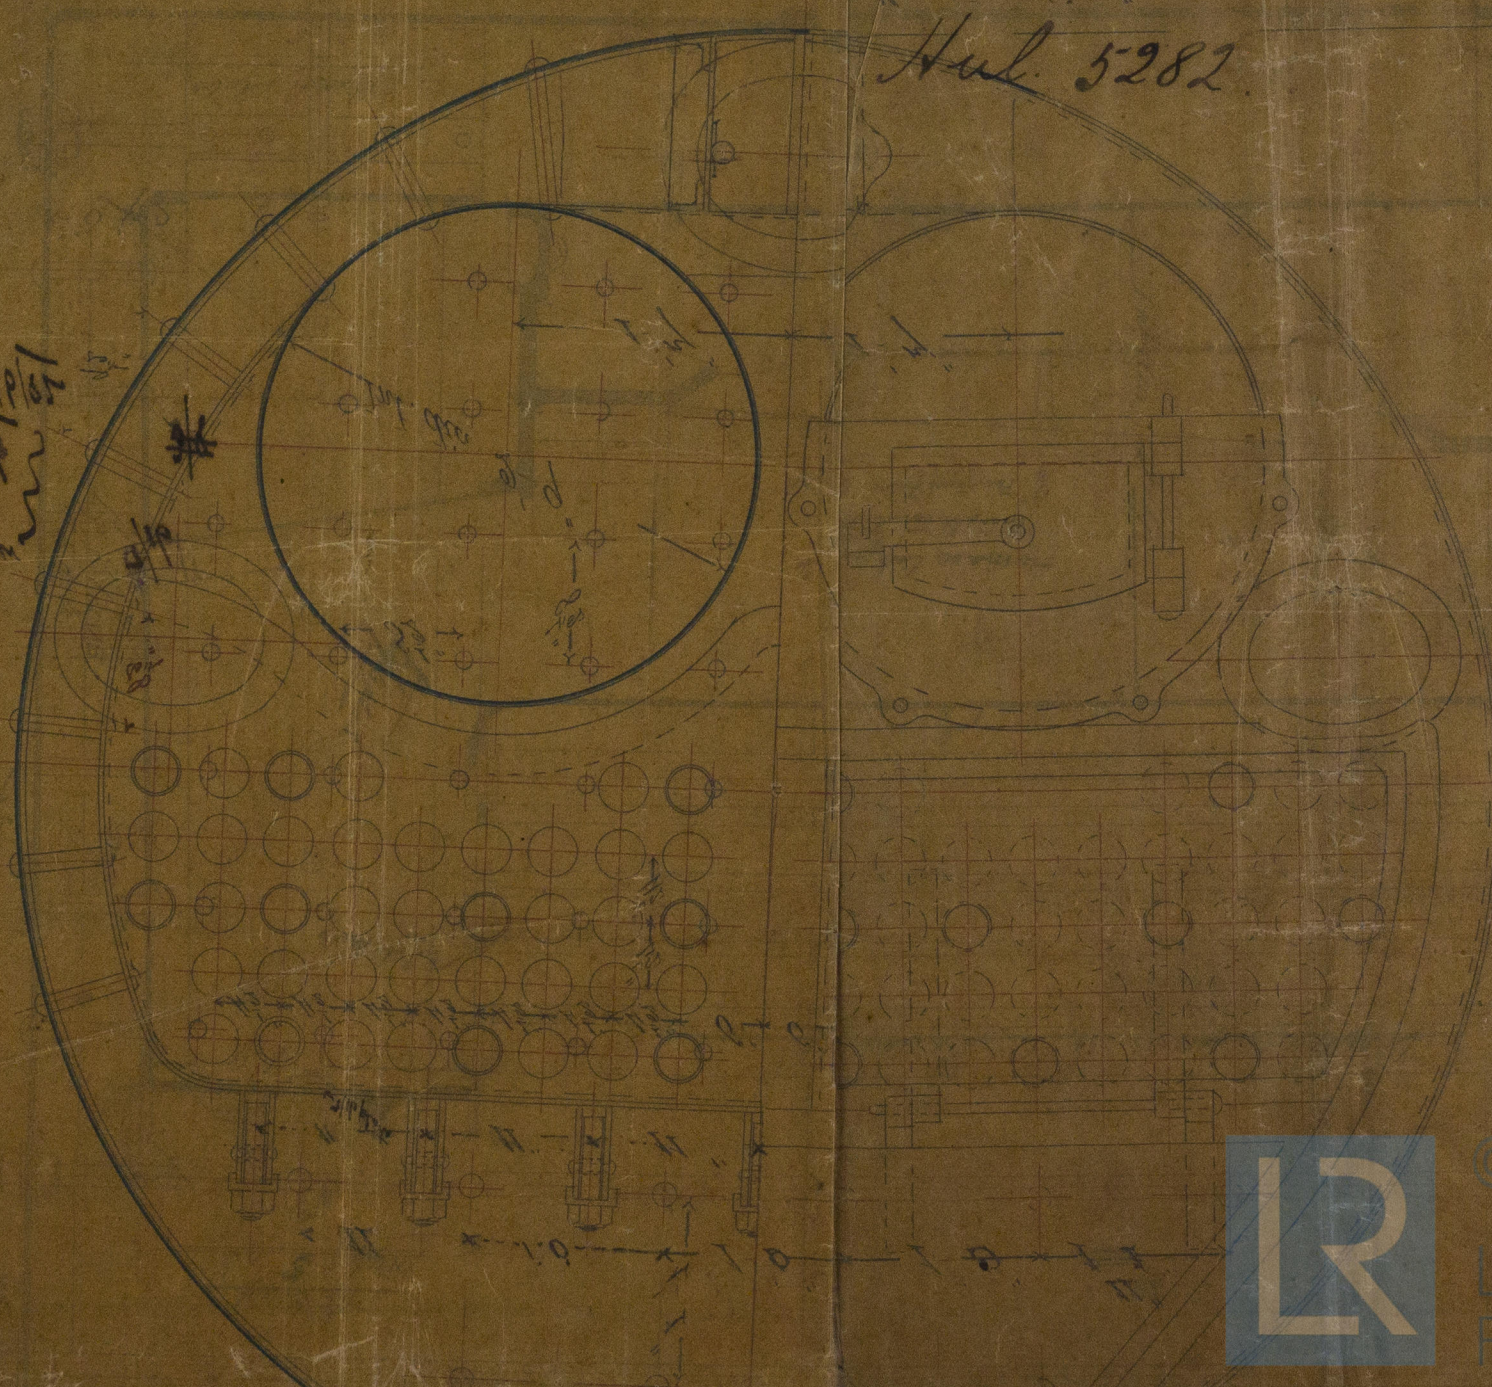




© 2021

Lloyd's Register  
Foundation