RECEIVED 24th JULY, 82

S. S. "Bolama". Hull Report No: 5324

Ltr to Hull 25/7/82

S. S. No 260

Mid ship Section.

Dimensions per rule 178.9 x 26.0 x 14.8

To Class 100 A

- Scale ½" = One Ft. -

Under 13 depths
Under ½ breadths.

½ Breadth	13.
Depth	14.8
½ Girth	25.
1st Rule	52.8
	178.9
2nd Rule	9446.

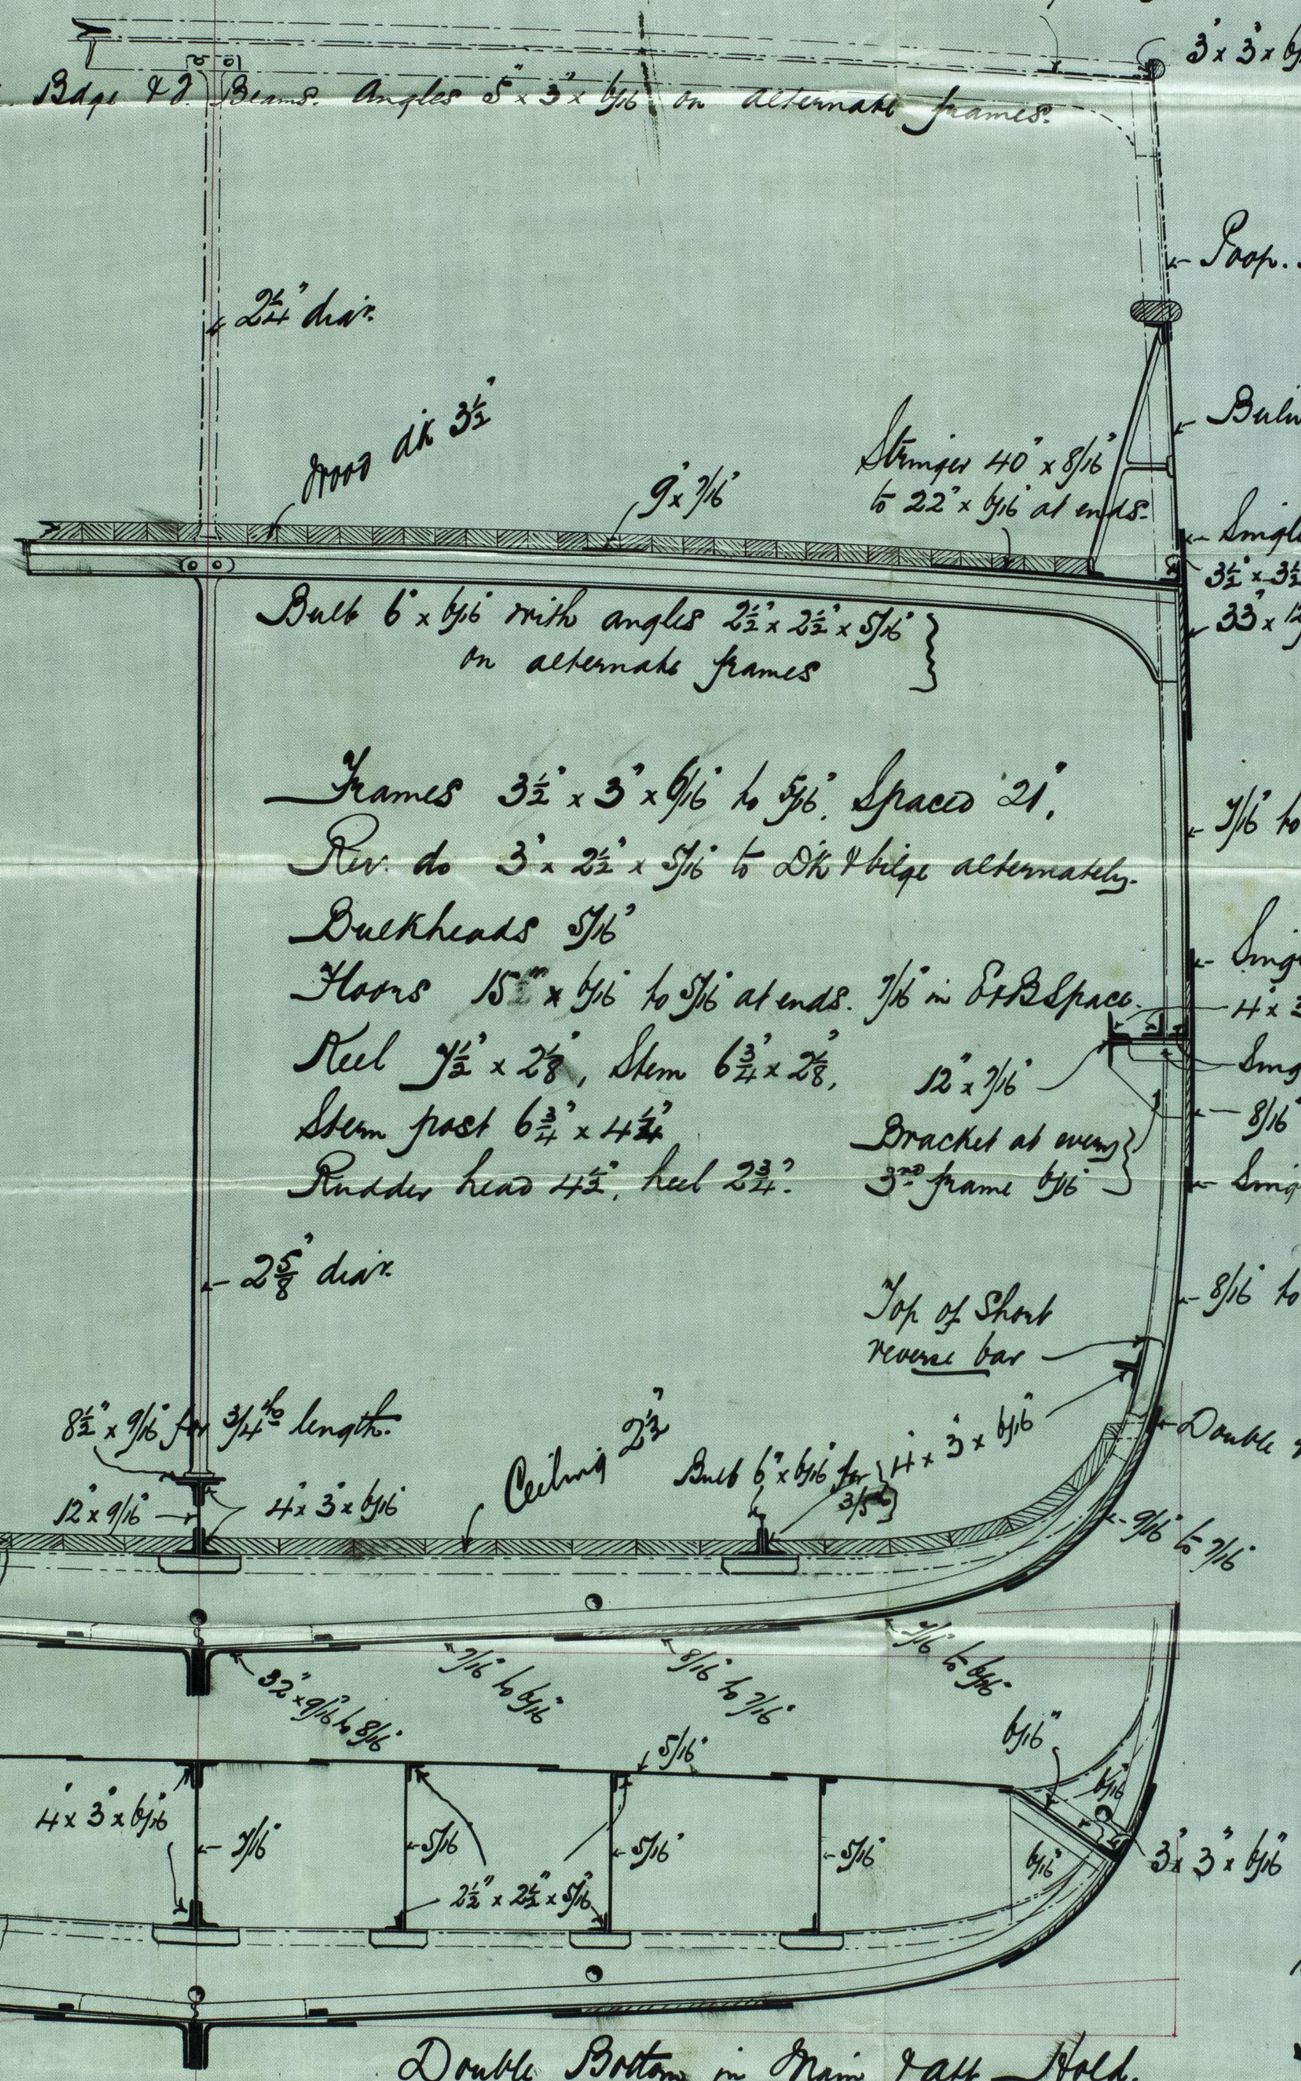

Double Bottom in Main & Aft Hold.

EARLES SHIPBUILDING & ENGINEERING COMPANY, LIMITED. HULL 25 JUL 82

- Riveting -

Main deck Stringer, Sheer Strake & butts of two strakes at bilge to be treble riveted for ½ length amidships, Straps 1/16" thicker than plates.

Ltr to Bldr 26/7/82.

25/7/82

S2020 HULL 5324 yard © Lloyd's Register Foundation