




Dr. H. Hall  
7/5/83

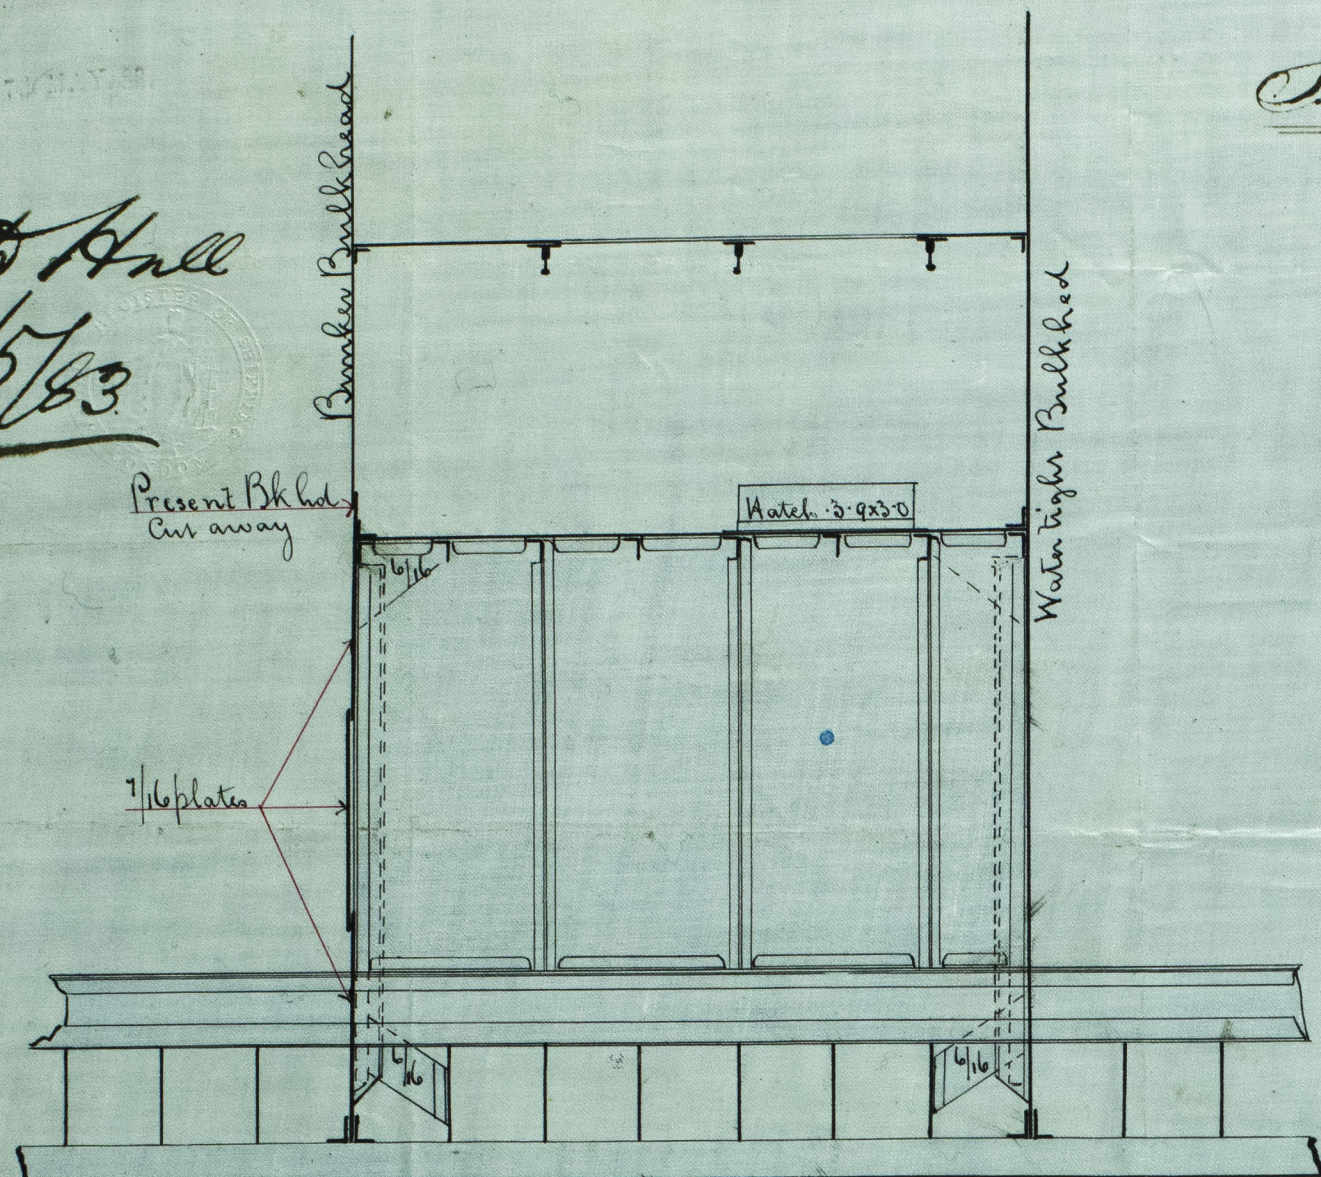

**S.S. ST MARK**  
260'0" x 34'0" x 23'6"

**Plans**  
Showing Arrangement  
of Proposed  
Water Ballast Tank in Midships

Scale 1/4" = 1 foot.

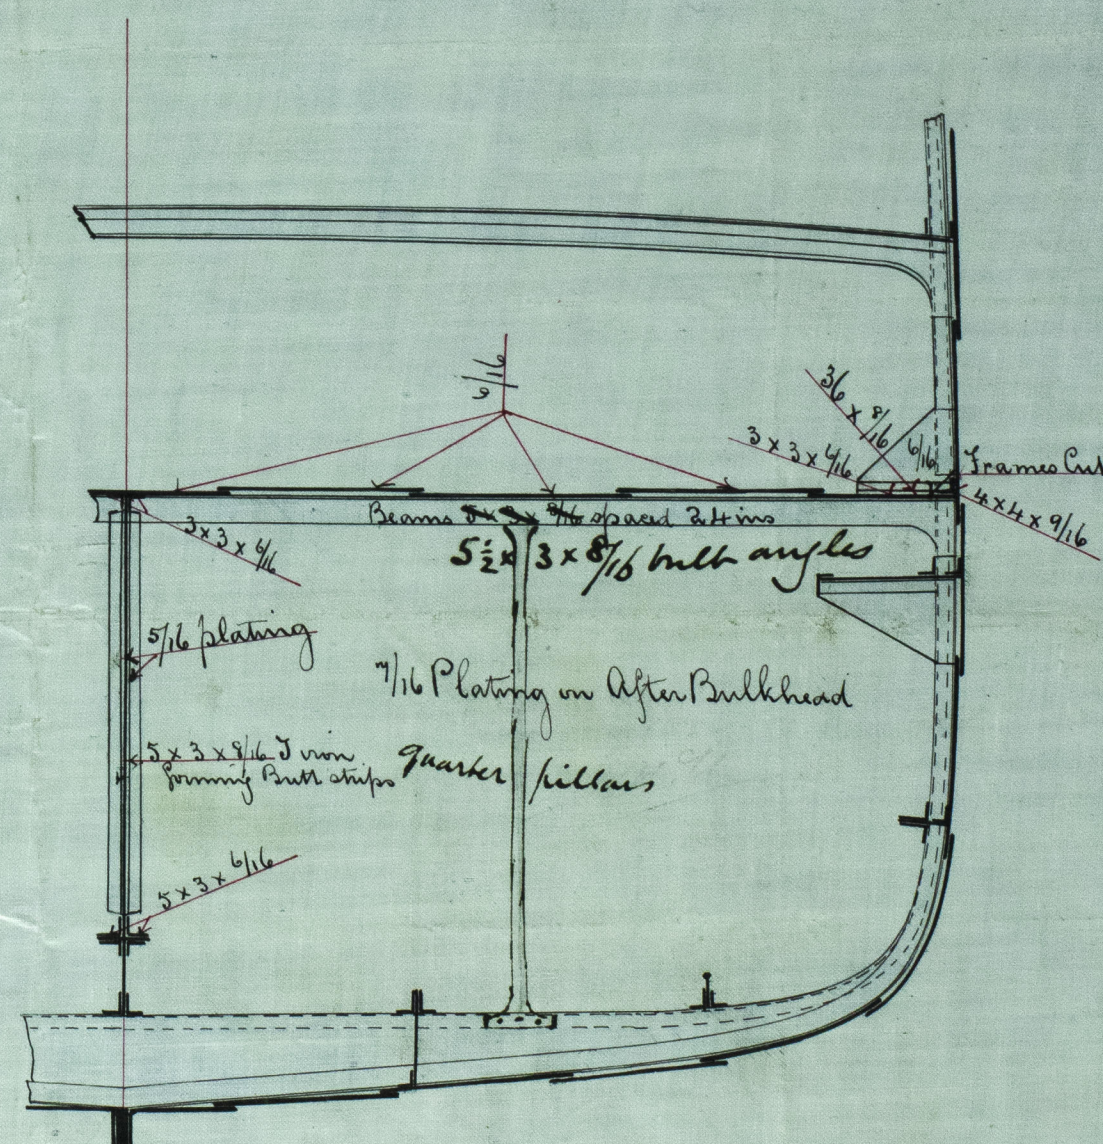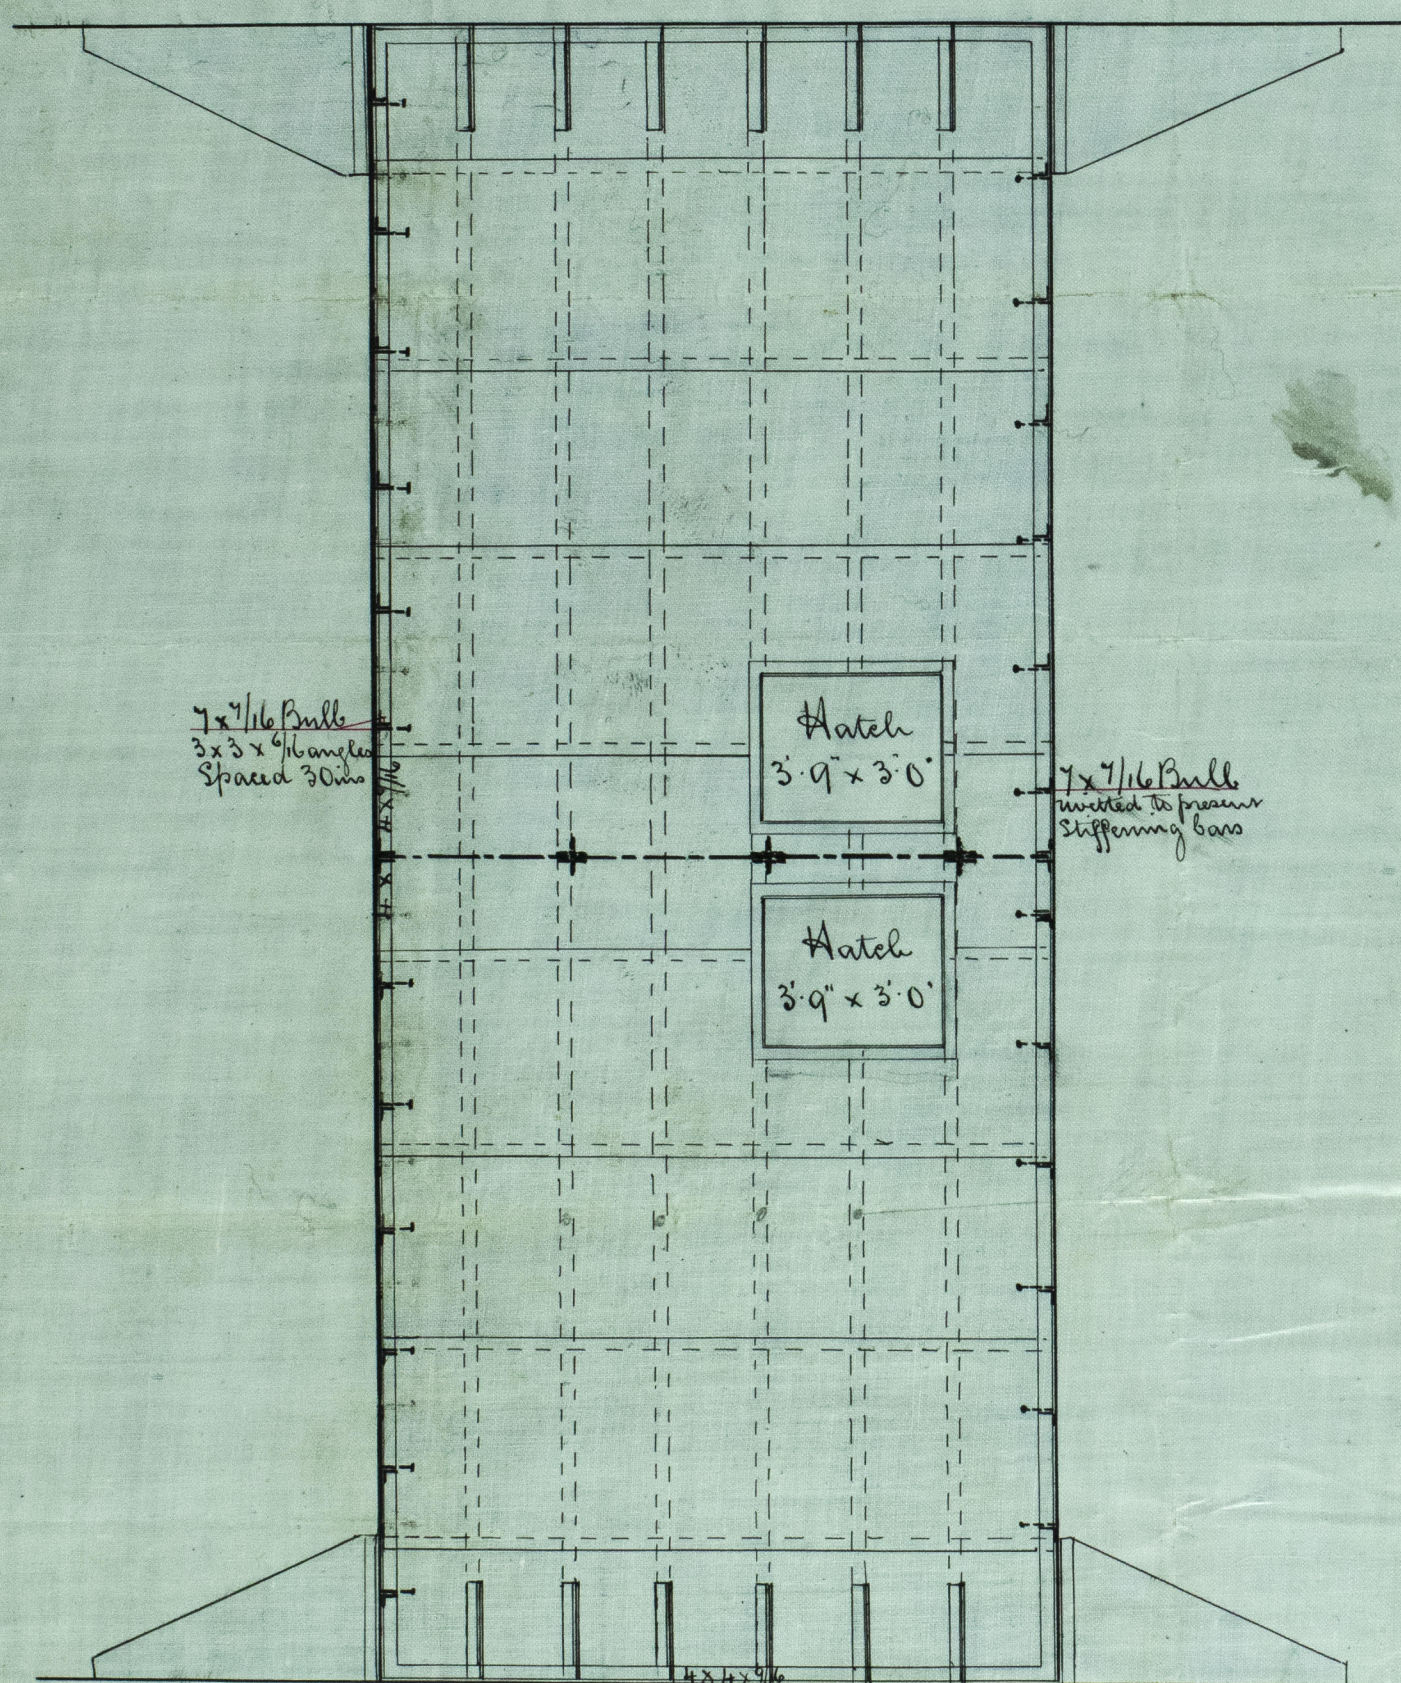

147  
7/5/83



© 2020  
Lloyd's Register  
Foundation

HULL 396-0041