




Lt. A. Hull.
7/5/83.



S.S. 'S^T MARK' Hull Report No: 5330

PLANS of PROPOSED ALTERATIONS.

SCALE 1/4" = 1 FOOT

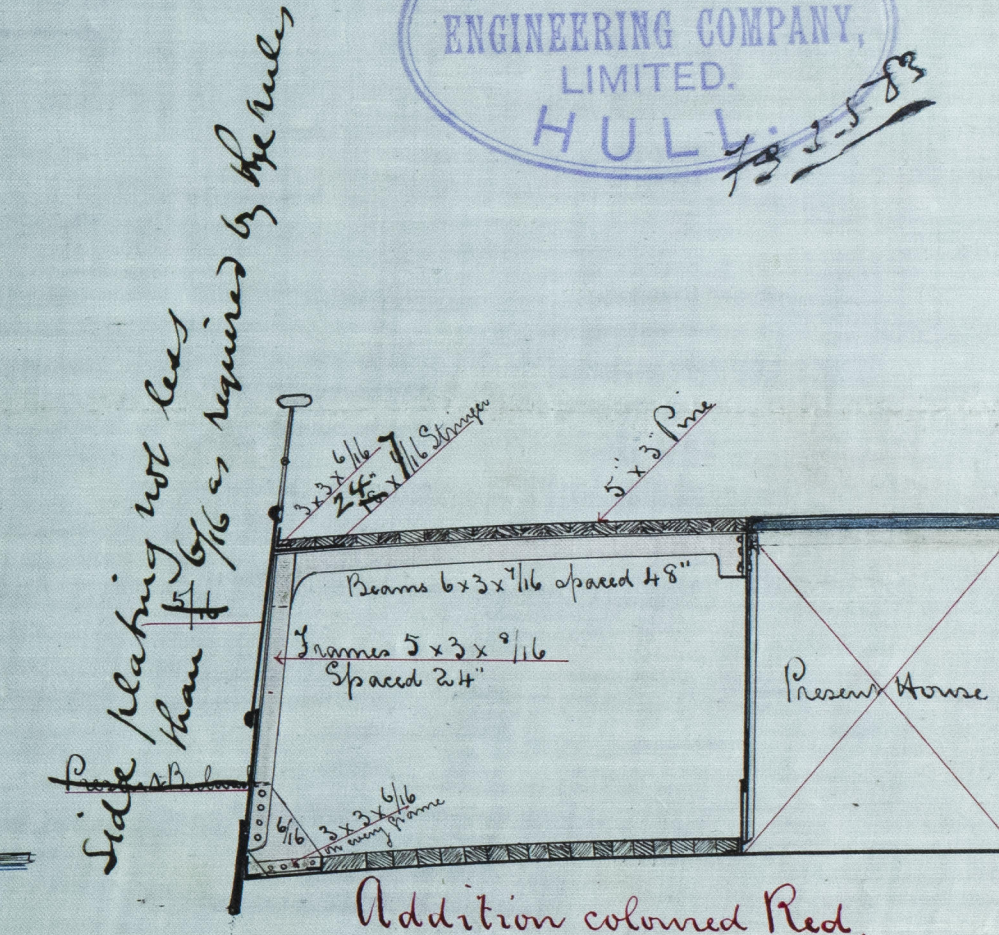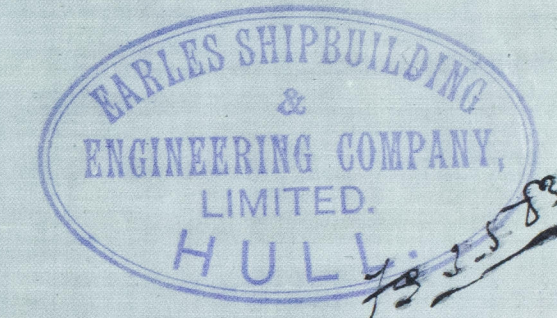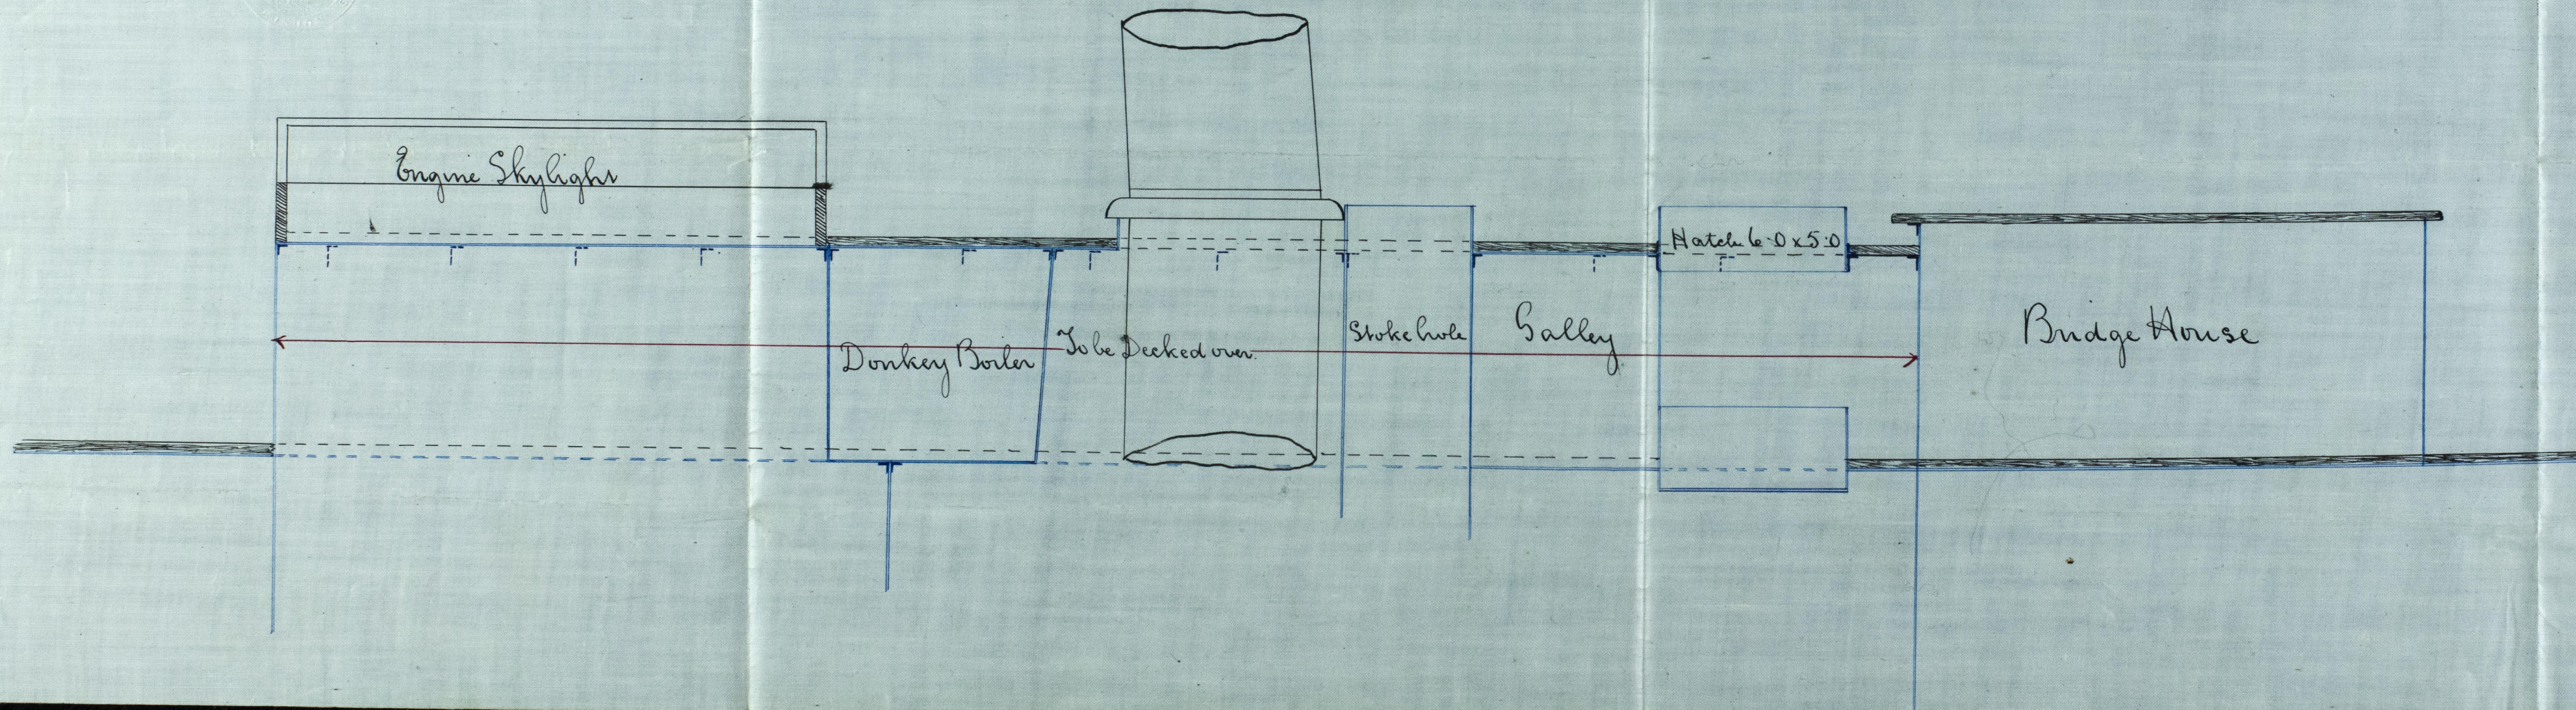

J.H.
7/5/83



© 2020

Lloyd's Register
 Foundation

HUL346-0062