RECEIVED 1st J[illegible] 82.

S.S. Bass Rock. Hull Report No 5331.
" " "Bell Rock" " " 5359*

# S.S. Nos 3 & 4

## Plan Showing Girder Connections and Tank Side Plate in Engine Space

Scale 1/4" = One foot

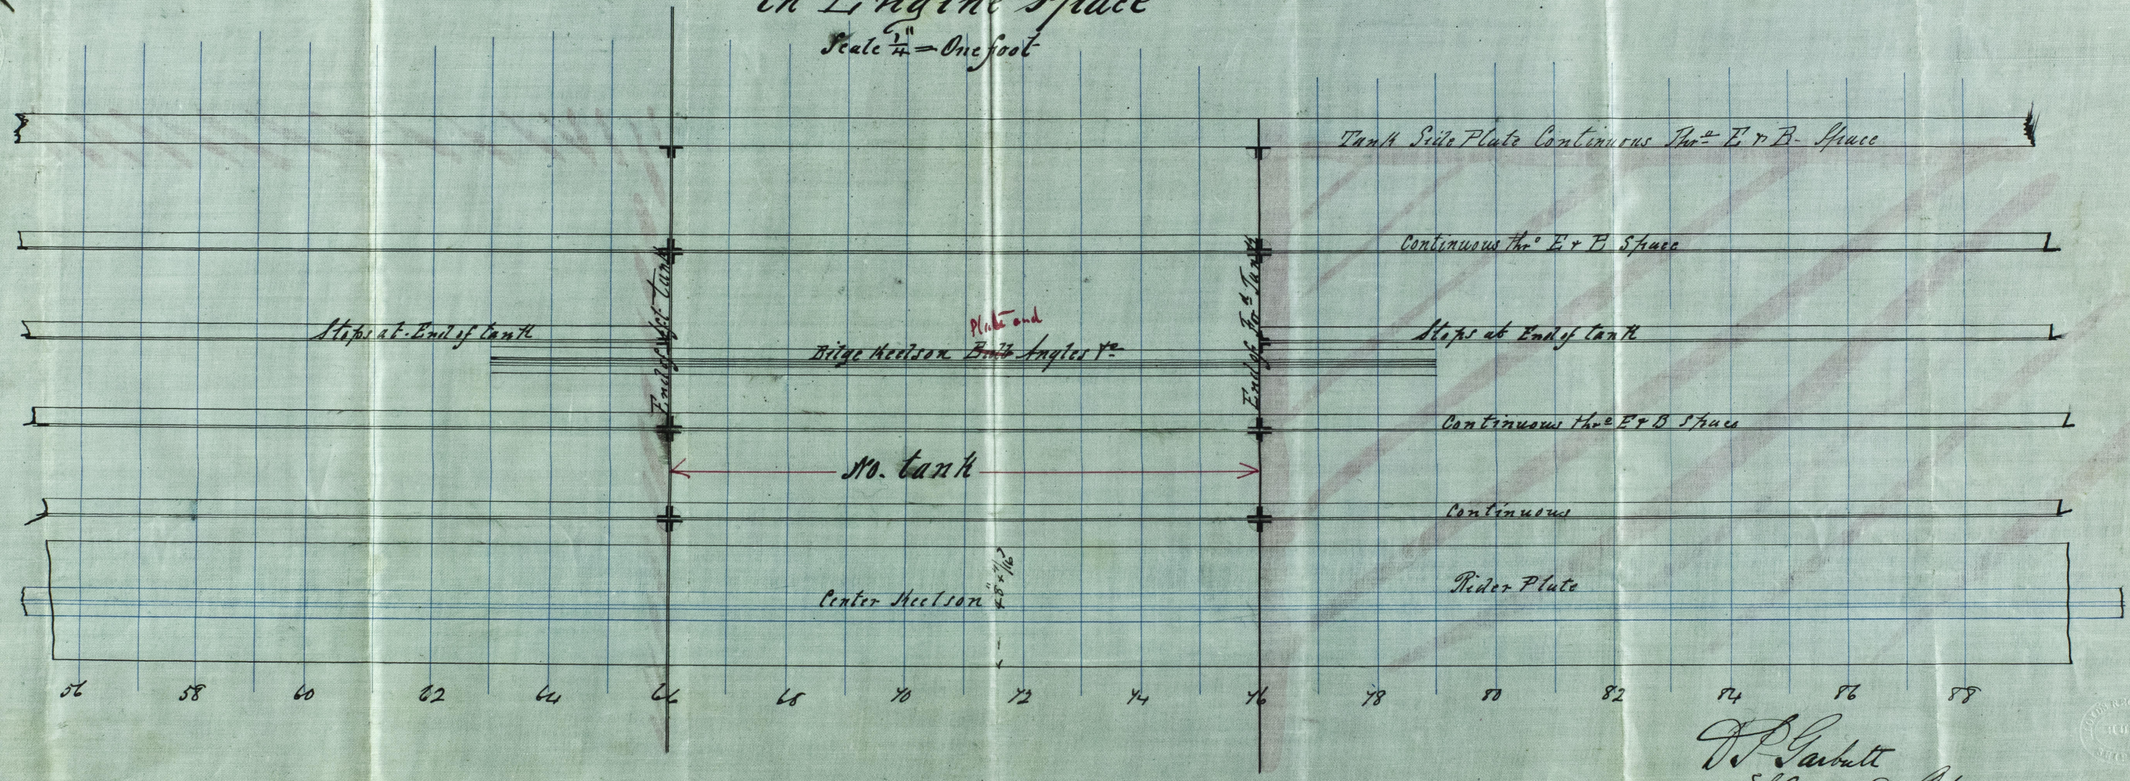


D. P. Garbutt
Engineer & Shipbuilder
Hull May 27th 1882

HUL396-0097
© 2020 Lloyd's Register Foundation