

RECEIVED 21. OCT. 82.

S.S. "Bass Rock"  
" "Bell Rock"




Hull Report No. 5331  
" " 5359\*

No. 4

Arrangement of Main Deck Beams  
as at present in No. 3. Ship

Proposed Arrangement of Main Deck Beam  
1 on every frame

Ltr. to Hull  
21/10/82.

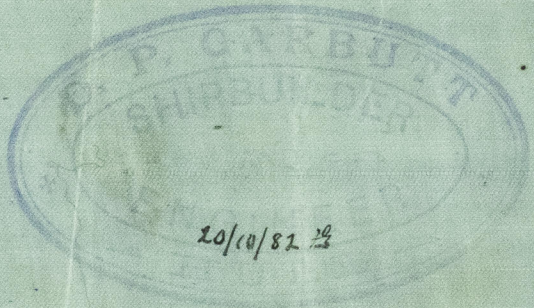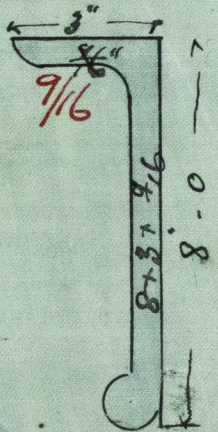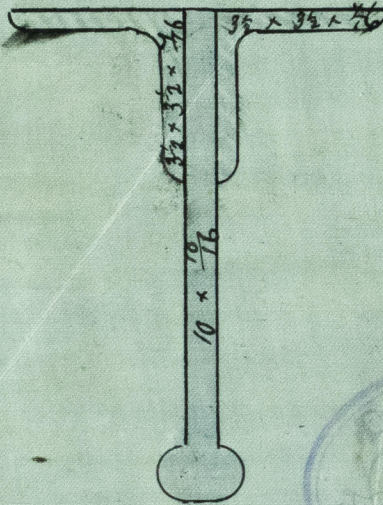

J.P.  
21/10/82



© 2020

Lloyd's Register  
Foundation