


S.S. "St. Thome" Hull No 5369.
 "Cabo Verde" " 5390.

- Nos 261 & 262. -

- ARRANGEMENT OF BULKHEADS, BEAMS, PILLARS, WEB FRAMES, &c -

- Scale 1/8" = One foot -

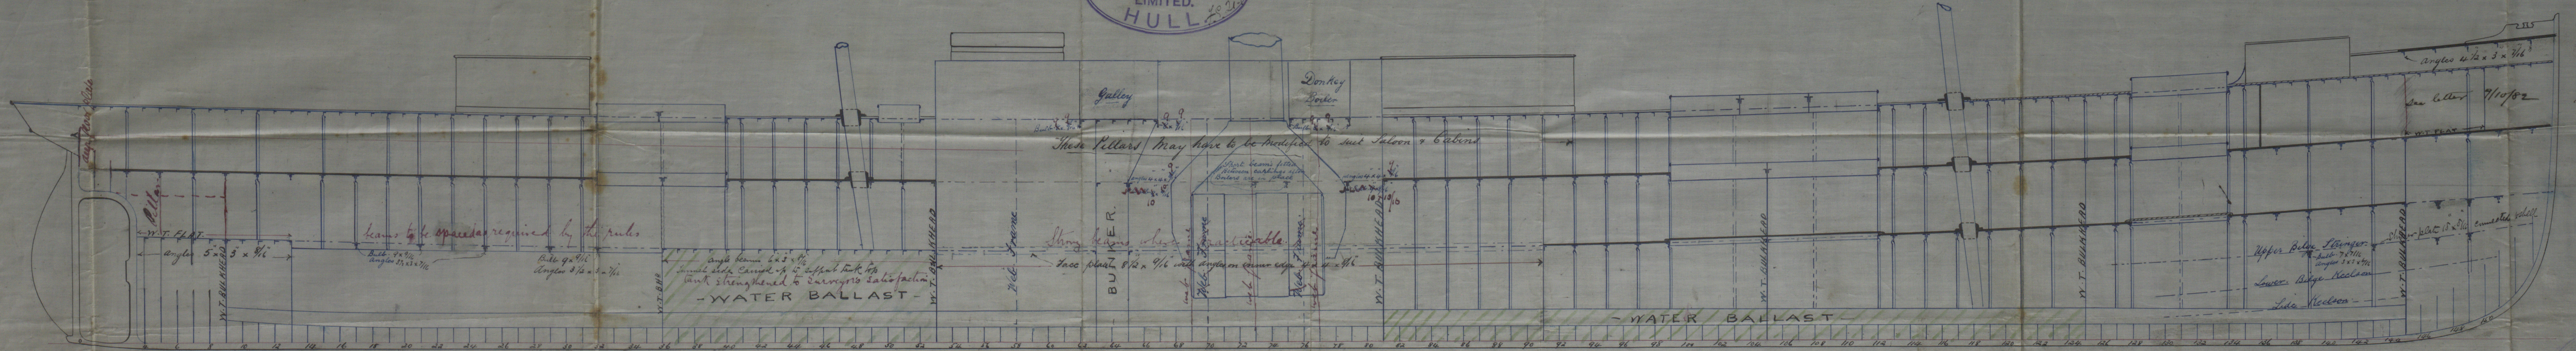

Charles Shipbuilding
 29/9/02
 10/10/02