

S. S. "Rosario"

Hull Report No 5425


Lt. D. Hull

11/9/83

- No 26 -

Sketch showing riveting of Seam strip of Centre Plate on Tank top
Scale $\frac{1}{4}$ " = One foot.

Proposed Seam Strip on top as shown in Red.

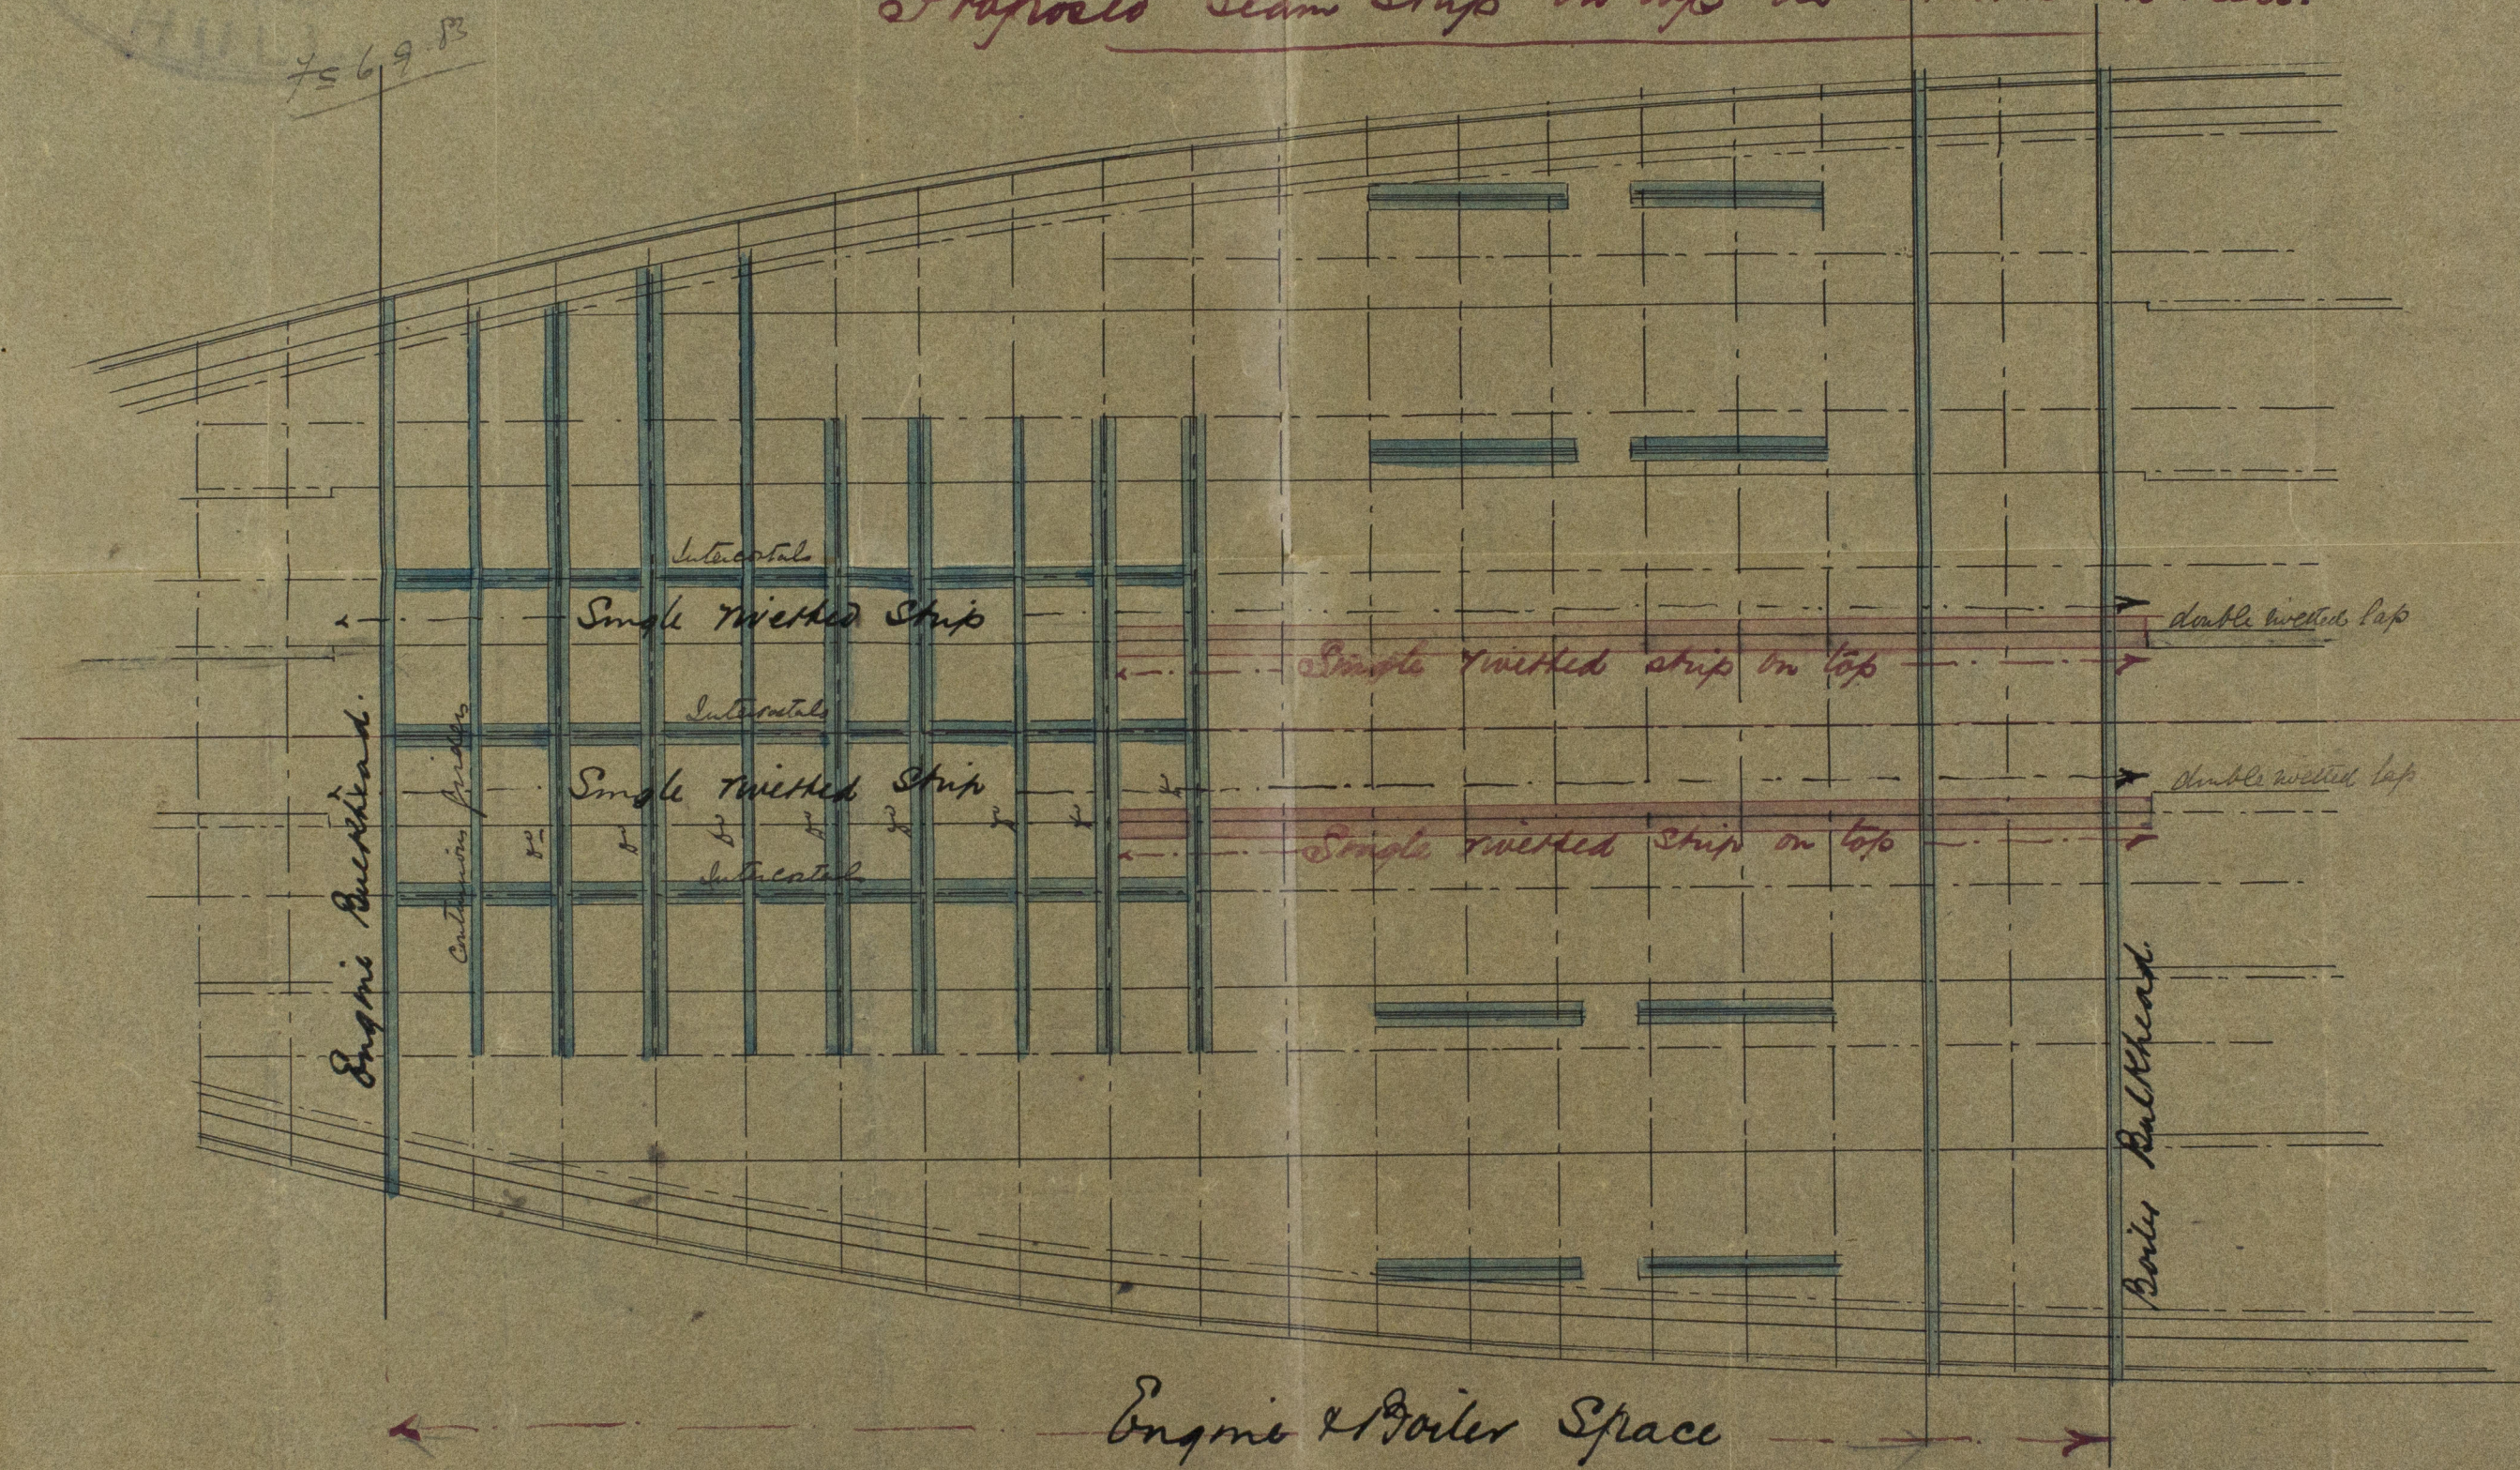

11/9/83

12/9/83



© 2020

Lloyd's Register
Foundation