


S. S. "Rosario" Hull Repat No 5425.

- No 264 - Steel -

Amended Sketch showing Arrangement of Beams, Bulkheads &c.

- Scale 1/8" = One Foot -

Dr. to Hall
6/3/83

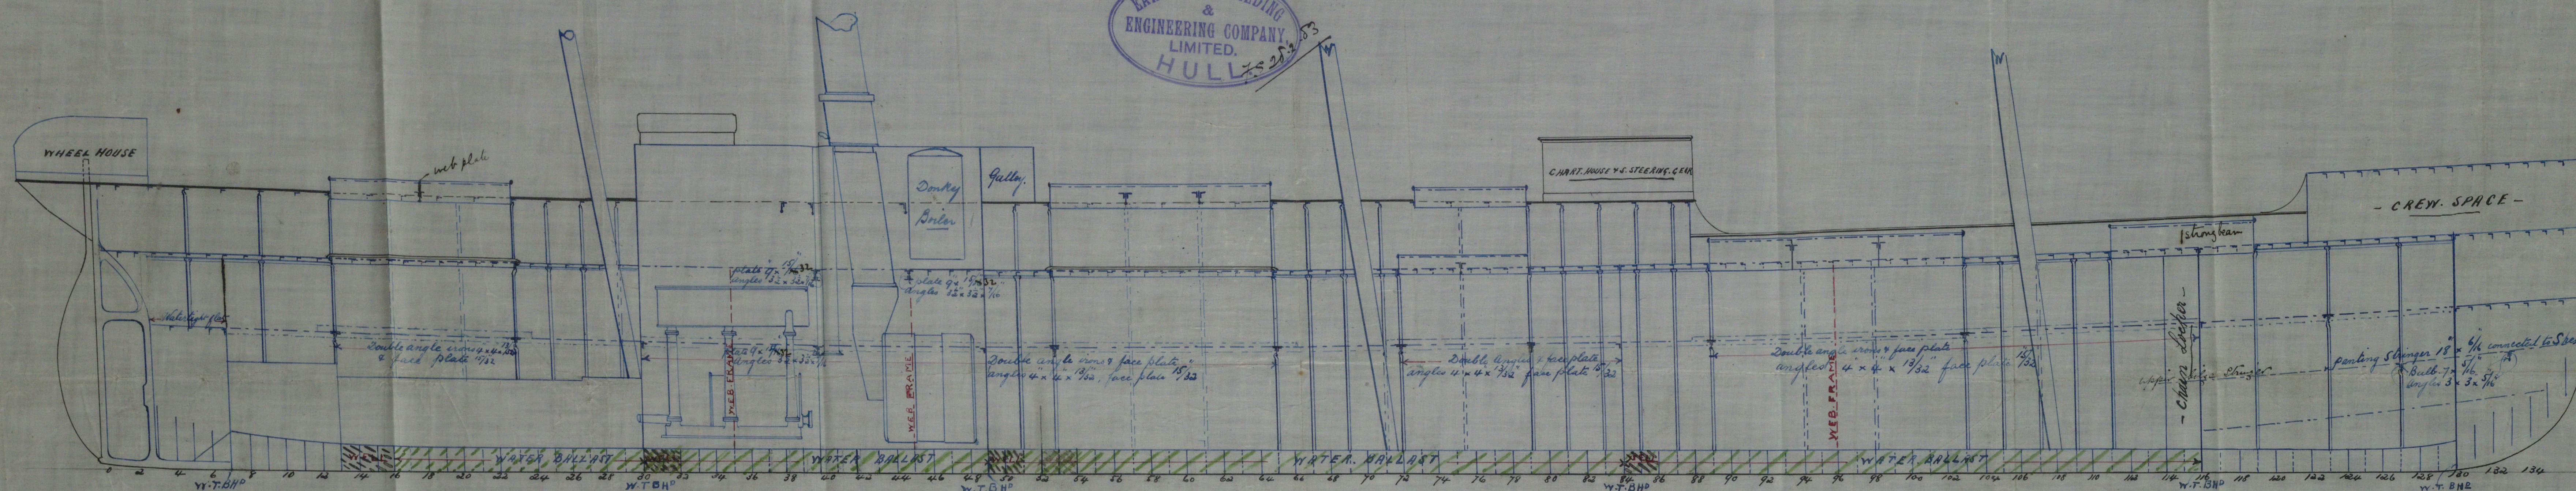

17/6
5/3/83


Letter 7/3/83

- No 264 - Steel -

- Sketch showing Arrangement of Beams, Bulkheads &c.

- Scale 1/8" = One Foot -

Dr. to Hall
12/2/83
6/3/83

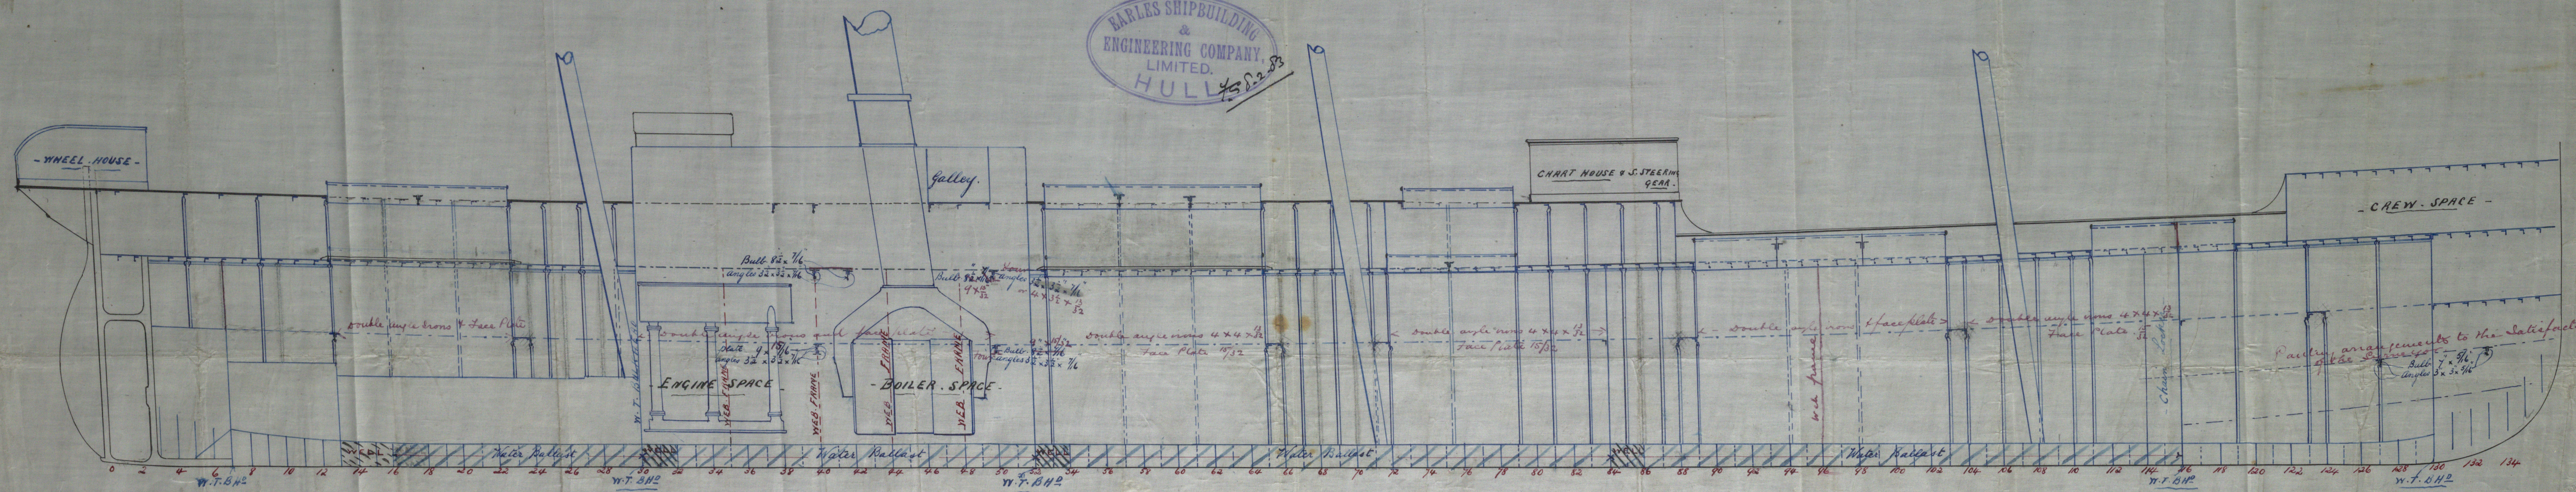

17/6
12/2/83

Letter 12/2/83