

S.S. "Butch" Hull Report No. 5562

BOILER No 4

Plates, Rivets & Stays steel. Tubes wrought iron.

Working pressure 100 lbs.

Scale 1 inch = 1 Foot.



DIMENSIONS

LENGTH OF FIRE BARS
AREA OF FIRE GRATE
DIAM OF TUBES OUTSIDE 3"
LENGTH OF TUBES	between plates 6'-0"
NO OF TUBES 248
SURFACE OF TUBES 1356 sq. ft.
TOTAL HEATING SURFACE 1600 "
WORKING PRESSURE 100 lbs. am
DIAM OF SAFETY VALVE



1/16" steel rivets 1" diam holes
all holes drilled

Butt Straps	inside	outside
A	11/16"	9/16"
B	9/16"	11/16"
C	11/16"	9/16"

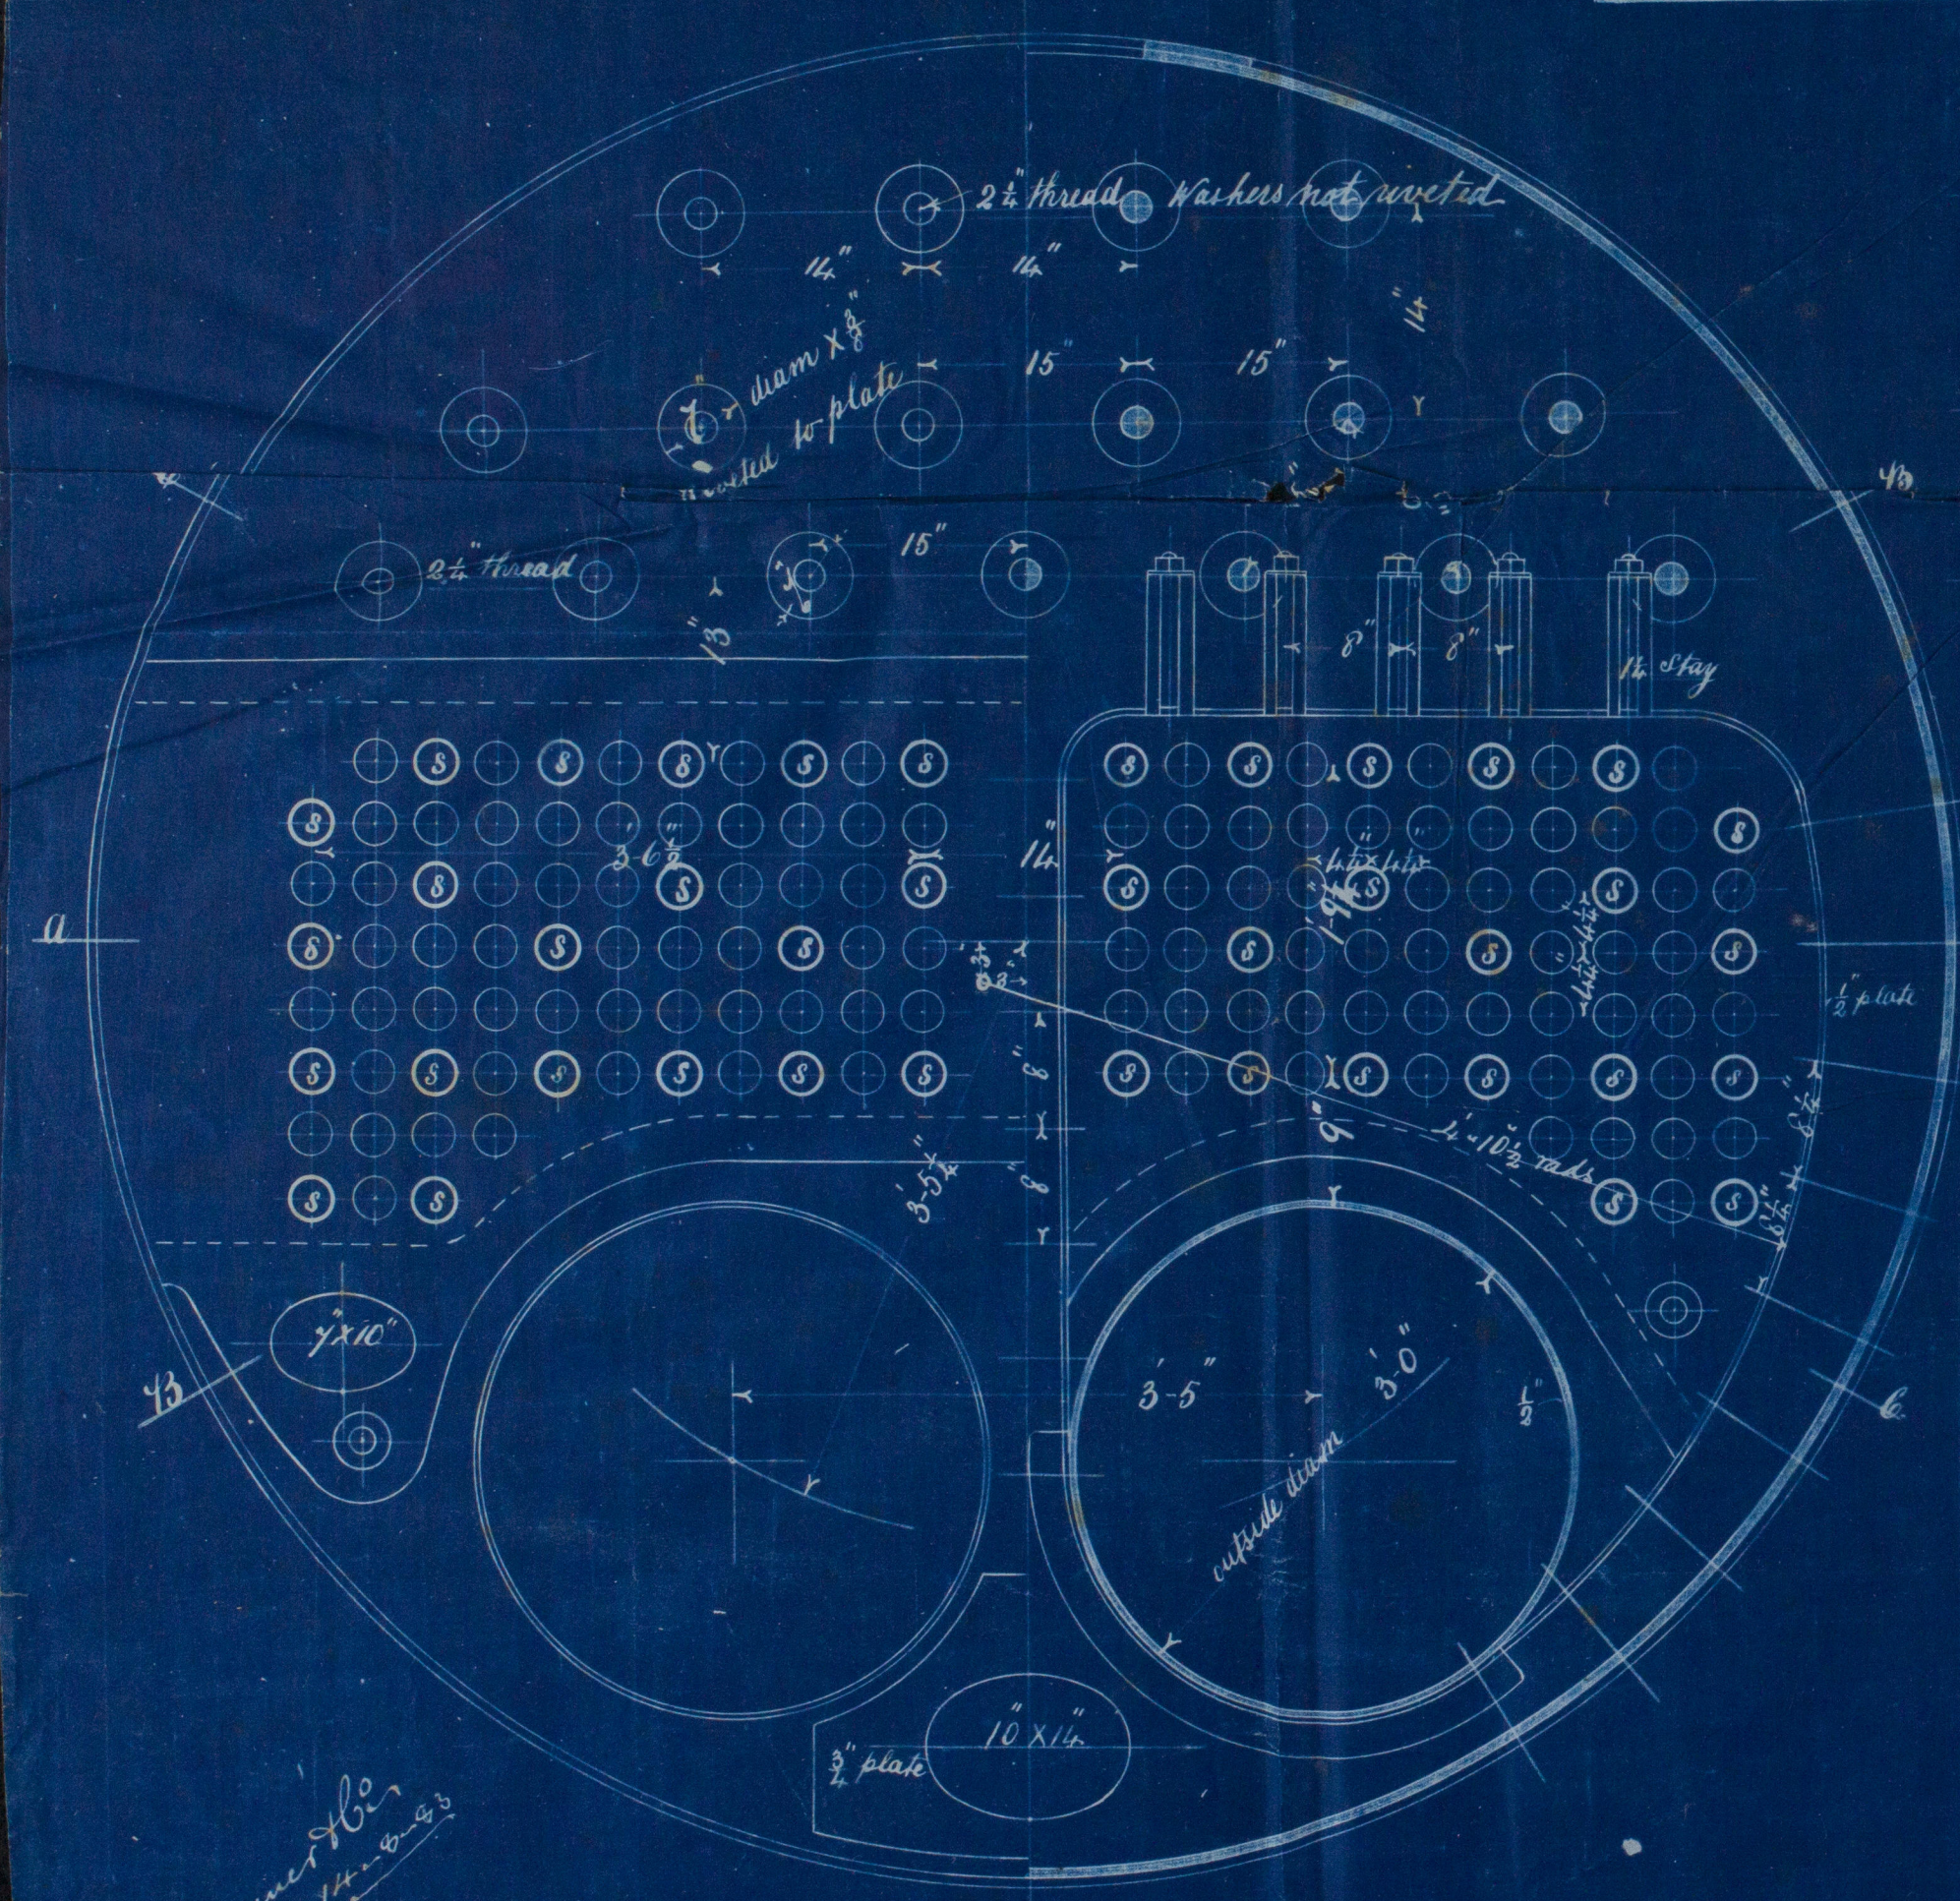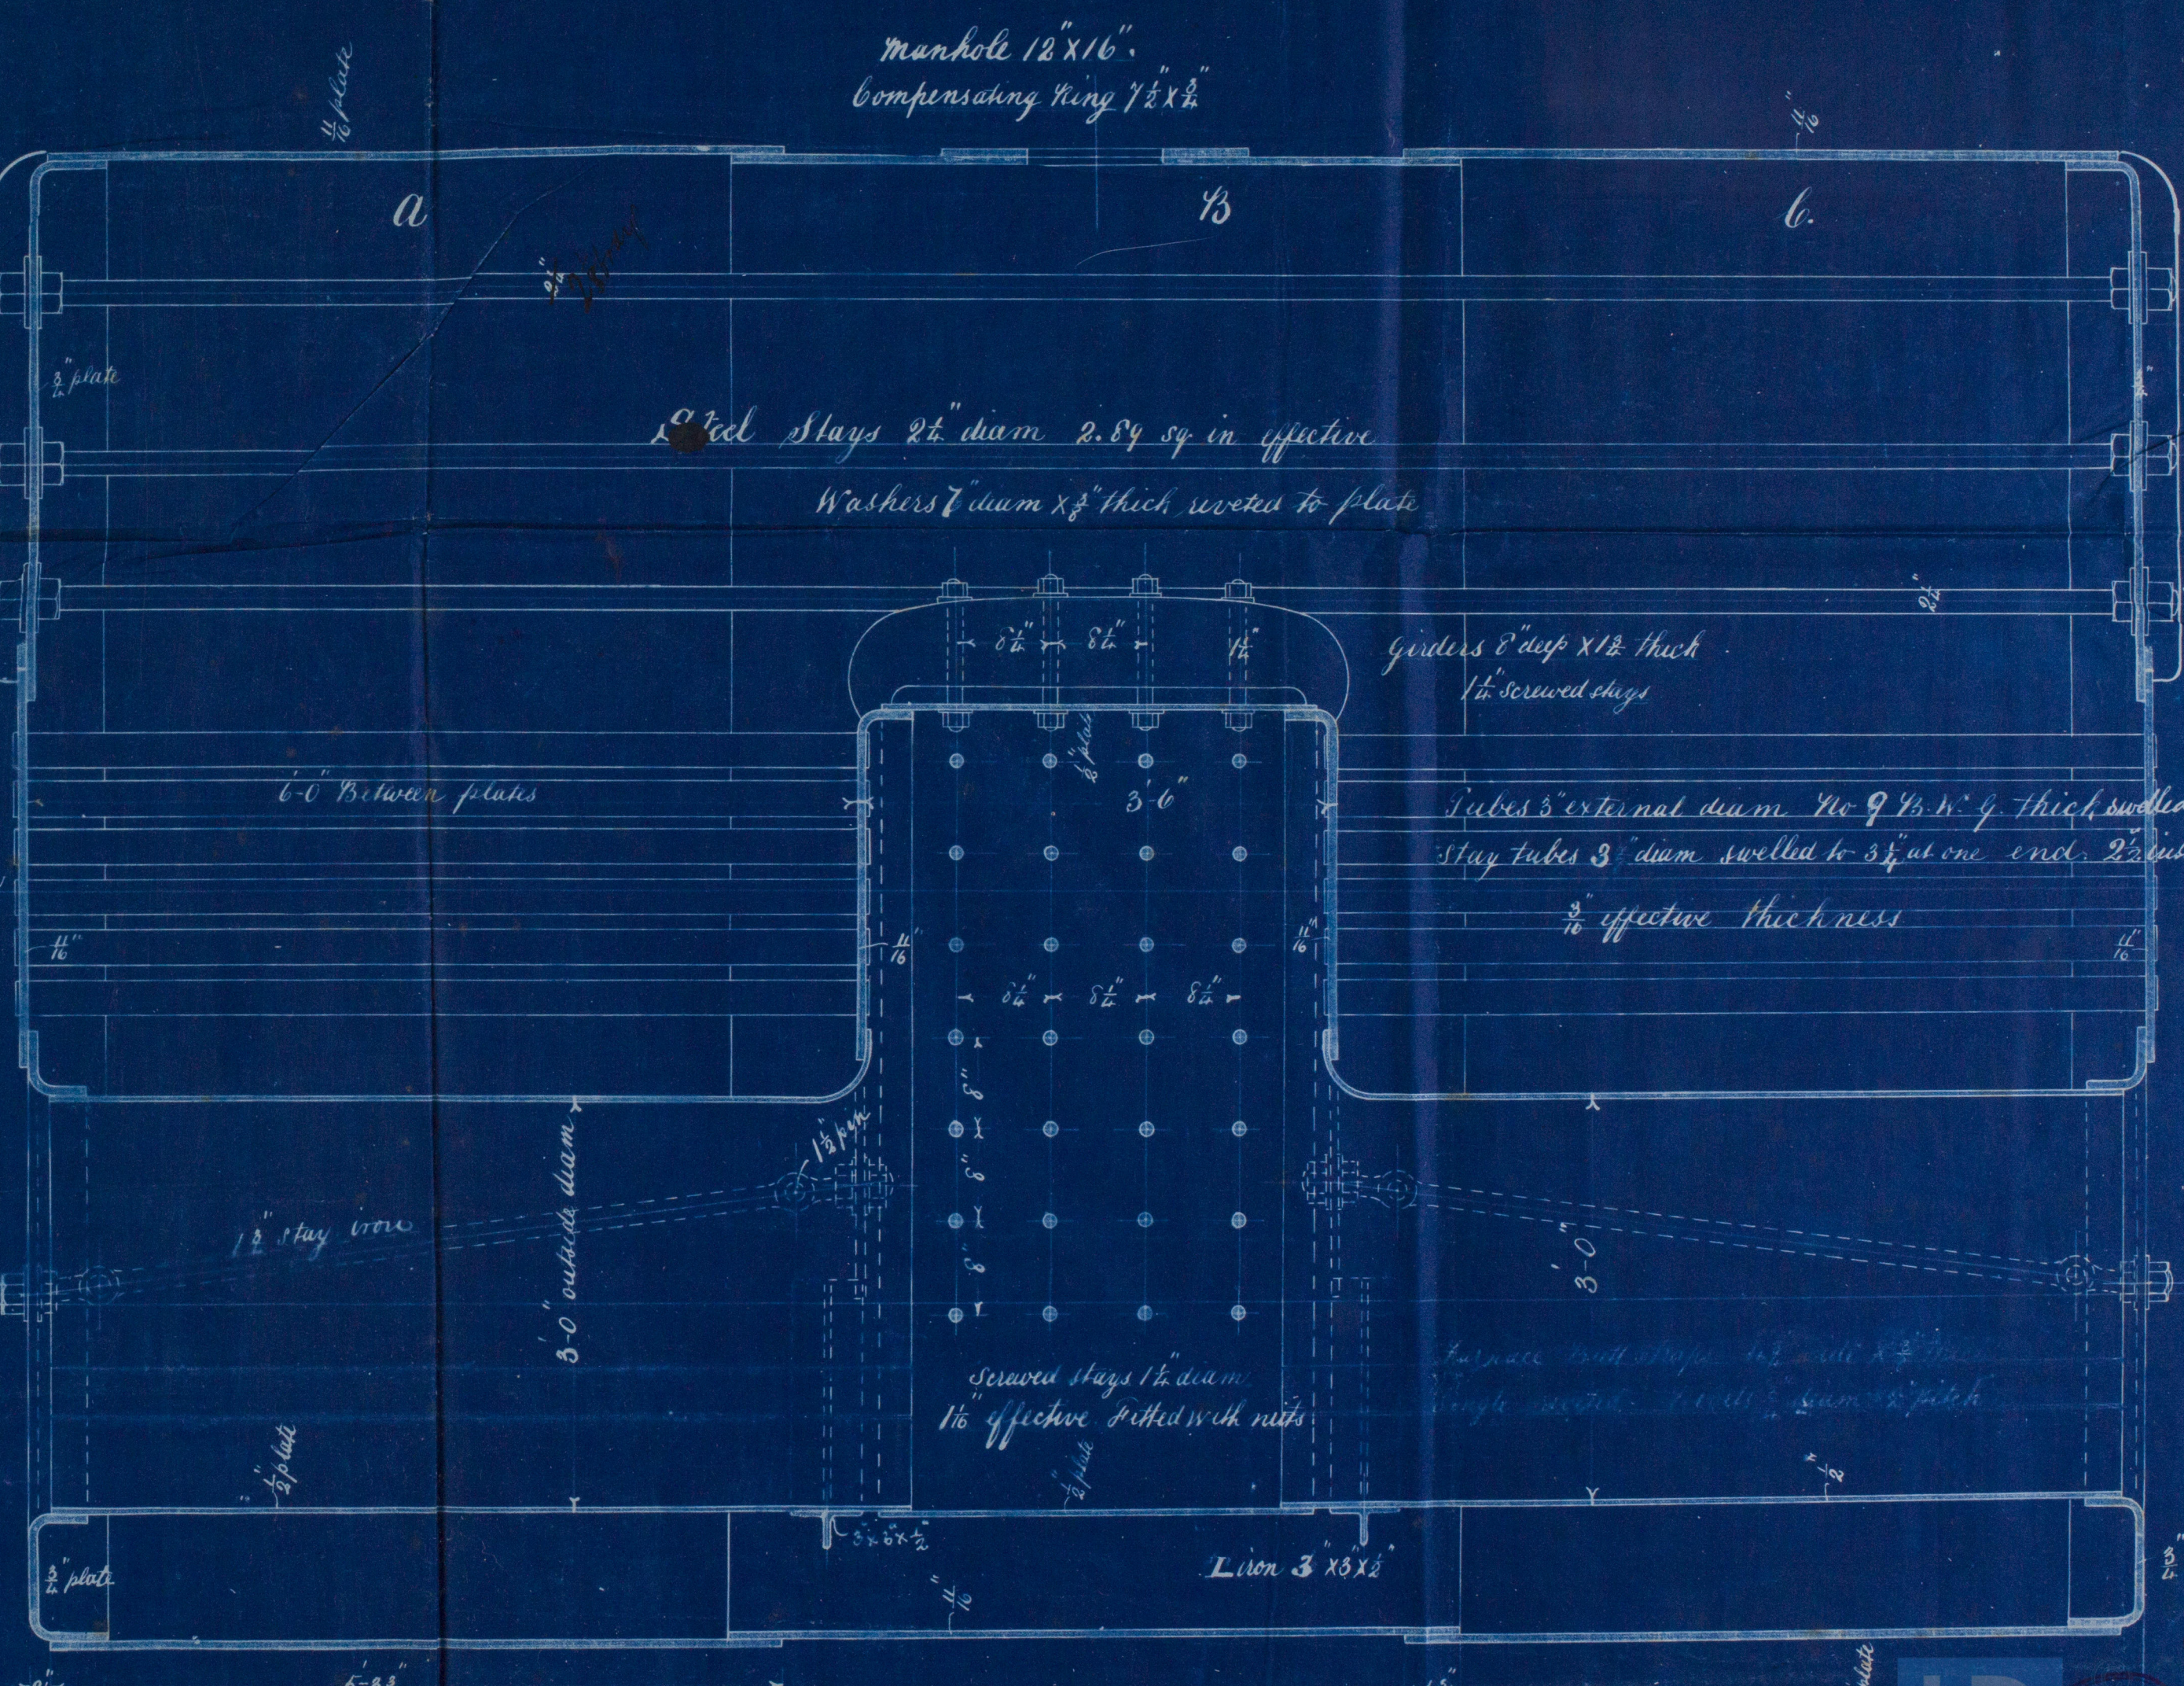

Wagner & Co
14-15-16-17-18

10'-8 1/2" diam Meas.



1222 : 1444 1111 "1111" 1111

11 MAR 84
LONDON

LOYD'S REGISTER OF SHIPPING
HULL

