

RECEIVED TO N.E.R.

W. L. Hull
8/31/83

Shell Riveting
Plate 7/8 thick Rivets 1 1/8 dia
4 1/2 pitch Plate 7/8
Rivets 1 1/8 dia

S. S. "Paradox" - Hull No. 56 1/5

BOILER N°81


Working Pressure 80 lbs

Scale 1" = 1 Foot

Holes in longitudinal seams
drilled after caulking before bending
Holes in circumferential seams
bored before bending

L. Scott
Goble
Jan 1883
Feb 21 1883

Manhole 16 x 13 on ring B
Circumferential ring 7/8 x 1/8
double riveted with 7/8 rivets

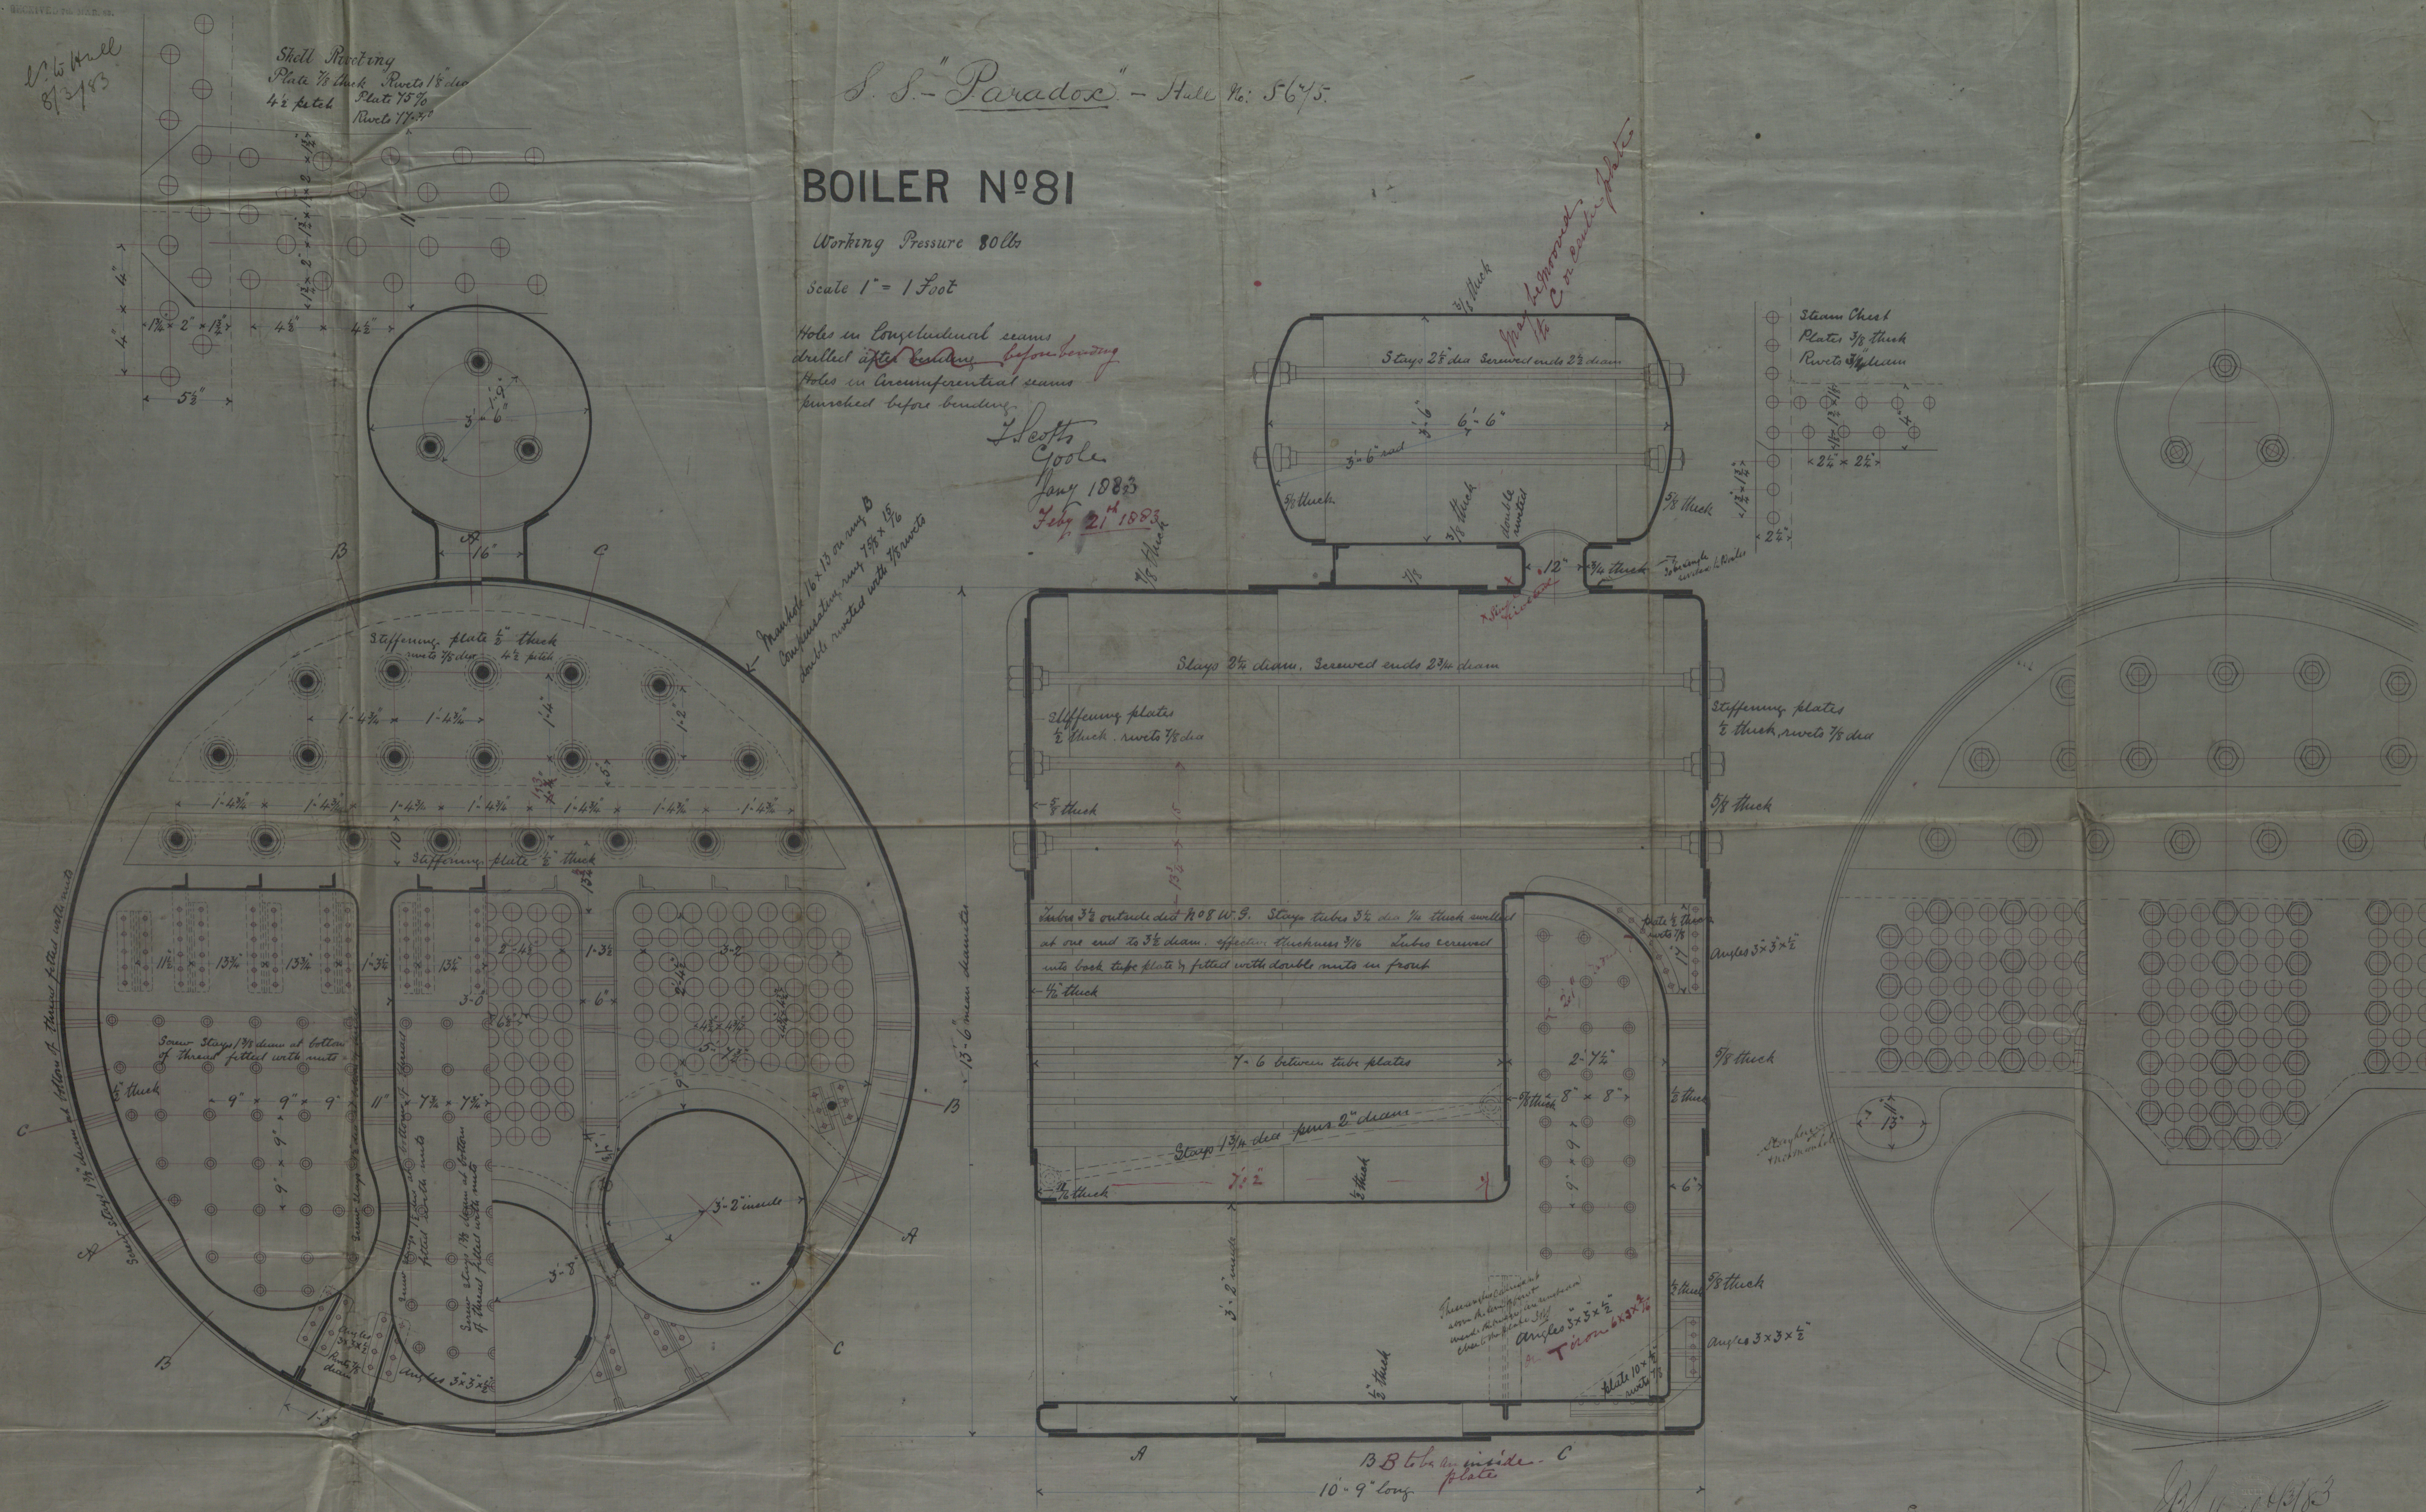

D.S.
3/3/83

W. L. Hull 4/3/83

