

Amended  
— Midship Section —  
S. S. "Farrington" Hull No: 5-7,7.  
— Scale —

— Scale  $\frac{1}{2}$  = 1 ft —

Dr. to Hull.  
7.2.88.

— No 285 —

Dimensions per rule 135.9 x 21.5 x 12.4 Class 100 A Iron

$\frac{1}{2}$  Girth 19.6  
 $\frac{1}{2}$  Breadth 10.75  
 Depth 12.4  

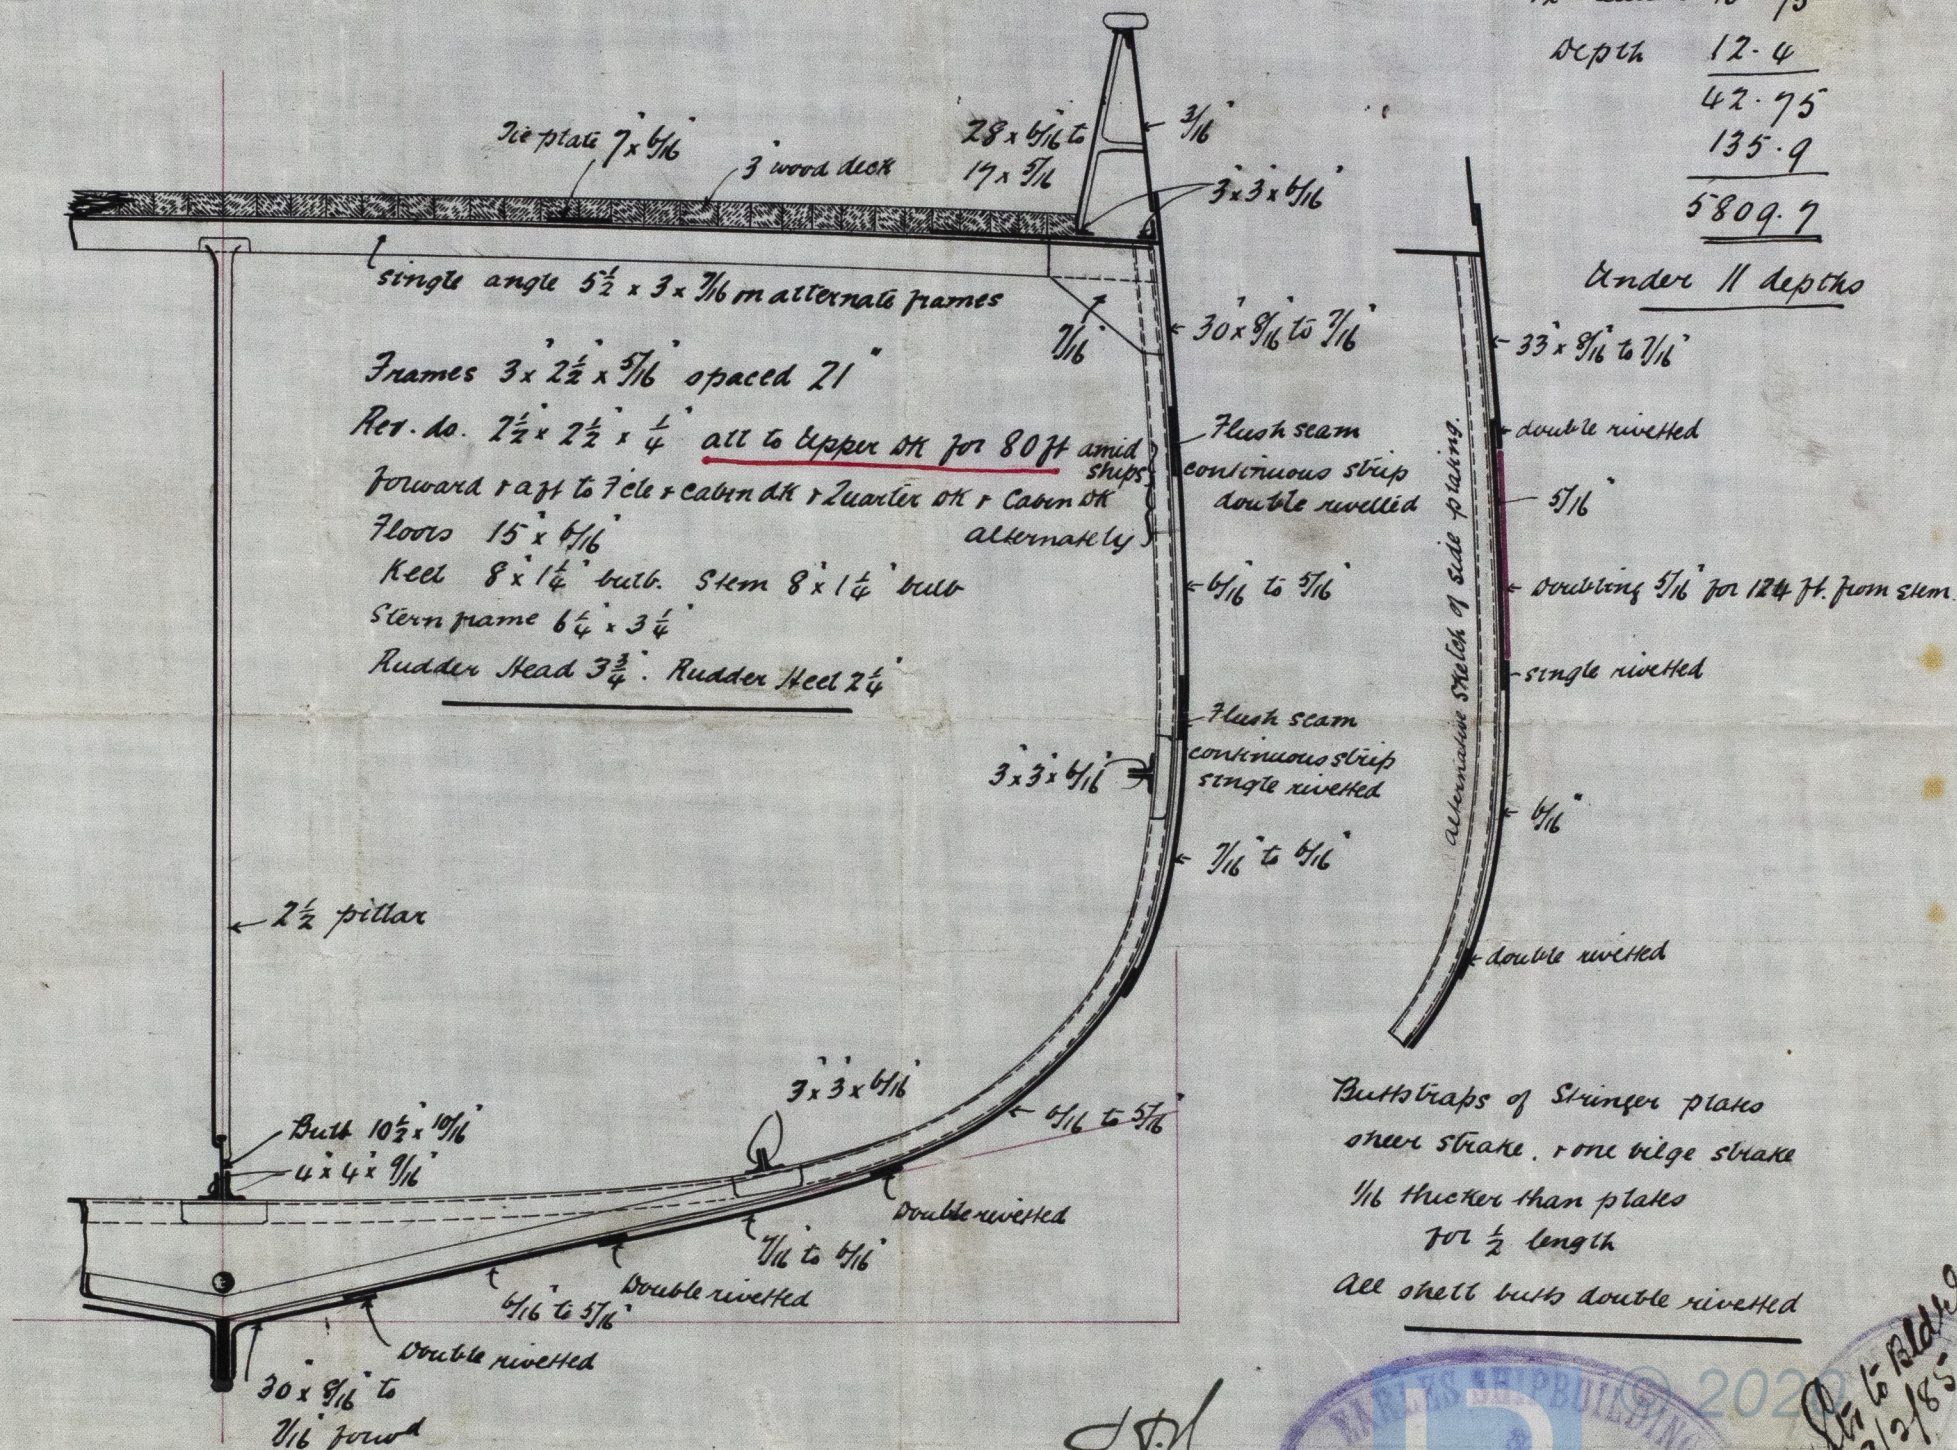

---

 42.75  
 135.9  


---

 5809.7

Under 11 depths



Buttstraps of Stringer planks  
over strake, one bilge strake  
 $\frac{1}{16}$  thicker than planks  
for  $\frac{1}{2}$  length  
All shell butts double rivetted

7/2/85

HUL 397-0264

St. to Bldg 3  
9/2/85.

© 2022 Lloyd's Register Foundation