Screw Steamer "Flamingo" Hull No. 54/1/4

# STEEL BOILER

# No. 285

WORKING PRESSURE **140 LBS**

SCALE 1 INCH = 1 FOOT

EARLES SHIPBUILDING & ENGINEERING COMPANY LIMITED HULL

29-1-85

The plates & rivets to be of Siemens Martin Steel. All rivet holes in shell & furnaces to be drilled in place after bending the plates. All punched or flanged plates to be annealed after punching or flanging. The screw stays are 1 7/16 & 1 1/8 effective diat screwed into place & nutted at each end. The tubes are iron. The stay tubes are 3 1/4 inside diat & 7/16 effective thickness. The ordinary tubes are 8 B.W.G. thick. A manhole in shell fitted with shorter axis longitudinally. A doubling plate 2'-4" x 2'-0" x 15/16 fitted around it.

## DIMENSIONS

| | |
|---|---|
| LENGTH OF FIRE BARS | 5'-6" |
| AREA OF FIRE GRATE in sq feet | 36 |
| DIAM OF TUBES OUTSIDE | 3 1/4" |
| LENGTH OF TUBES over plates | 6'-6" |
| No OF TUBES | 169 |
| SURFACE OF TUBES in sq feet | 913 |
| TOTAL HEATING SURFACE sq ft | 1145 |
| WORKING PRESSURE in lbs | 140 |
| DIAM OF SAFETY VALVE each | 5" |

Butt Straps.

| Straps | Inside | Outside |
|---|---|---|
| A | 7/8 | 7/8 |
| B | 7/8 | 15/16 |

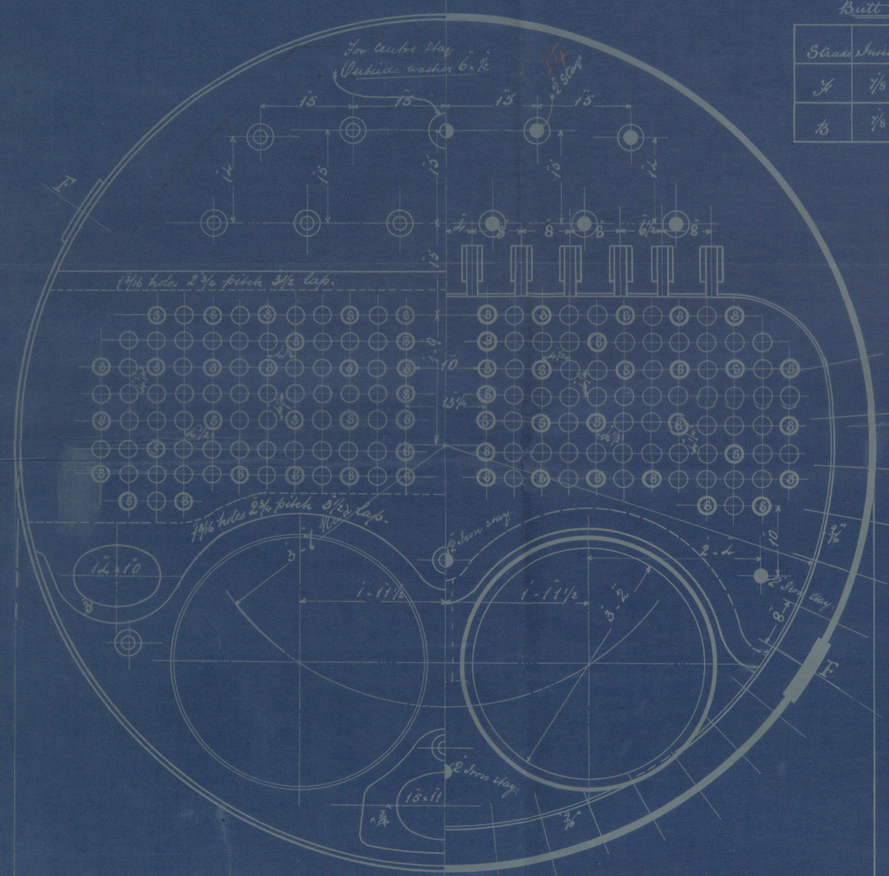


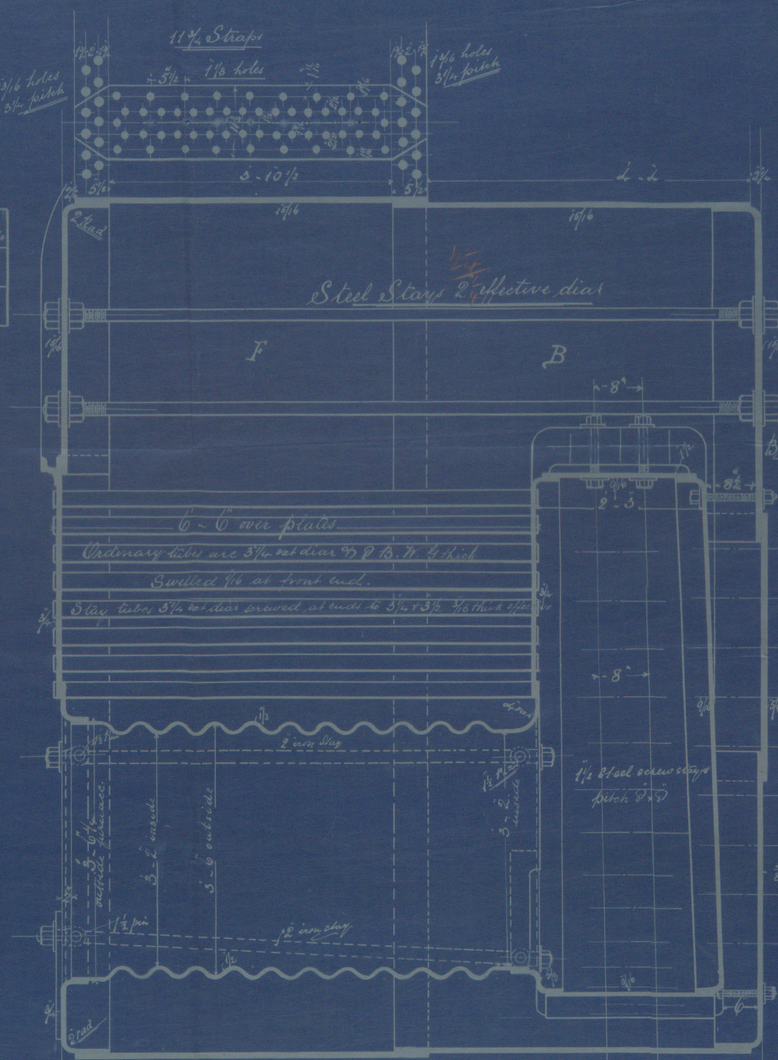


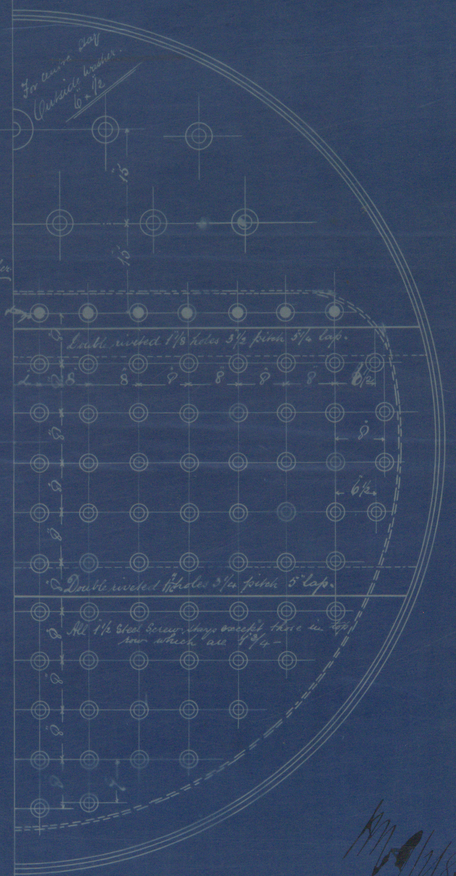


D28

No 1593 30/1/85 J.M.C.

No. 285