


— 'Edith Mary' — Hull No. 5724.

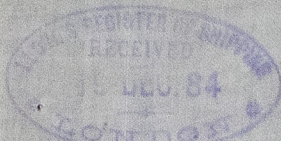

Ors to Hull.  
20.12.84  
9.2.85.

# Midship Section No 7


Iron Sailing Barquentine  
Scale 1/2" = one foot

Class 100 A. — Dimensions per Rule —

Length ----- 137.5  
Half M. Breadth ----- 12.75  
Depth Top of Keel to U.D.K. Beams - 13.66

1/2 Girth ---- 22.75  
1/2 Breadth --- 12.75  
Depth --- 13.66  
49.16 1st Number  
137.5  
6759.5 2nd Number  
Under 10 1/2 Depth  
" 7 Breadth

— Raised Q.R. Deck 28'-0" Long —

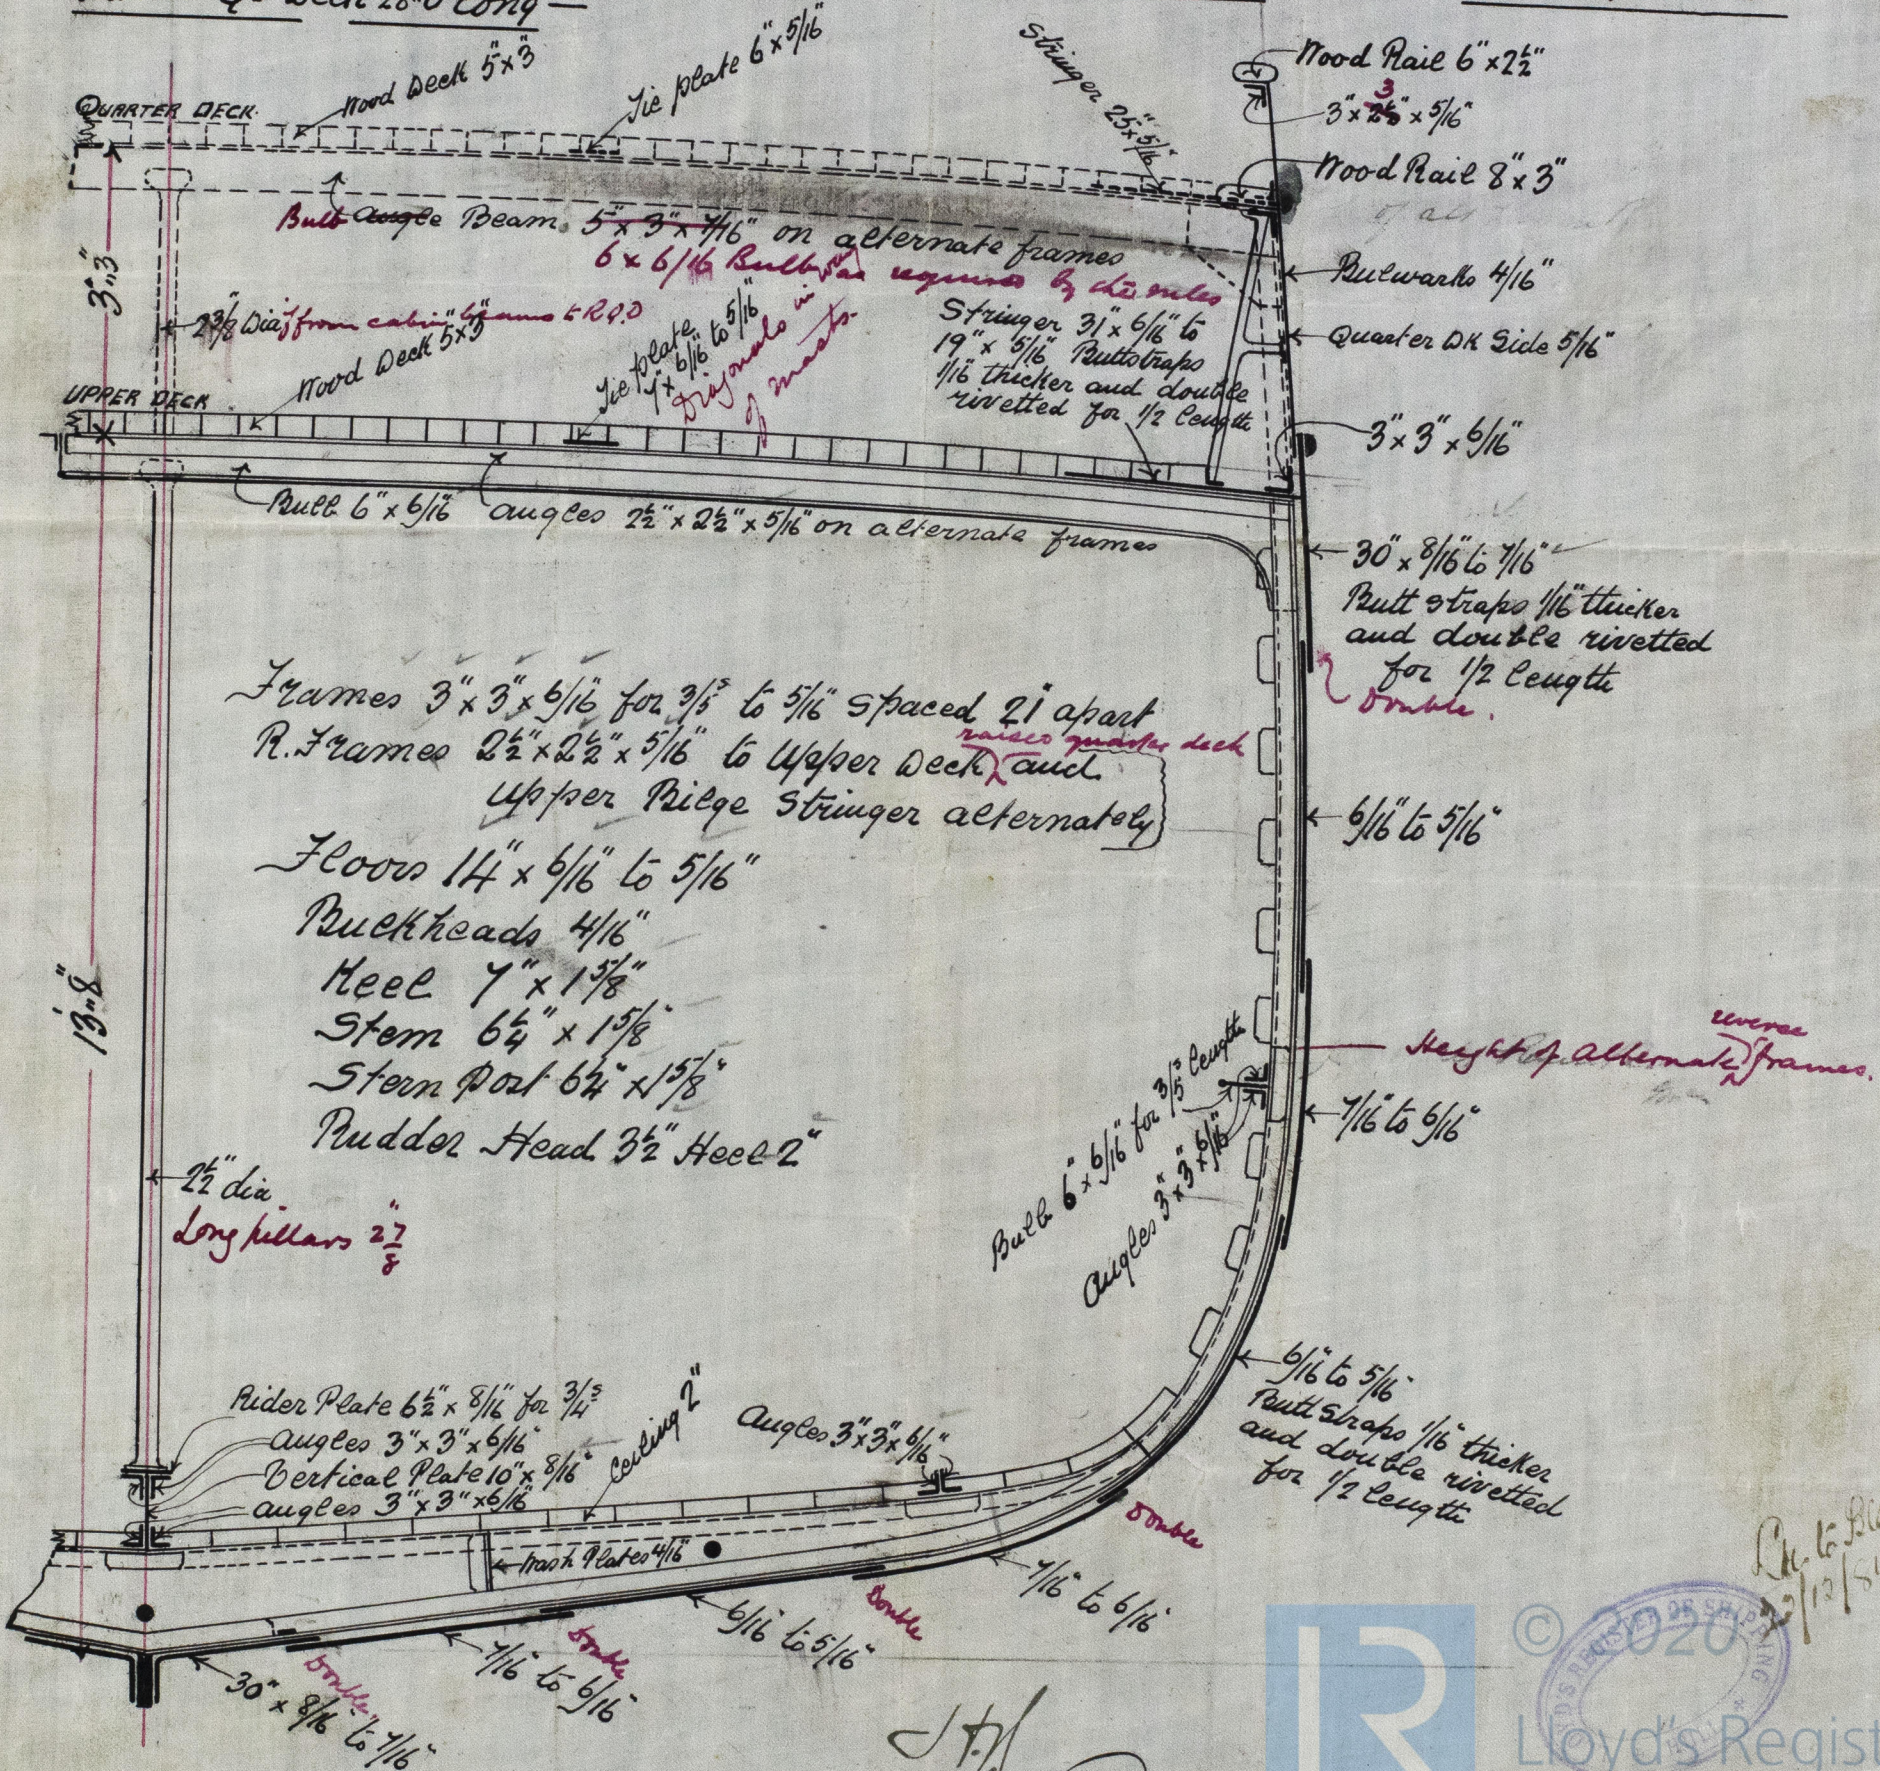

19/12/84



Lloyd's Register Foundation

HUL397-0277