



"Baish Many" - Hull to 5/24

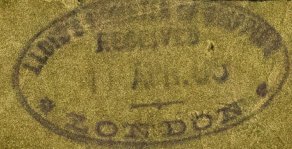

Sketch of "rigging Screw" proposed
for Messrs Cockrane & Co. Barquentine No. 4.
of Beverley, near Hull.

13. 4. 85.

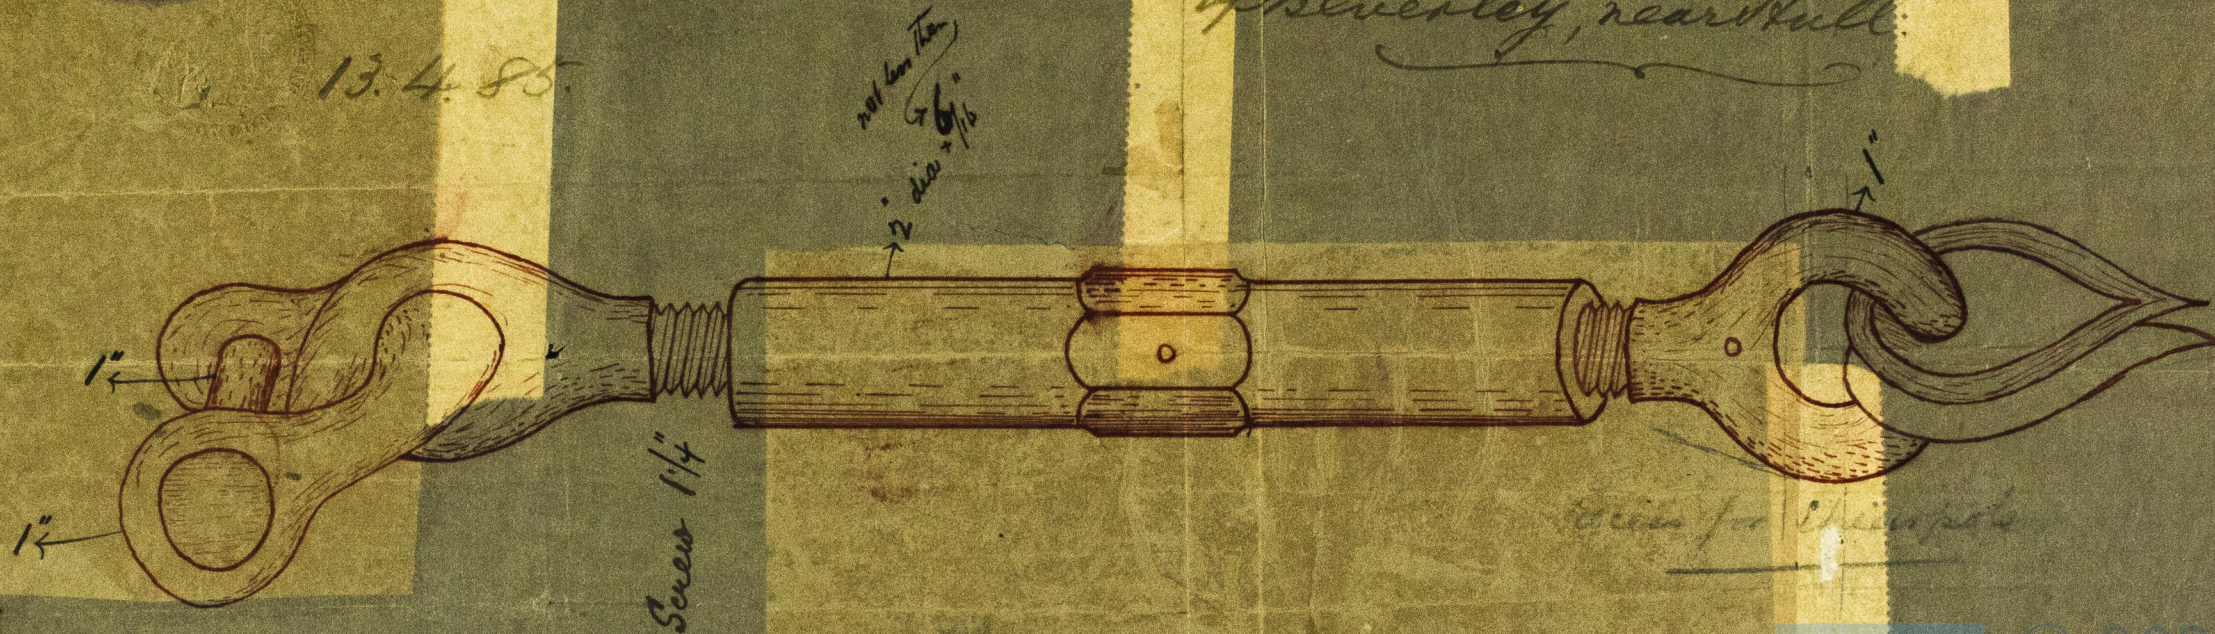

"Dia' of Screw = $1\frac{1}{4}$ "
Size " Shackle = 1"
" pin = 1"
Dia of Socket = 2"
" wire up = 3" best charcoal



© 2020
Lloyd's Register
Foundation

14/4/85.

HULL 397-0278