


Lt. H. Stull.
9.2.85.

— "Edith Mary" — Hull No: 5724
Profile showing arrangement of Beams, Buckheads, etc.
Scale $\frac{1}{8}$ " = one foot

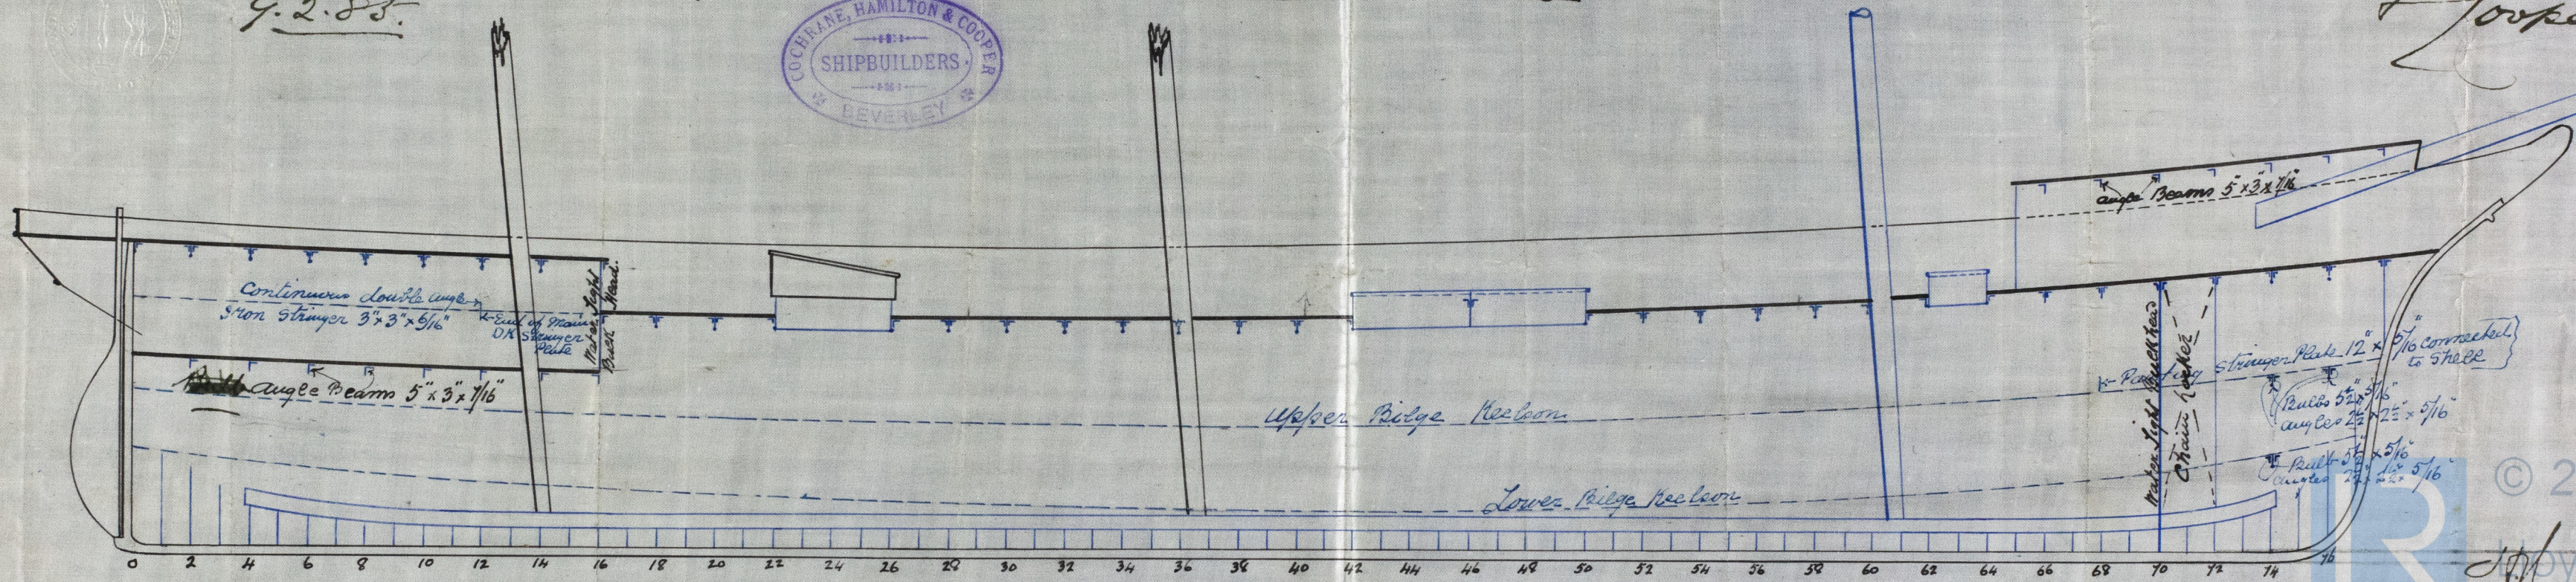

— No. 7 — by Cochrane, Hamilton
& Cooper, Beverley
near Hull.
7.5



© 2020
Str. to Plans
10/10/85
HUL397-0279