


"Edith Mary" Hull No: 5724


# FORE MAST

Seams Double Rivetted

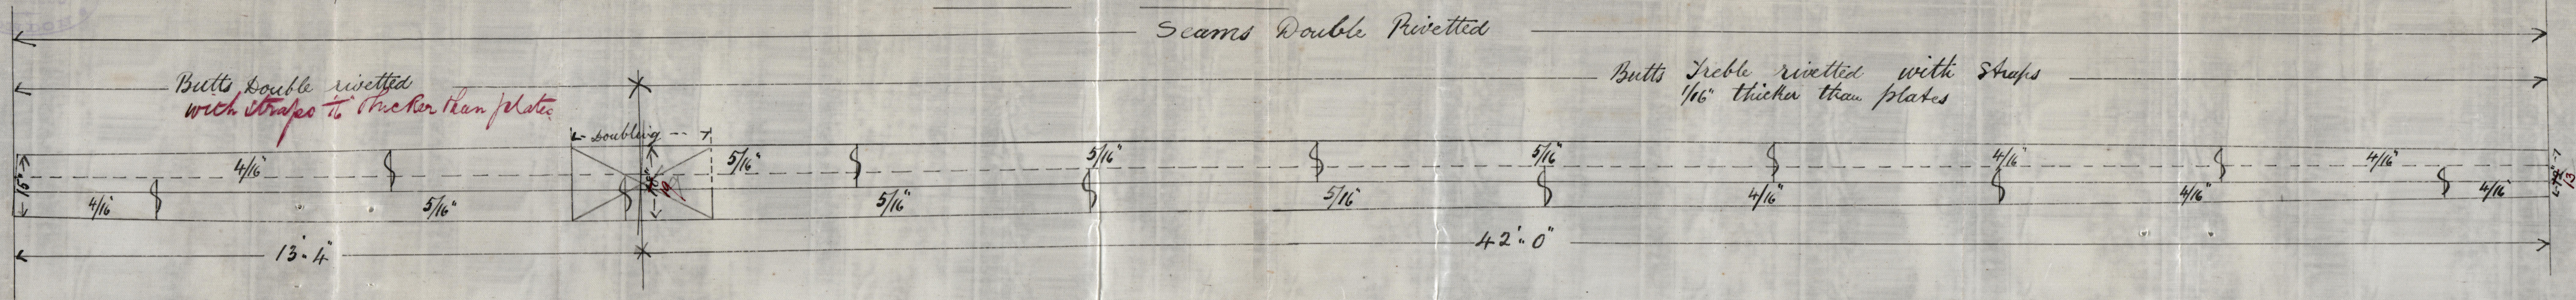

# BOWSPRIT

Seams Double Rivetted

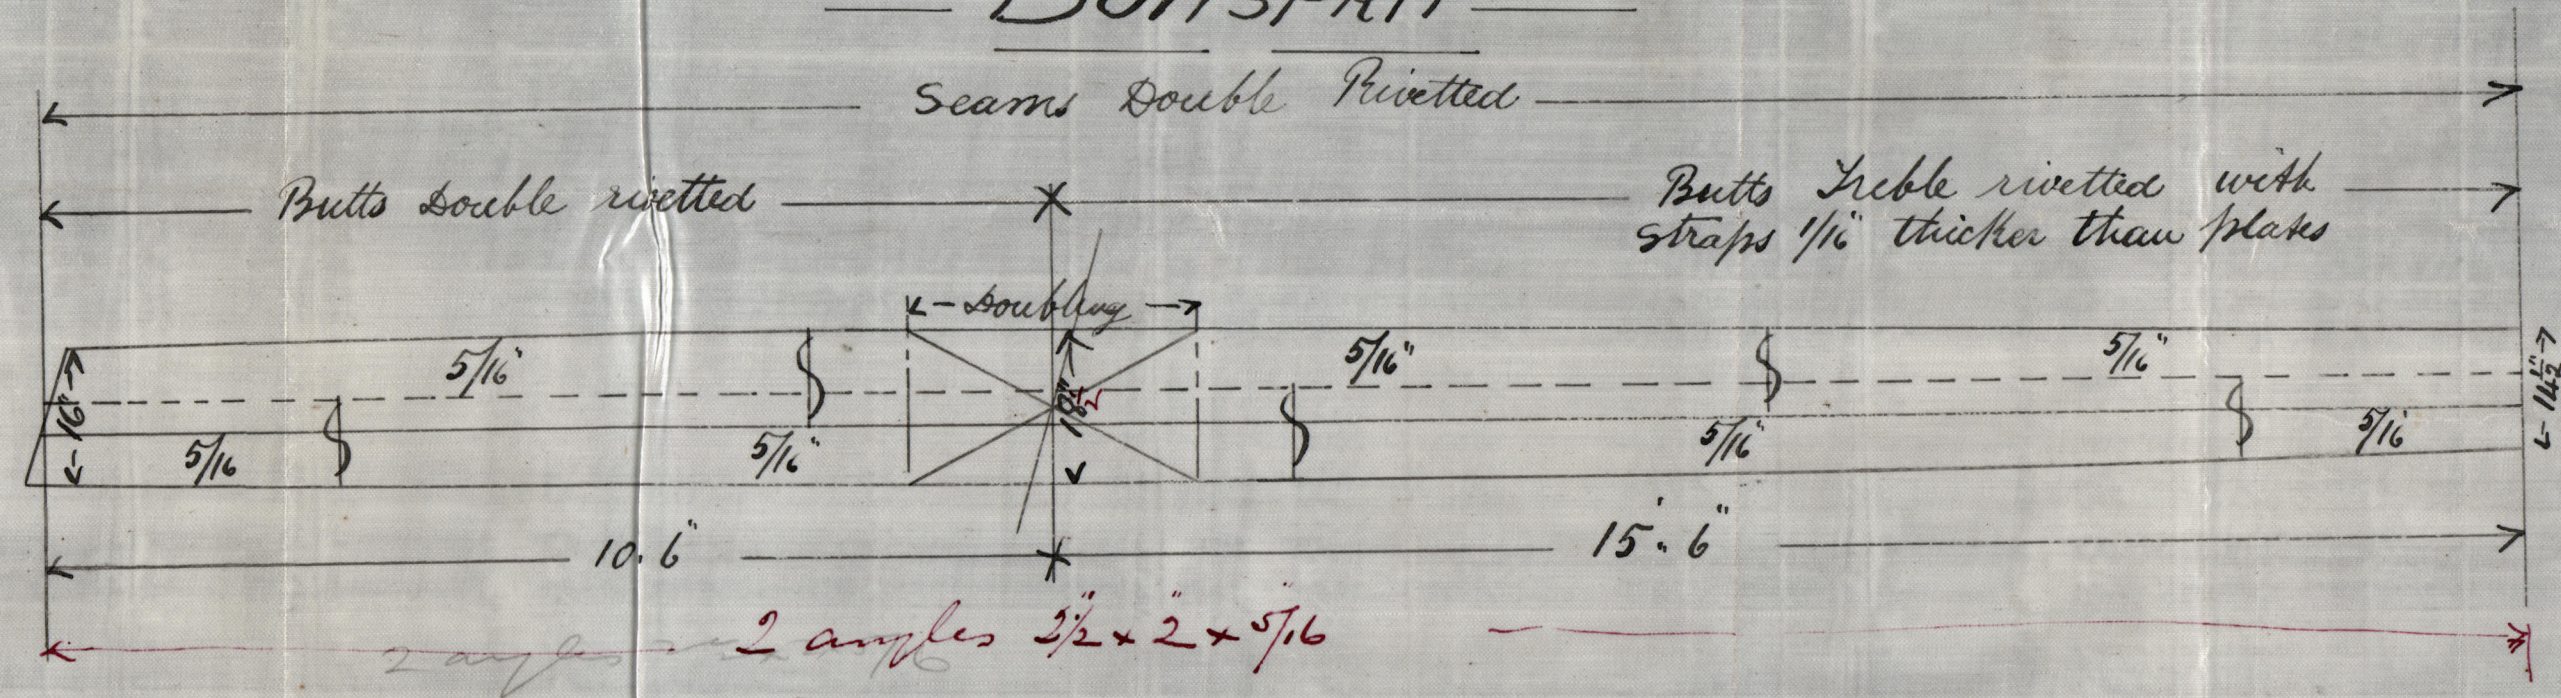

No 7

Fore Mast and Bowspit (Iron)  
Iron Sailing Barquentine  
Scale 1/2" = one foot.

13/3/83