

"Alexandra" Hull No. 5784

Iron Screw Lug

Nº 289

1.6.85

DEPTH = 9.5  
1/2 BREADTH = 8.25  
1/2 GIRTH = 14.75  
32.50 / 21.75  
230.75 2nd

CLASS 100 A iron  
Screw Lug


# MIDSHIP SECTION

SCALE 1" = 1 FT


DIMENSIONS PER RULE 71.0 x 16.5 x 9.5



7-22.5-55

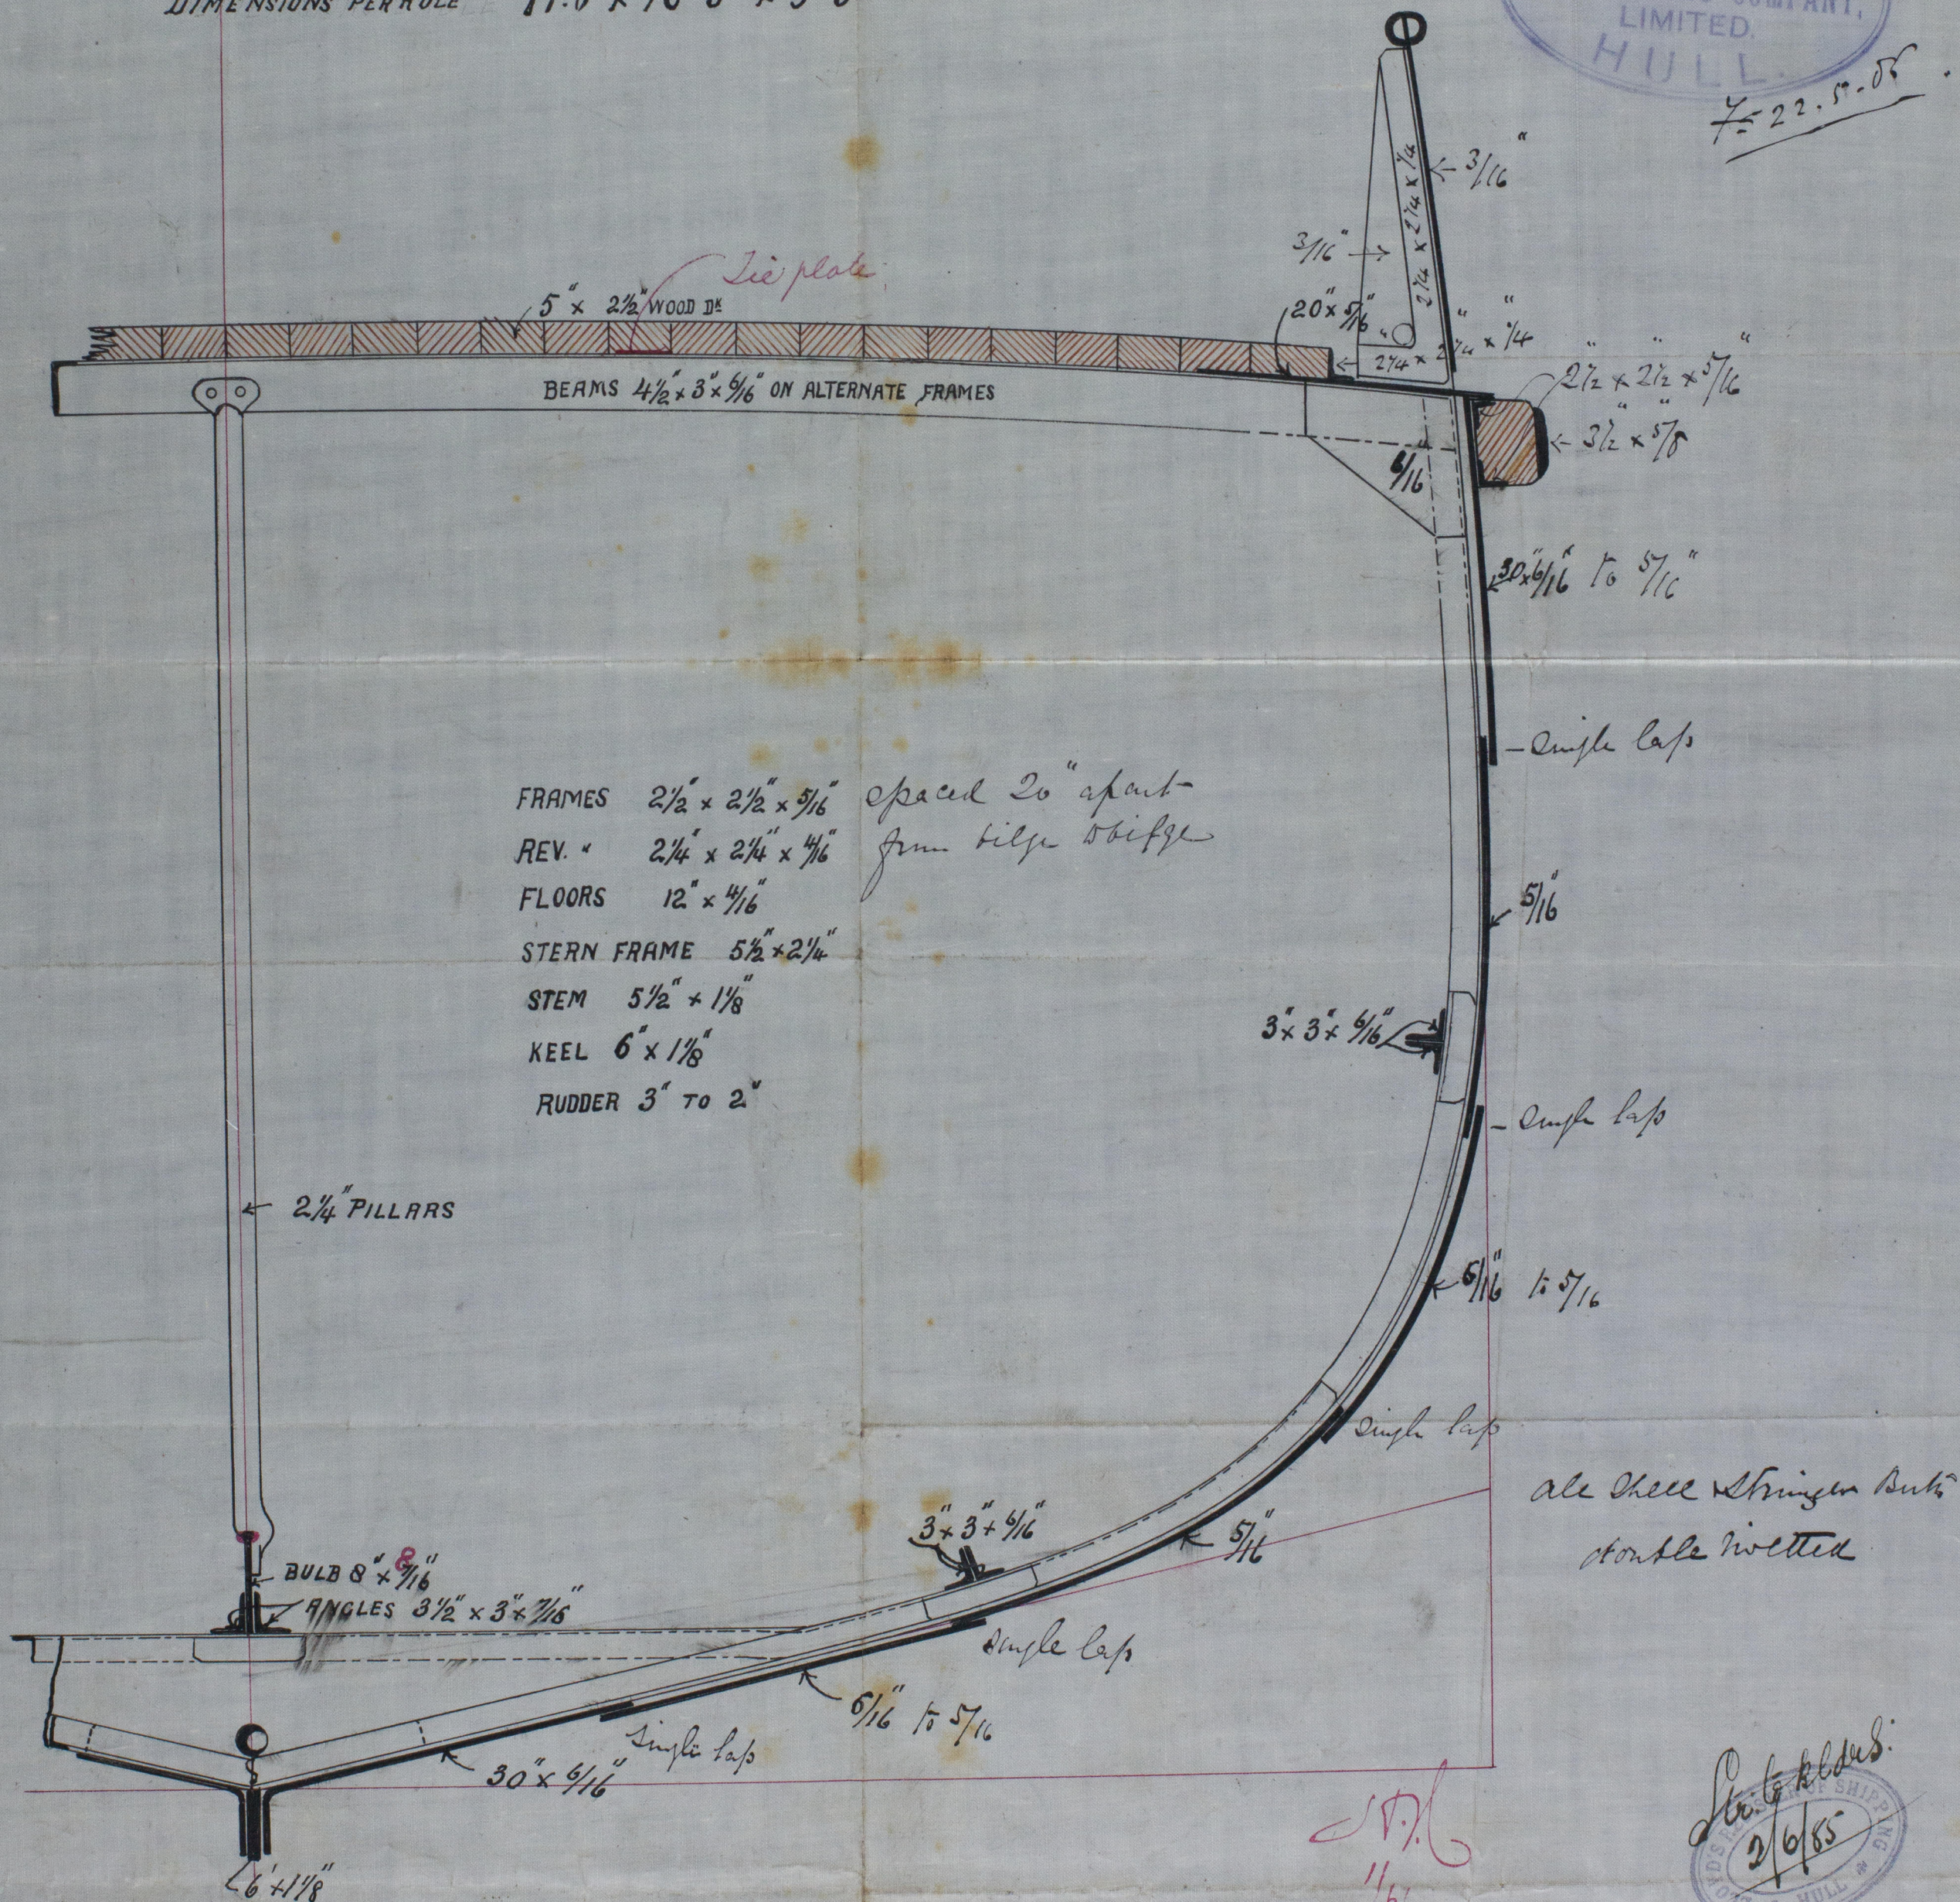

all shell stringer bulk  
double riveted

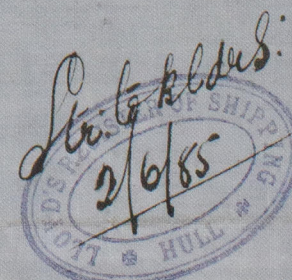

© 2019

Lloyd's Register  
Foundation









HVL398-0032




