



~ No 286 ~


Longitudinal plan shewing Arrangement of Bt's.

Web frames. Hatches. &c.

Scale  $\frac{1}{8}" = \text{one foot.}$



$$\begin{array}{r} 2022 \\ \times 22 \\ \hline 4044 \\ 4044 \\ \hline 44484 \end{array}$$

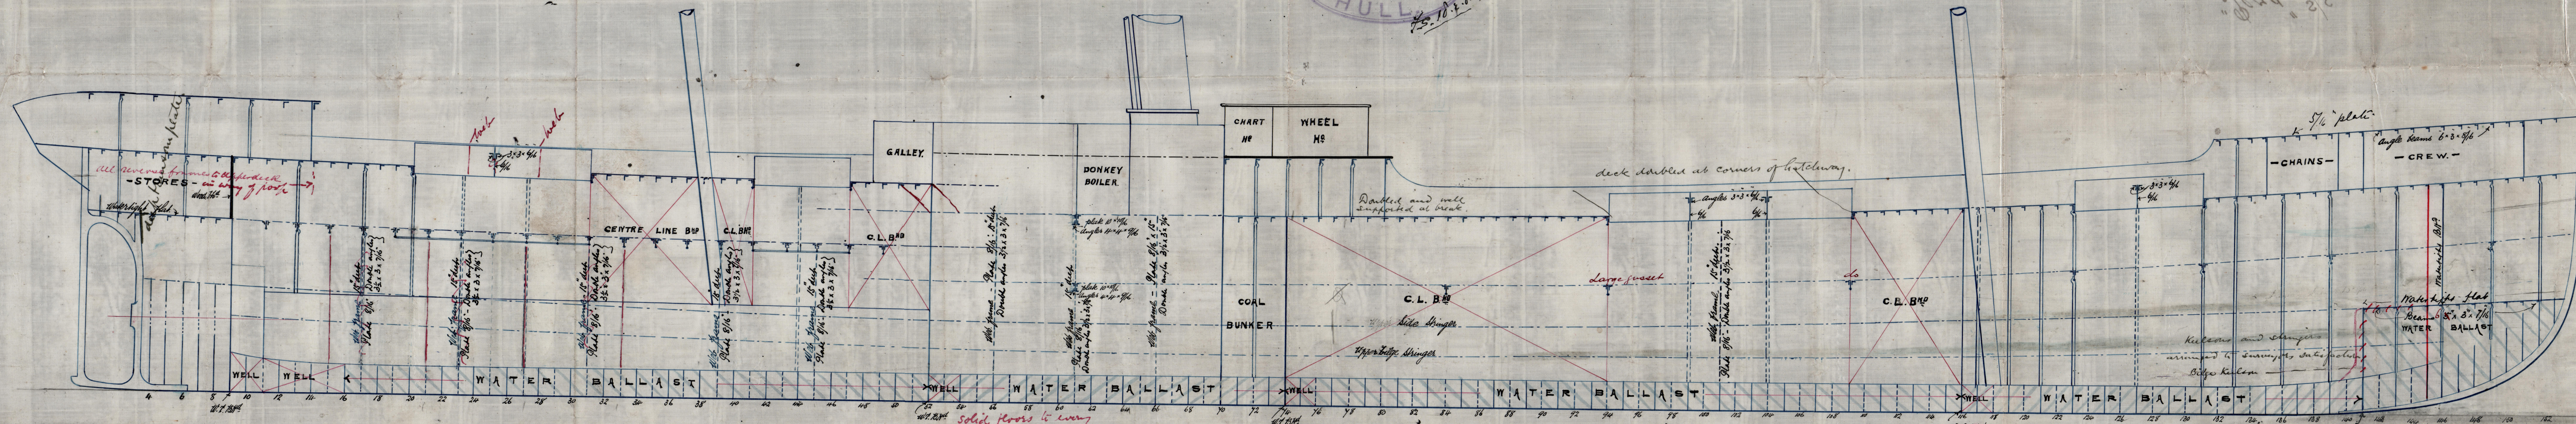

54 56 58 60  
solid floors to every  
frame under Engines

20/2/83

© 2019  
Lloyd's Register  
Foundation

J.V.L.  
20/2/83

HVL 398-0156



"Pera" s/s  
Report № 5926

HVL 398-0156



© 2019

Lloyd's Register  
Foundation