
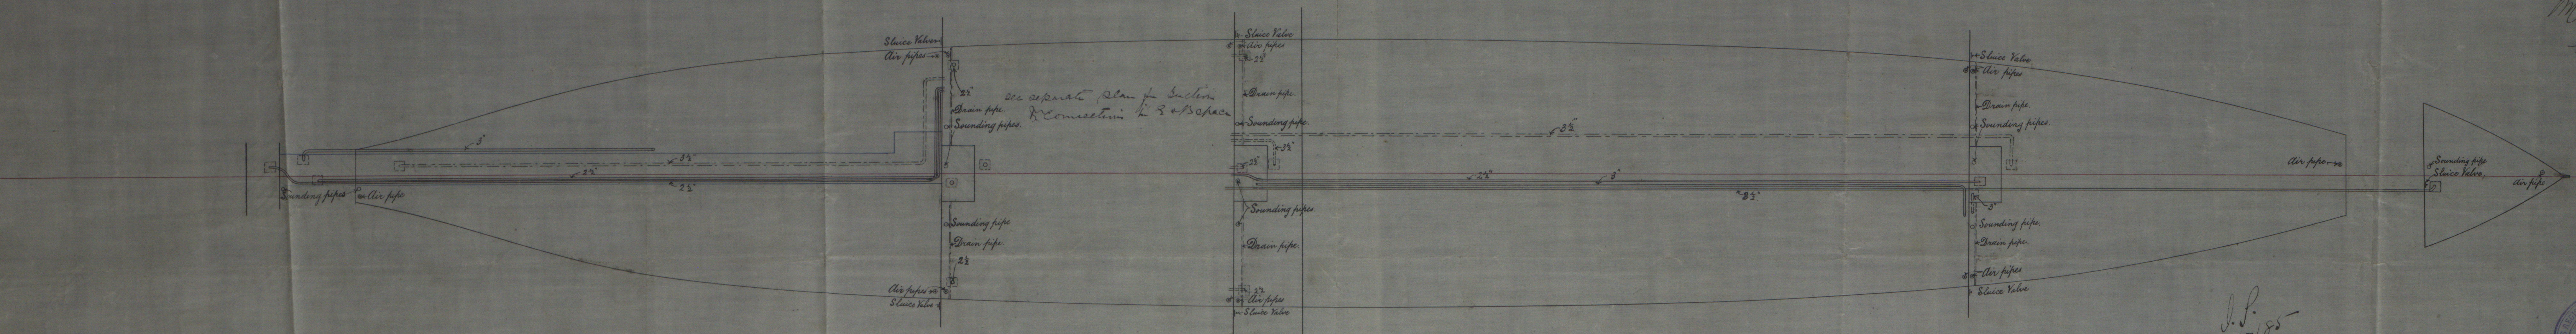
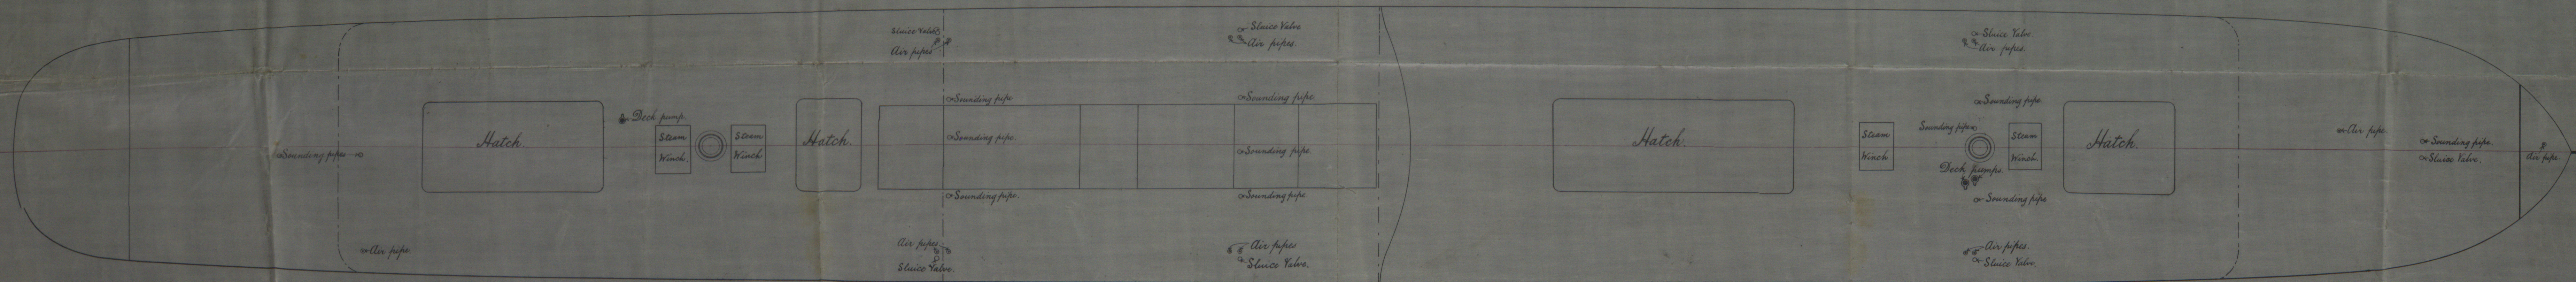


dk: to Hull:
1/8/85

Dimensions 310'-0" x 37'-0" x 24'-1"

S.S. Pera No 5726. — No 286. —
Pumping Arrangement.

Scale 1/8" = 1 foot.

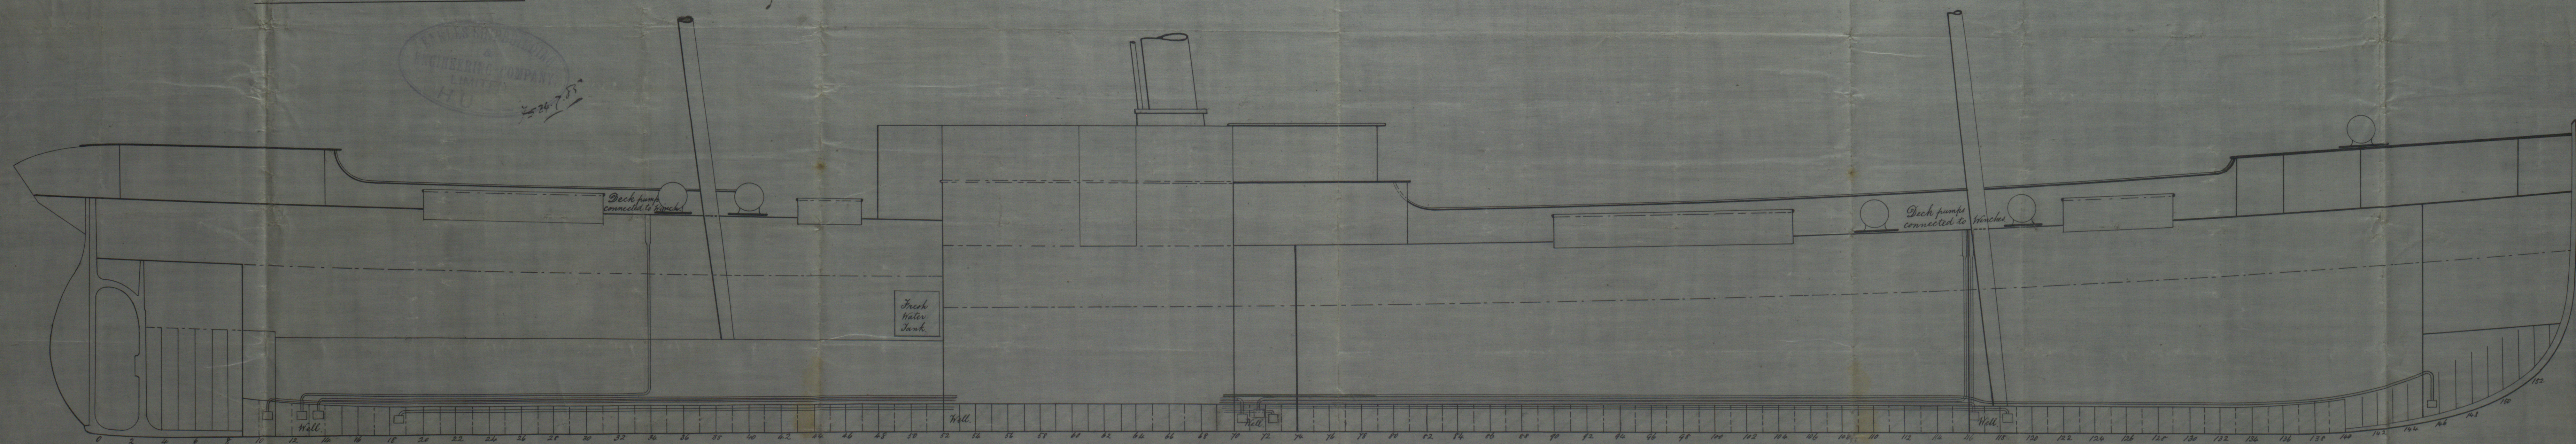


M 21/7/85

L.P.
20/7/85



HU/398-0157

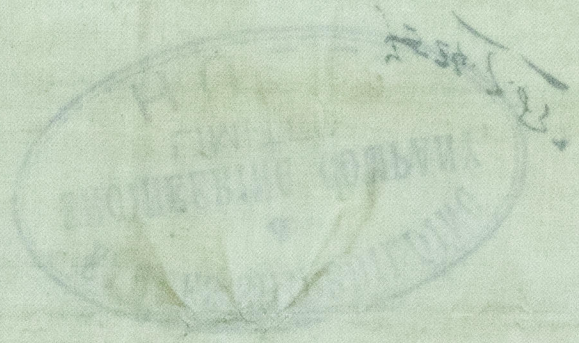

1-25-0-13-0-013. 210-0



© 2019

Lloyd's Register
Foundation