



- No. 286 - Iron Mast - Scale  $\frac{1}{2}$ " = 1 foot -



- Fore mast -  
45" 6"

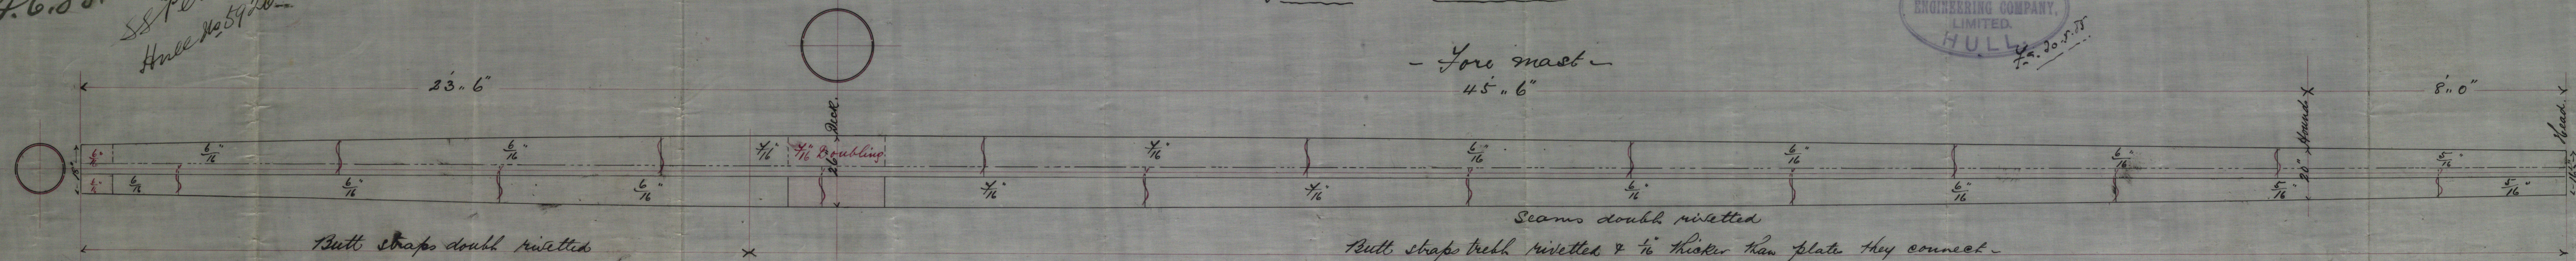

- Main Mast -

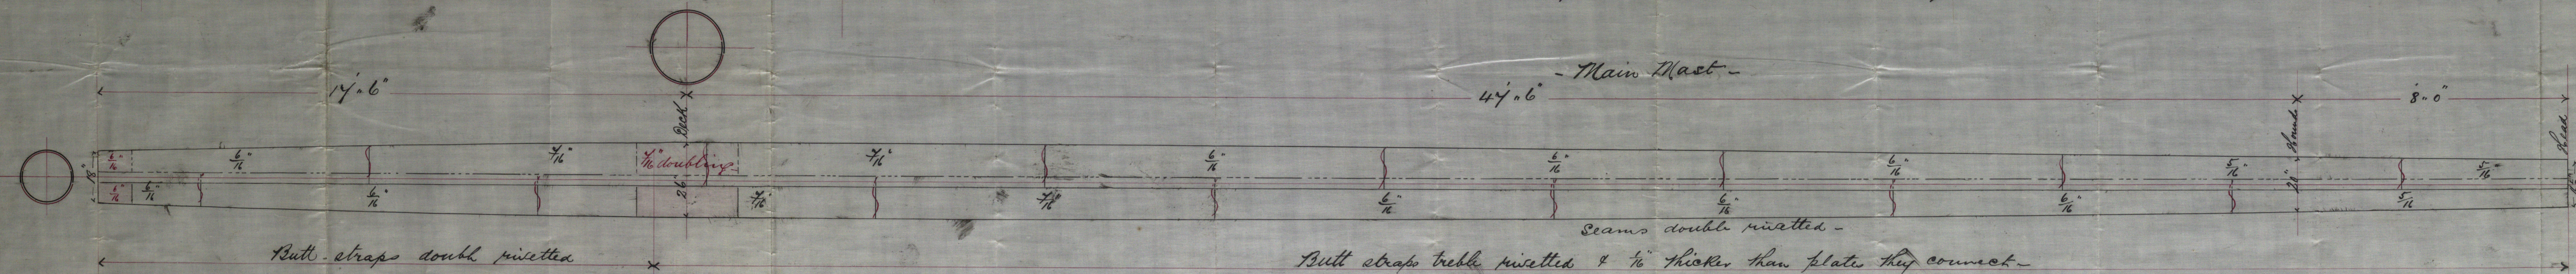

*Due to Blame*  
 OYD'S REGISTER OF SHIPING  
 5-6-85  
 OTT \* HOLL \*

Handwritten signature: J.H.L.  
Date: 4/6/83  
Large blue 'R' logo with 'L' and 'E' partially visible.

© 2019  
Lloyd's Register  
Foundation



8.0"

23.5"


Head

1/16"

1/16"

1/16"

That shape would be better

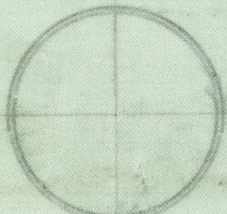

Head

1/16"

HVL 398-0158



1/16"



1/16"

1/16"

That shape would be better

x



© 2019

Lloyd's Register  
Foundation