

S. S. 'Eldorado'

Charles No. 300

Hull Report No. 5966

HUL 398-0254

— Main Deck —

— 2nd Deck —

— 3rd Deck —


— Engine & boiler space —



© 2019

Lloyd's Register  
Foundation



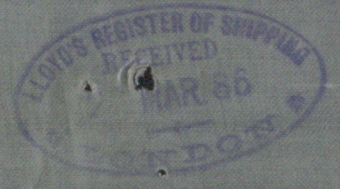


N<sup>o</sup> 300


Plans showing plating & inway of Engine & Boiler Space

Scale  $\frac{1}{4}$ " = 1 foot

Main Deck

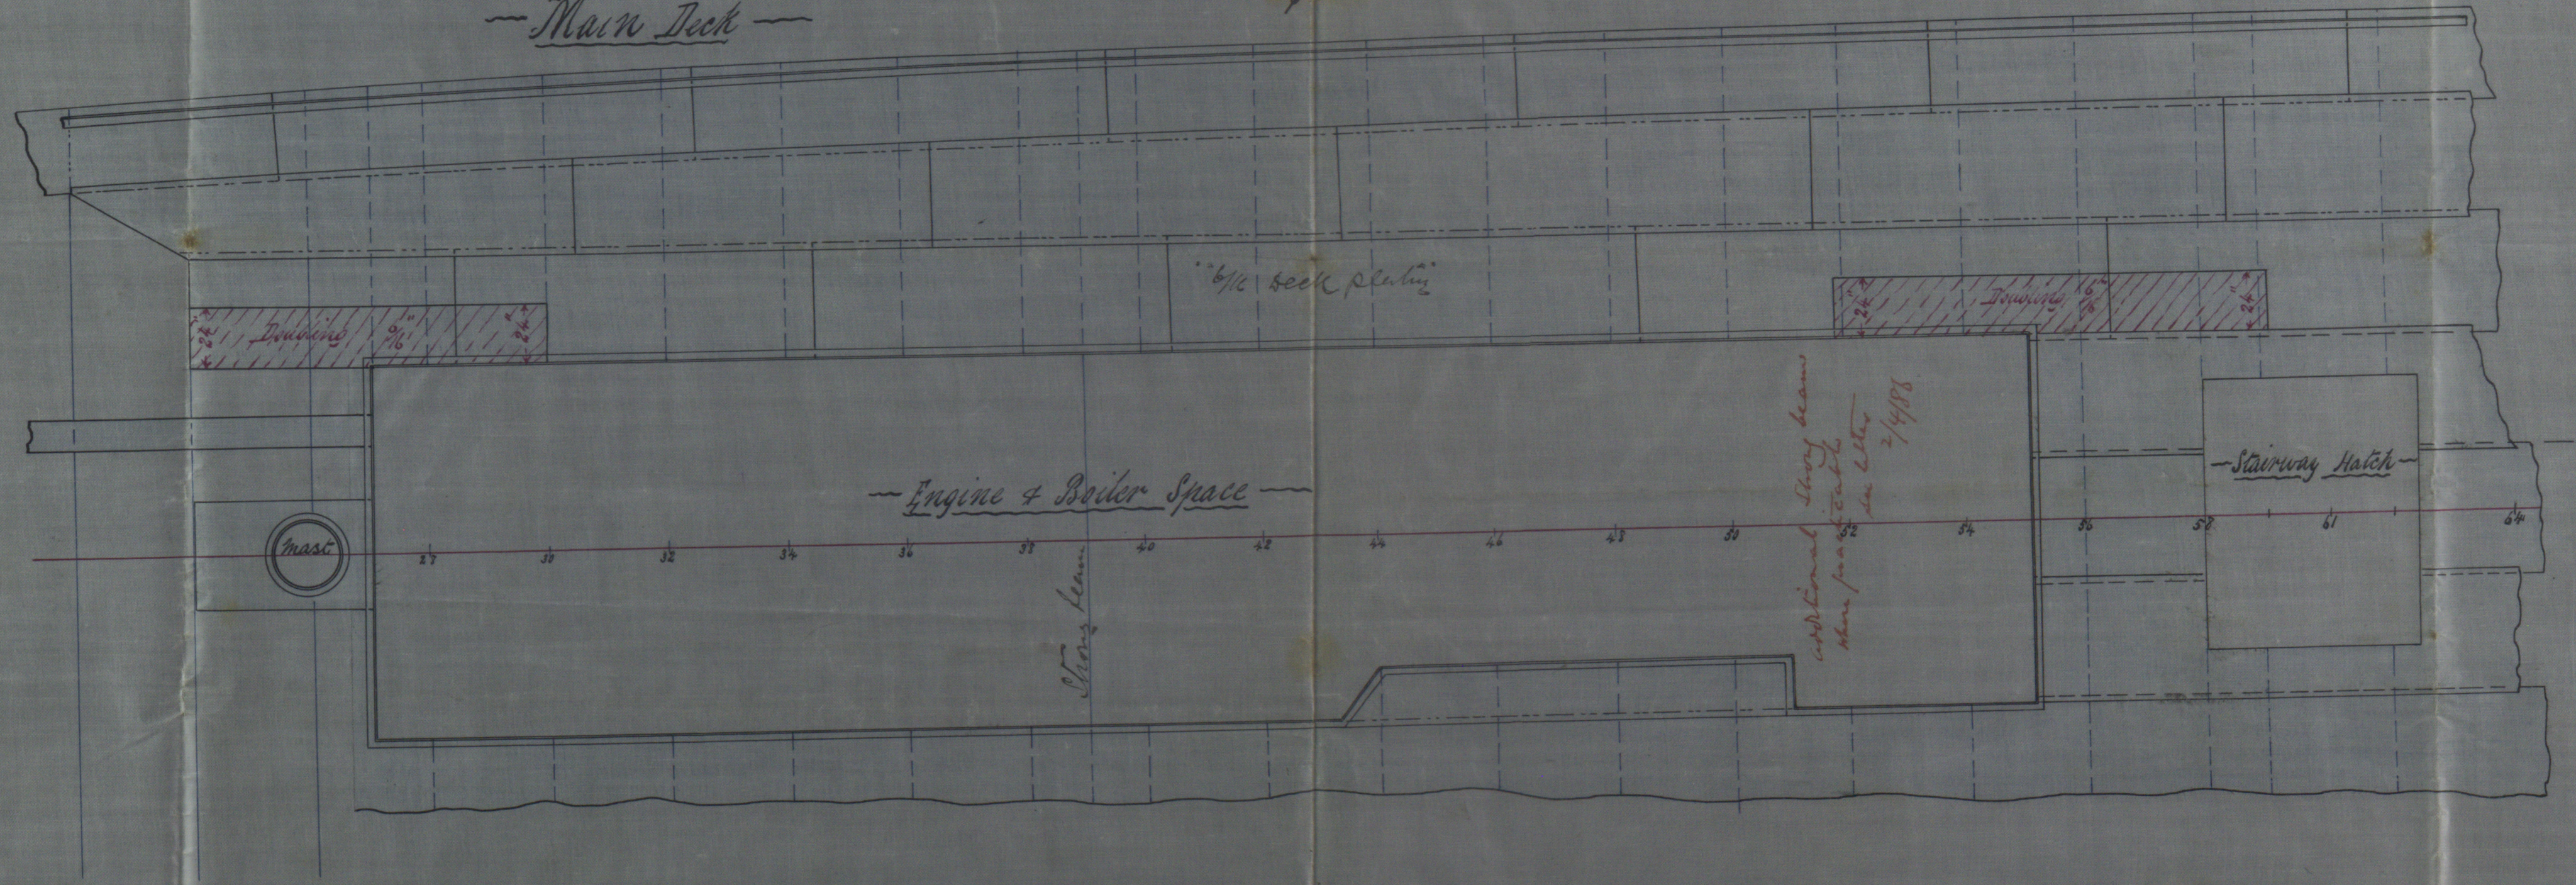

Lower Deck

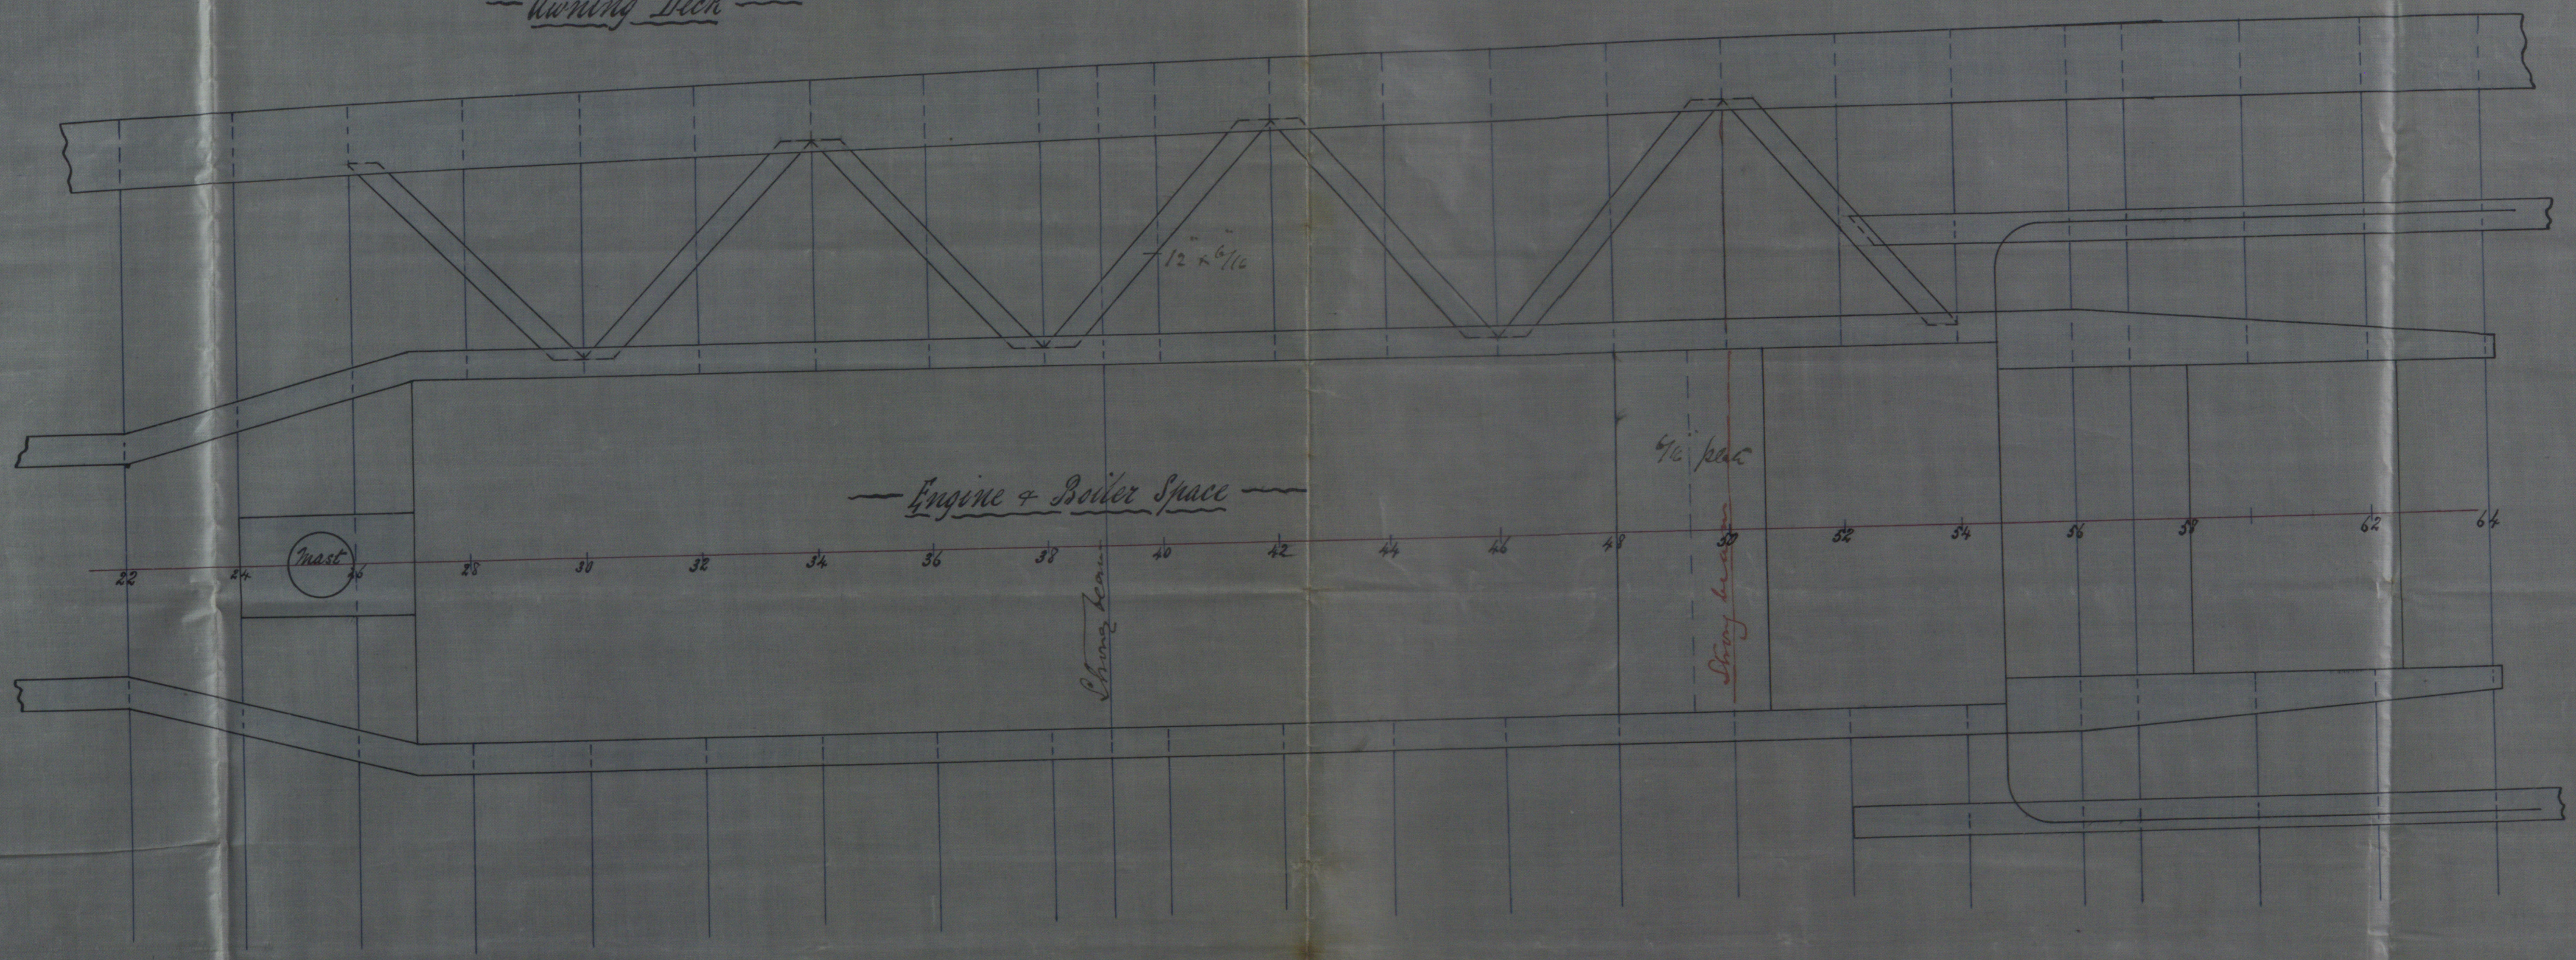

22-3-86

See letter 2/4/86  
TB