


S. S. "Eldorado"
Charles No. 300
Report No 5966

LOYD'S REGISTER OF SHIPPING
HULL

HUC 398-0260

2. 4/5

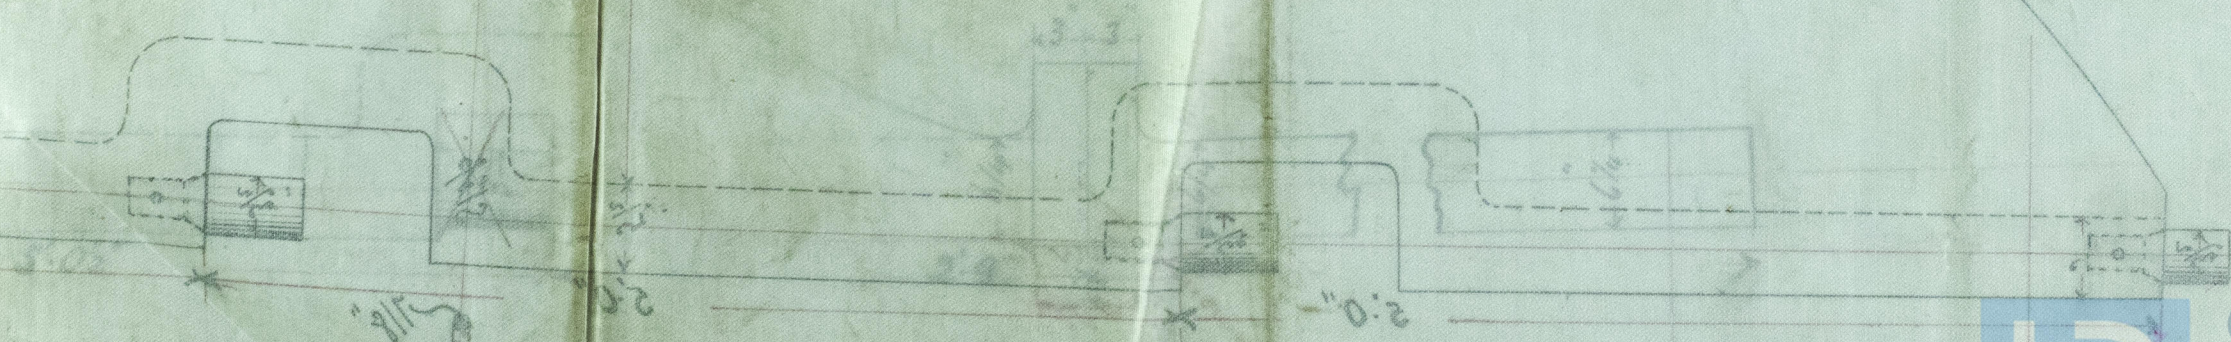

RECEIVED
FEB 20
1886
HULL


Report No 2466
Date 10 300
of 1. 1. 1.

23.2.86.
8/3/86.

N^o 300. Sketch Cast Steel Rudder. Scale one inch = one foot.

SHIPS BUILDING
ENGINEERING COMPANY,
LIMITED.
HULL.

23/2/86
8/3/86

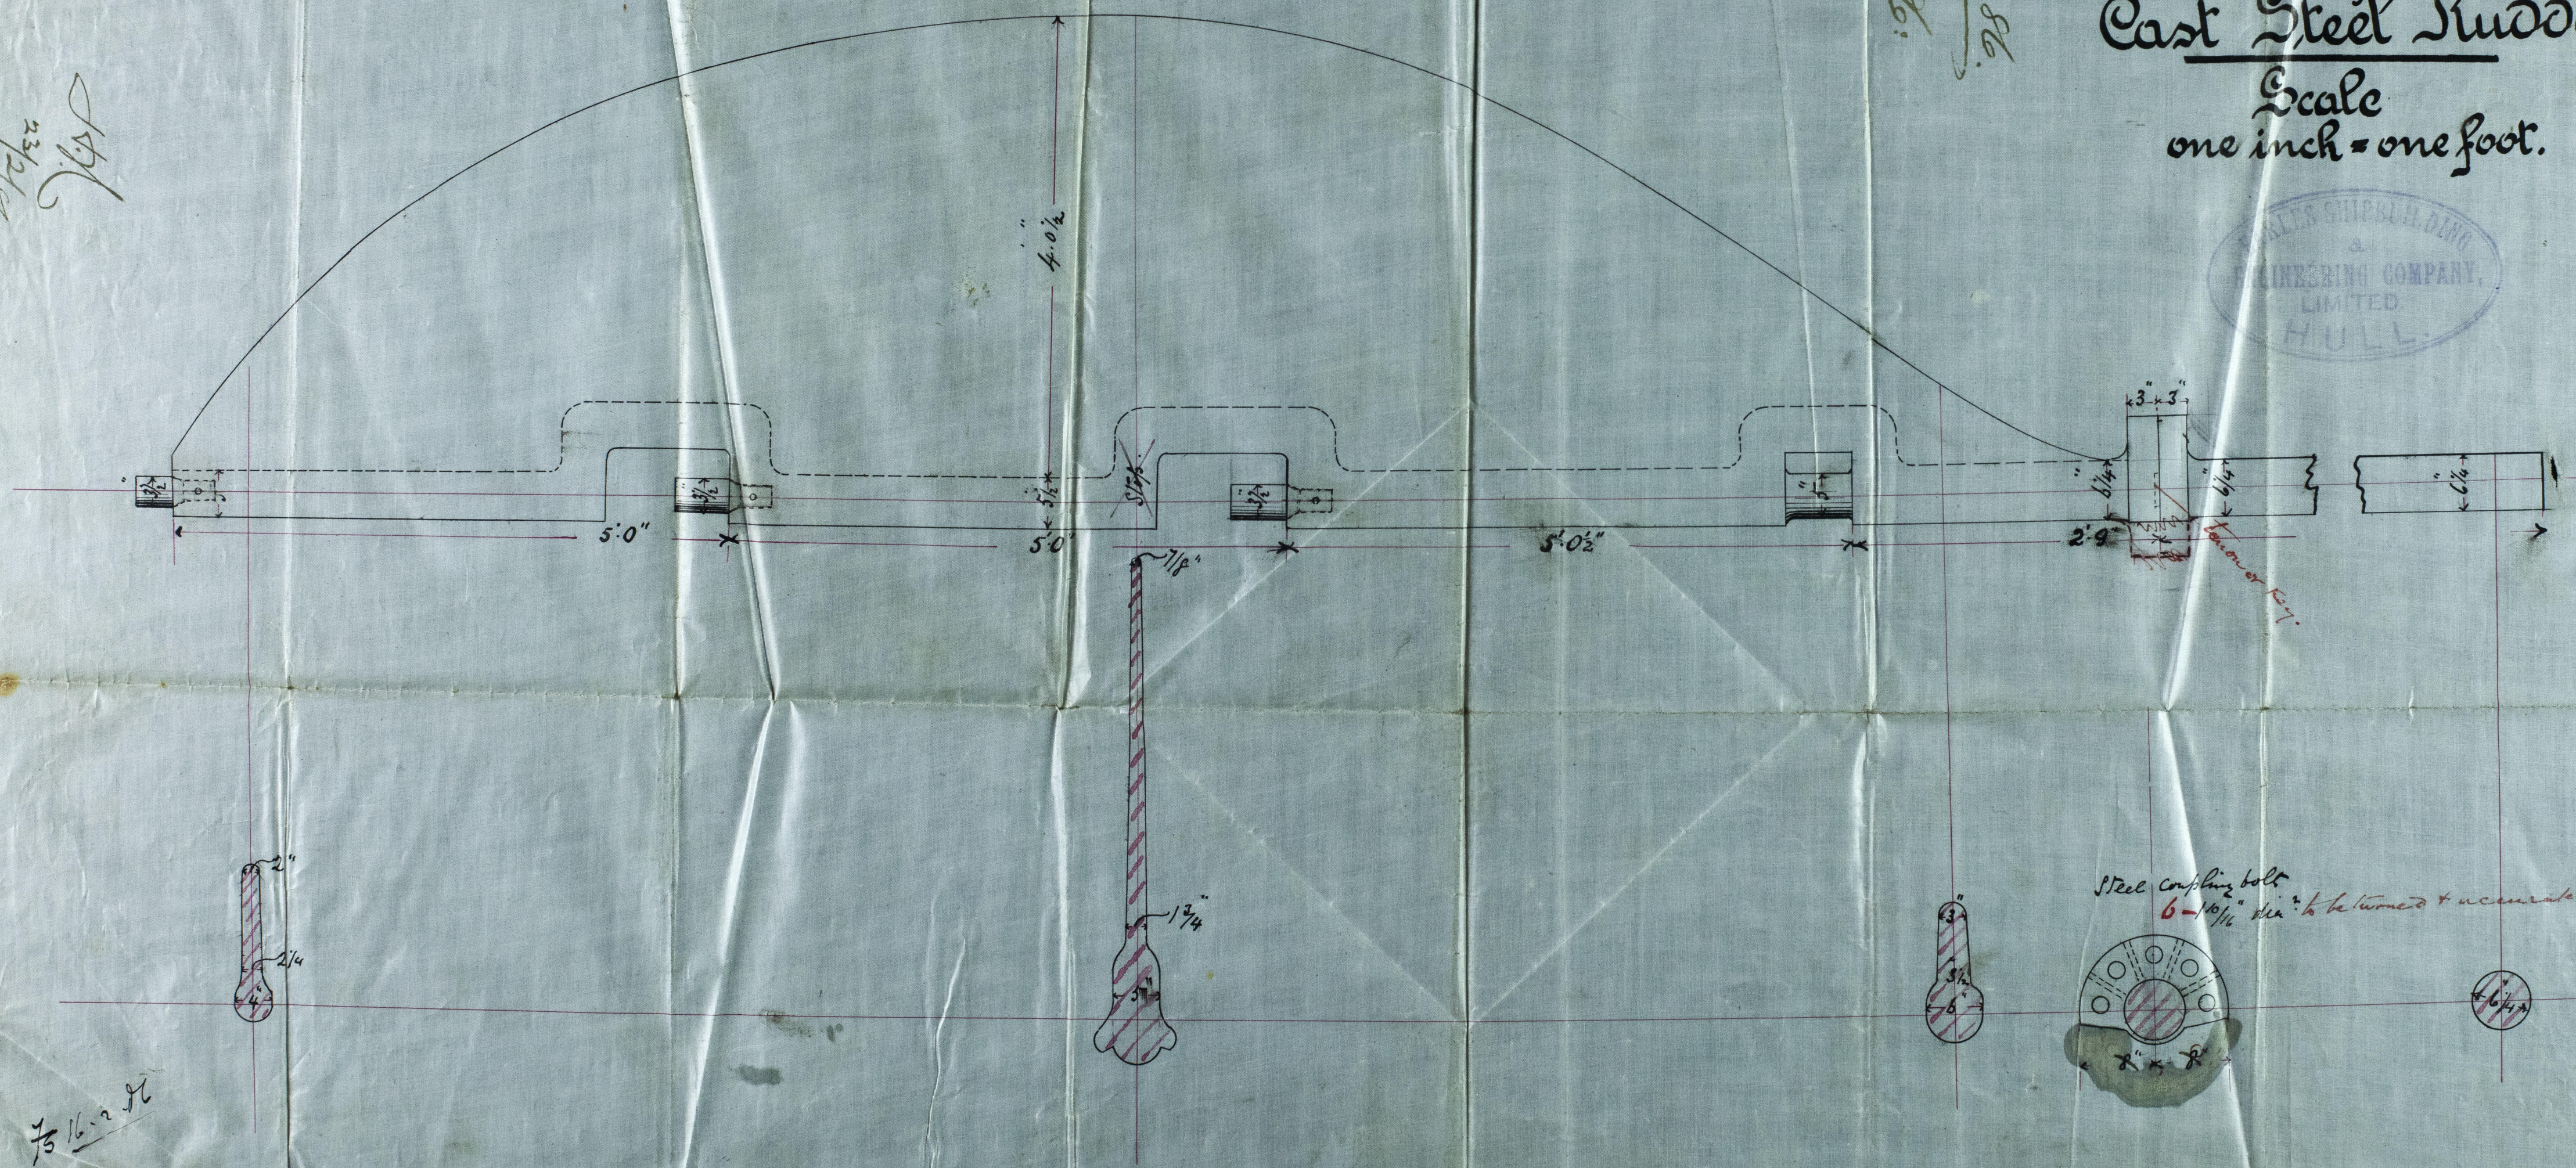

7/3/86

Rev to Plans
24/2/86
9/3/86
Lloyd's Register
Marine Insurance