


S. S. Eldorado

Charles No. 300

Report No: 5966

HVL 398-0282

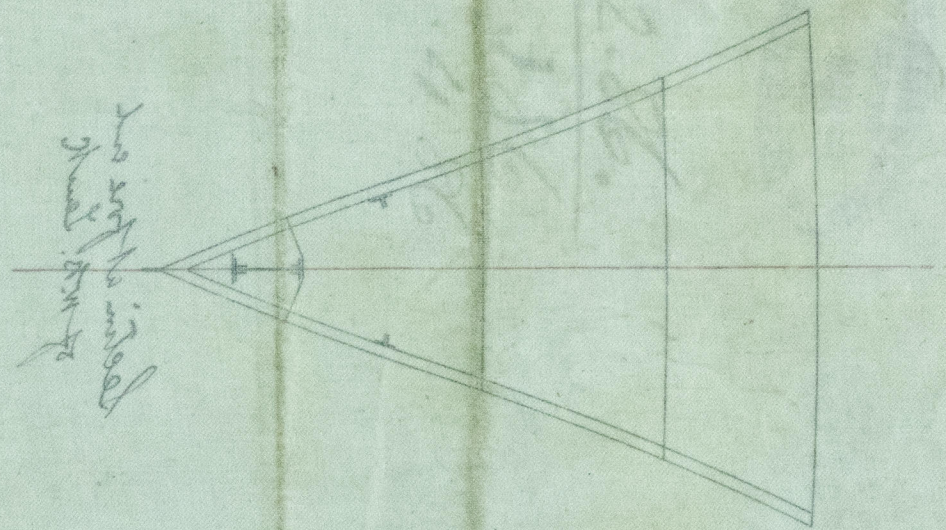

© 2019




Lloyd's Register
Foundation

LLOYD'S REGISTER OF SHIPS
 RECEIVED
 22 FEB 86
 LONDON
 LLOYD'S REGISTER OF SHIPS
 RECEIVED
 21 MAR 85
 LONDON

25.2.86.
 12.3.86
 2.4.86

No 300 - S.S. "Eldorado" Hull No 5966
 Longitudinal plan showing arrangement of beams, pillars &c -
 Scale 1/8" = 1 foot

CARLIS SHIPBUILDING
 &
 ENGINEERING COMPANY
 LIMITED
 HULL

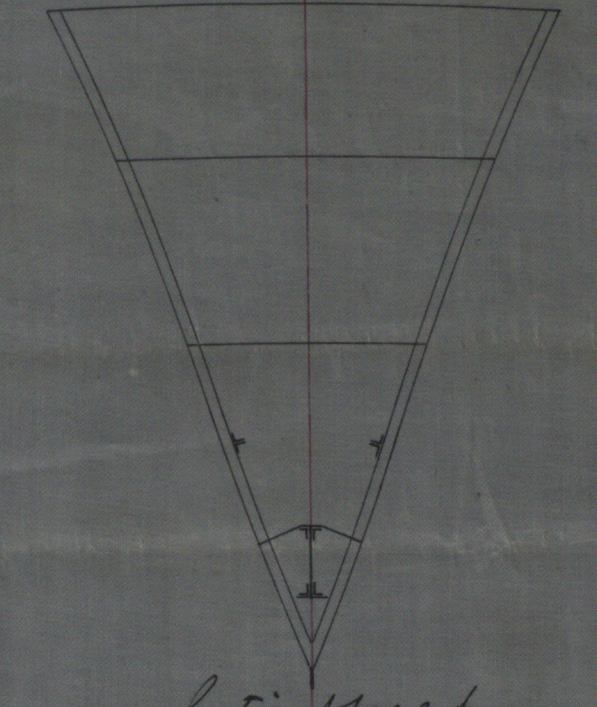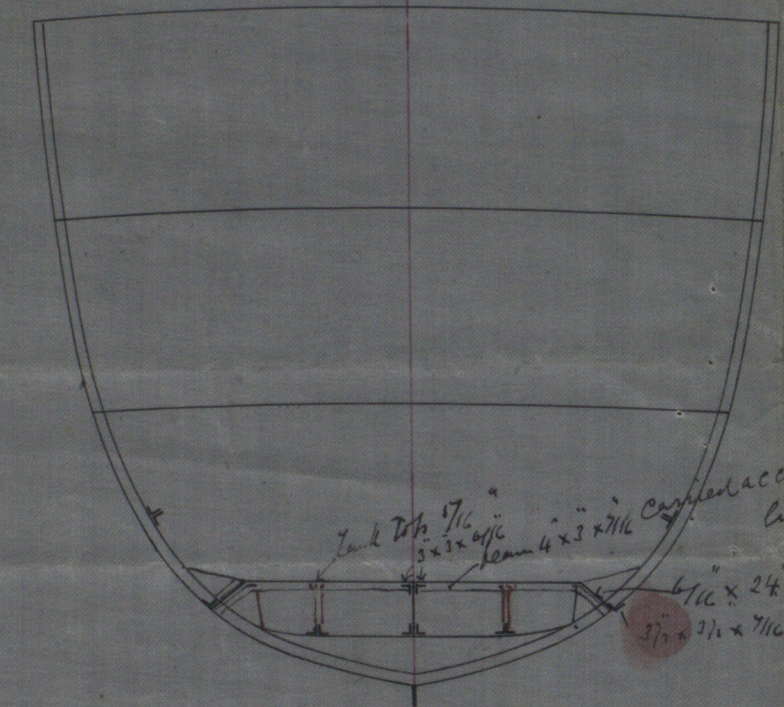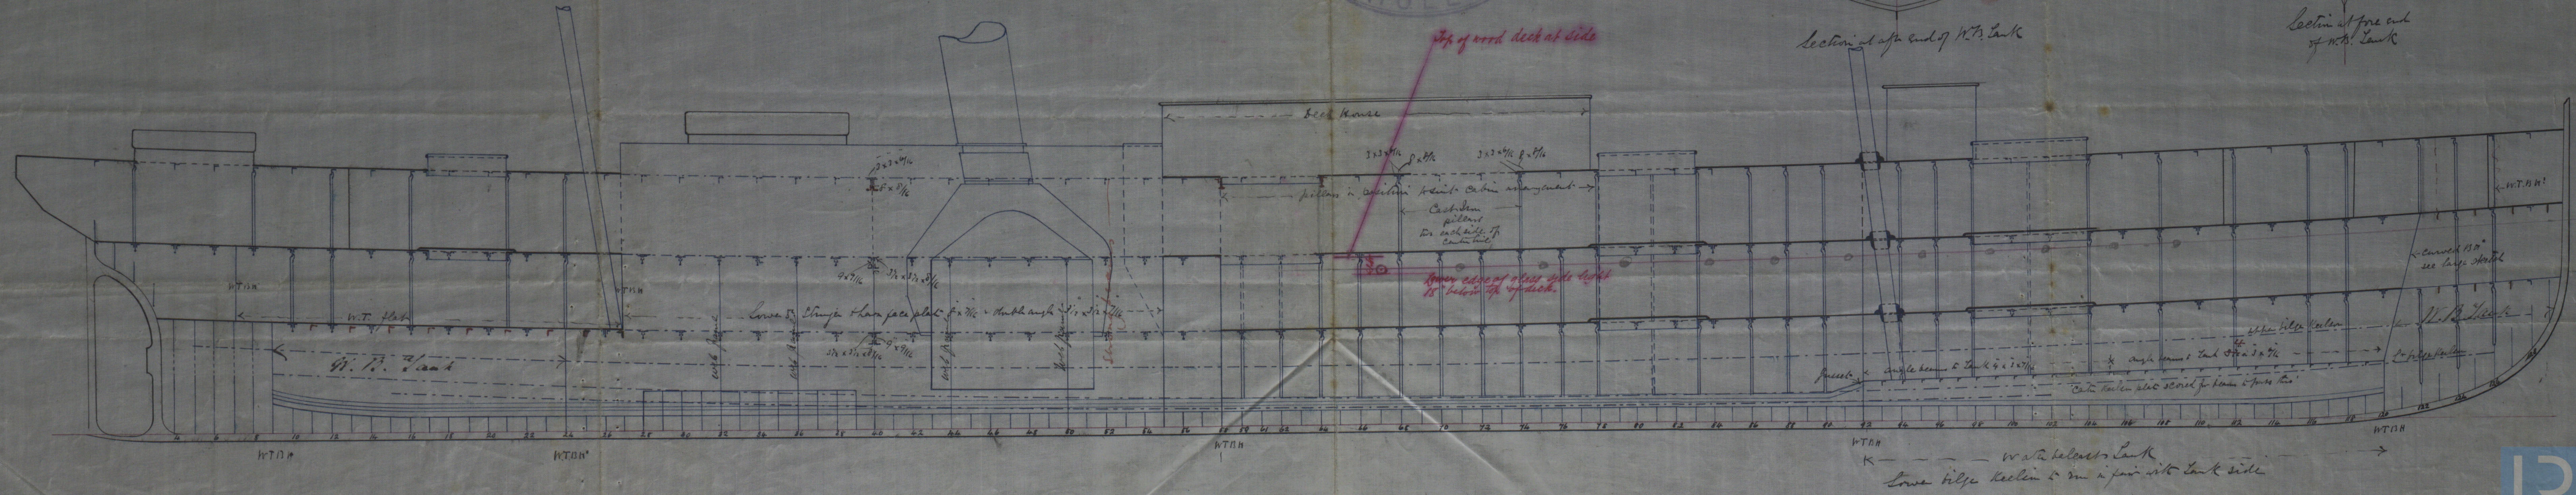

25.2.86
 12.3.86
 2.4.86

25.2.86

Lloyds Register
 Foundation
 Hull 378-01-82