

Midship Section

No 300

18.2.86
25.2.86
2.4.86


Dimensions per Rule. 248'7" x 32'8" x 17'1"

Scale $\frac{1}{2}$ " = one foot.

Over 14 depths to Main deck.

Half breadth 16'4"
Birth 29'1"
Depth 17'1"
 $\frac{62.6}{248.7}$ 1st Num.
 $\frac{1556.8}{1556.8}$ 2nd Num.

Class 100 A.1. Iron. Awning Deck rule

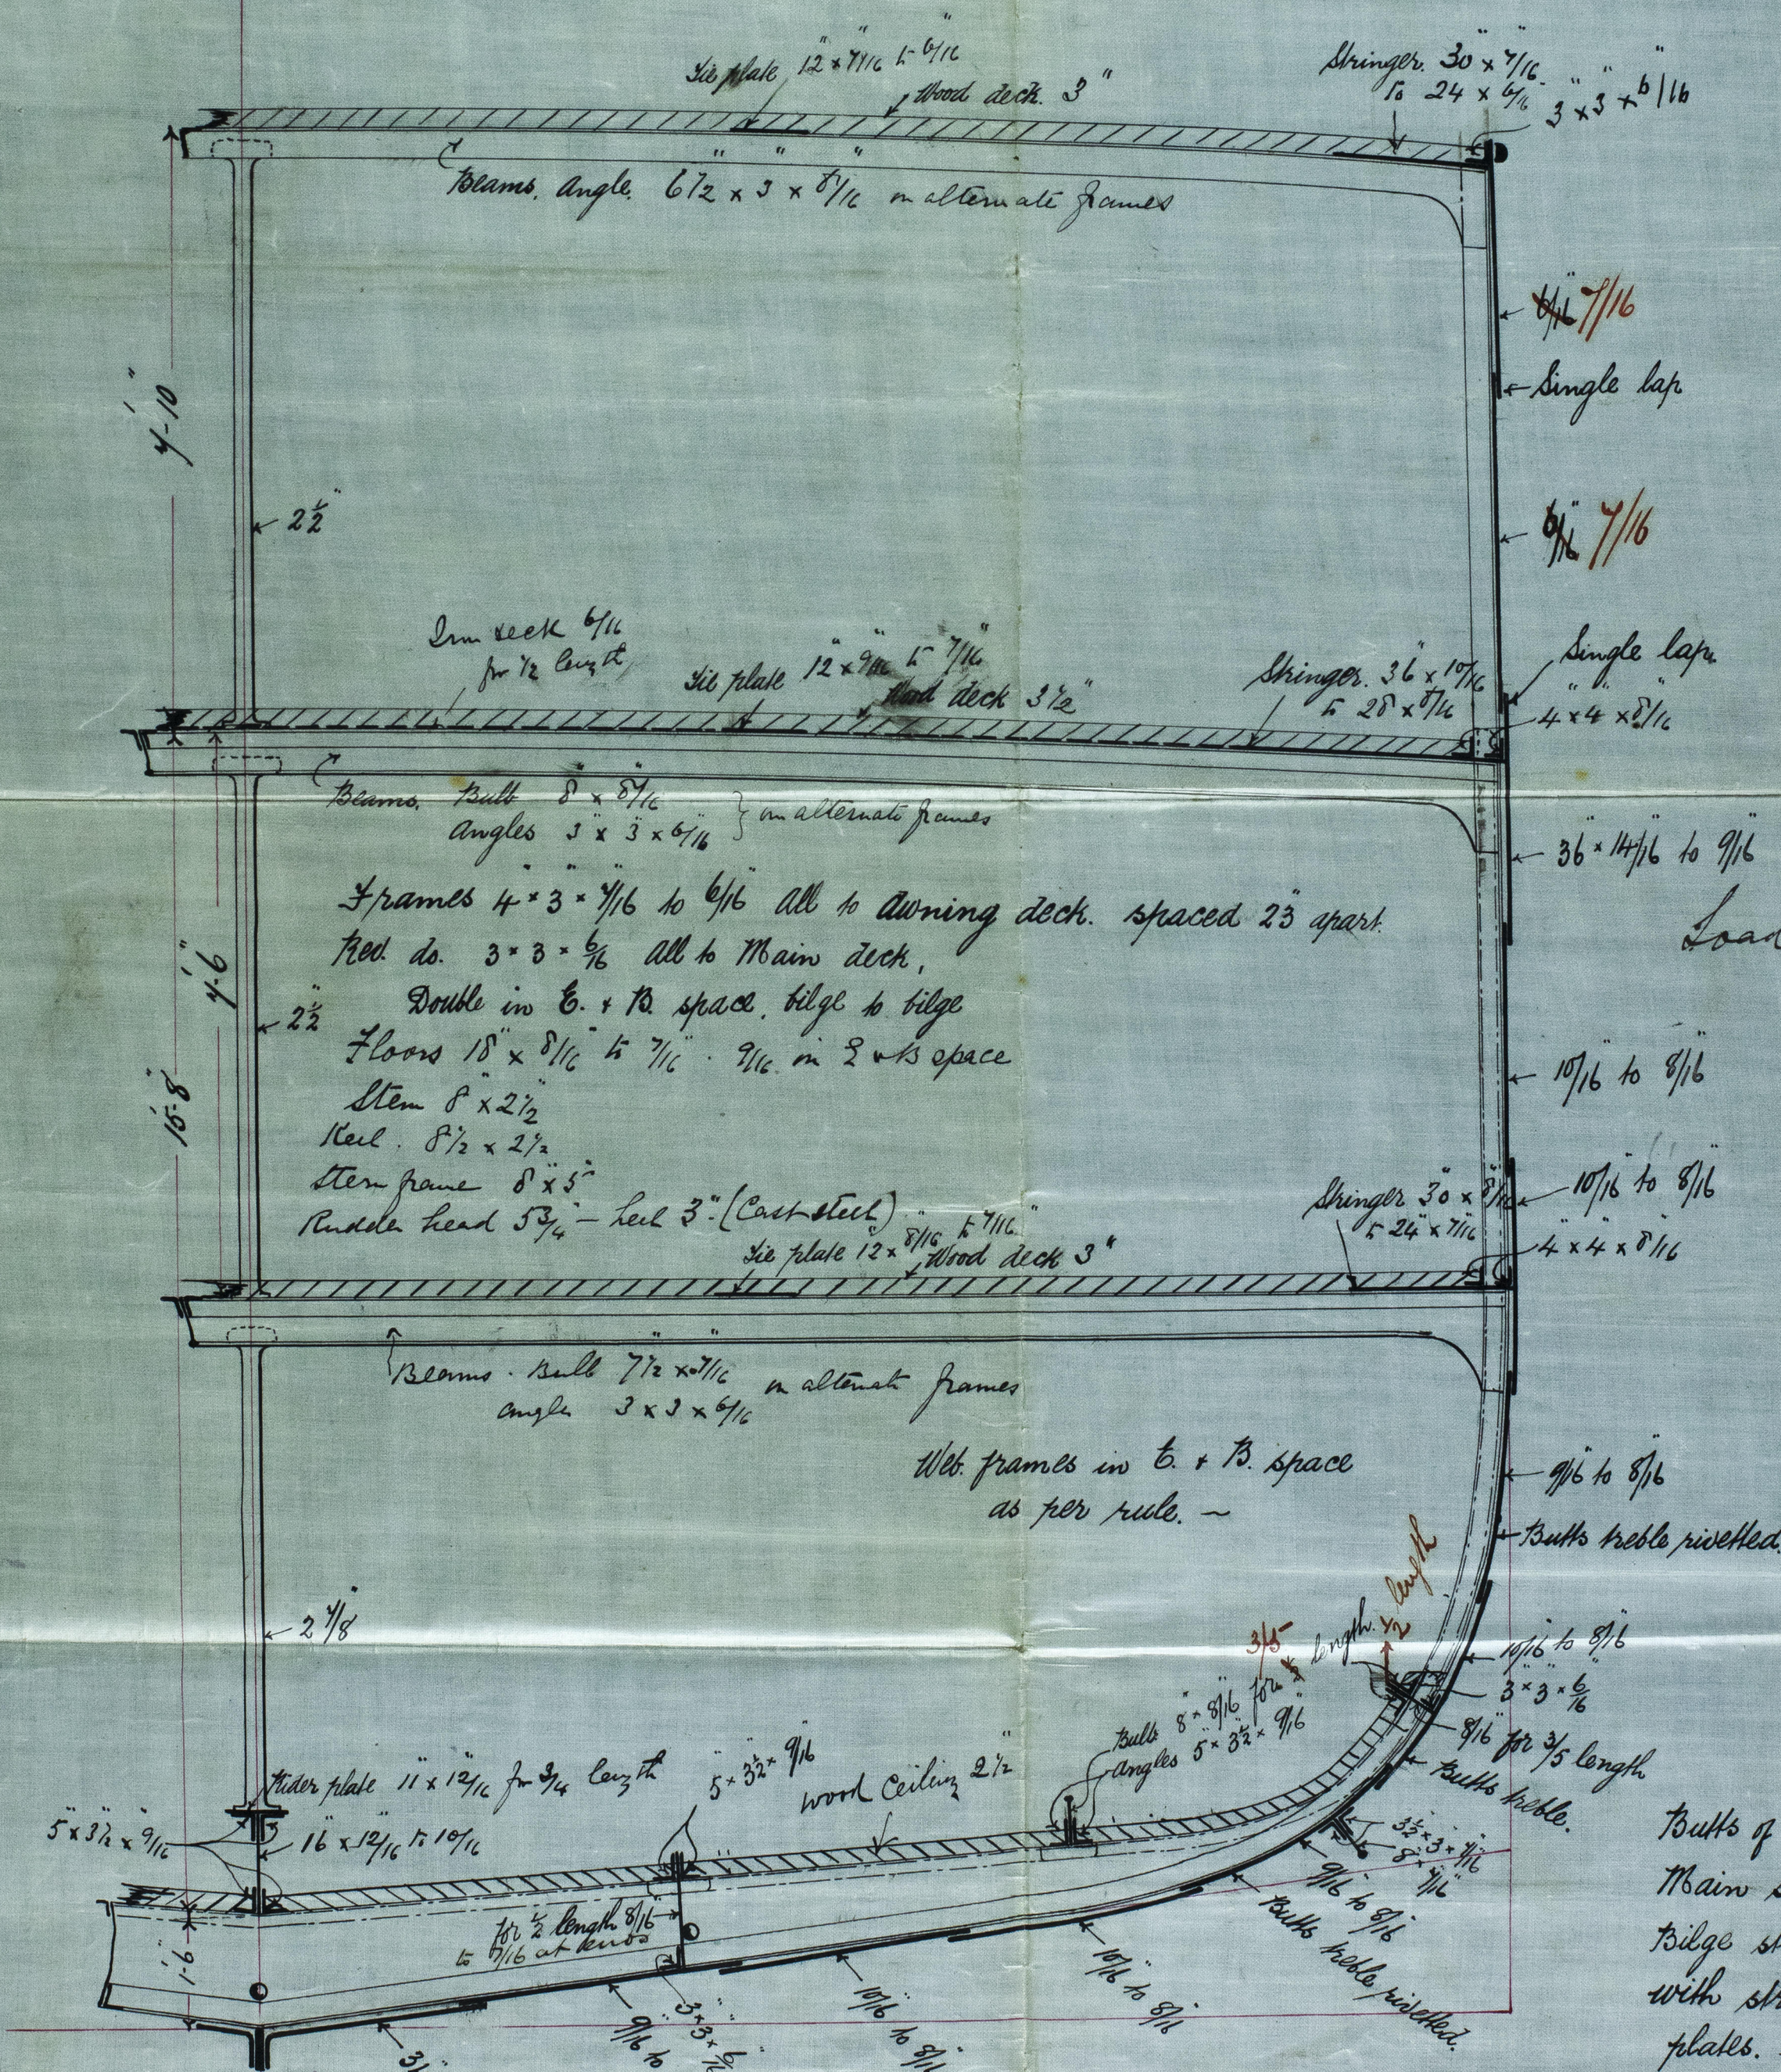

Load line to be submitted

Butts of Main sheer strake, Main Stringer plate, + three Bilge strakes, to be treble rivetted, with straps $\frac{1}{8}$ " thicker than plates.

18.2.86

VSM
18/2/86

