

RECEIVED
3 APR 86
LONDON







10.4.86.



SCALE 1 INCH TO A FOOT.

Working pressure 180 lbs
Test " 180 "

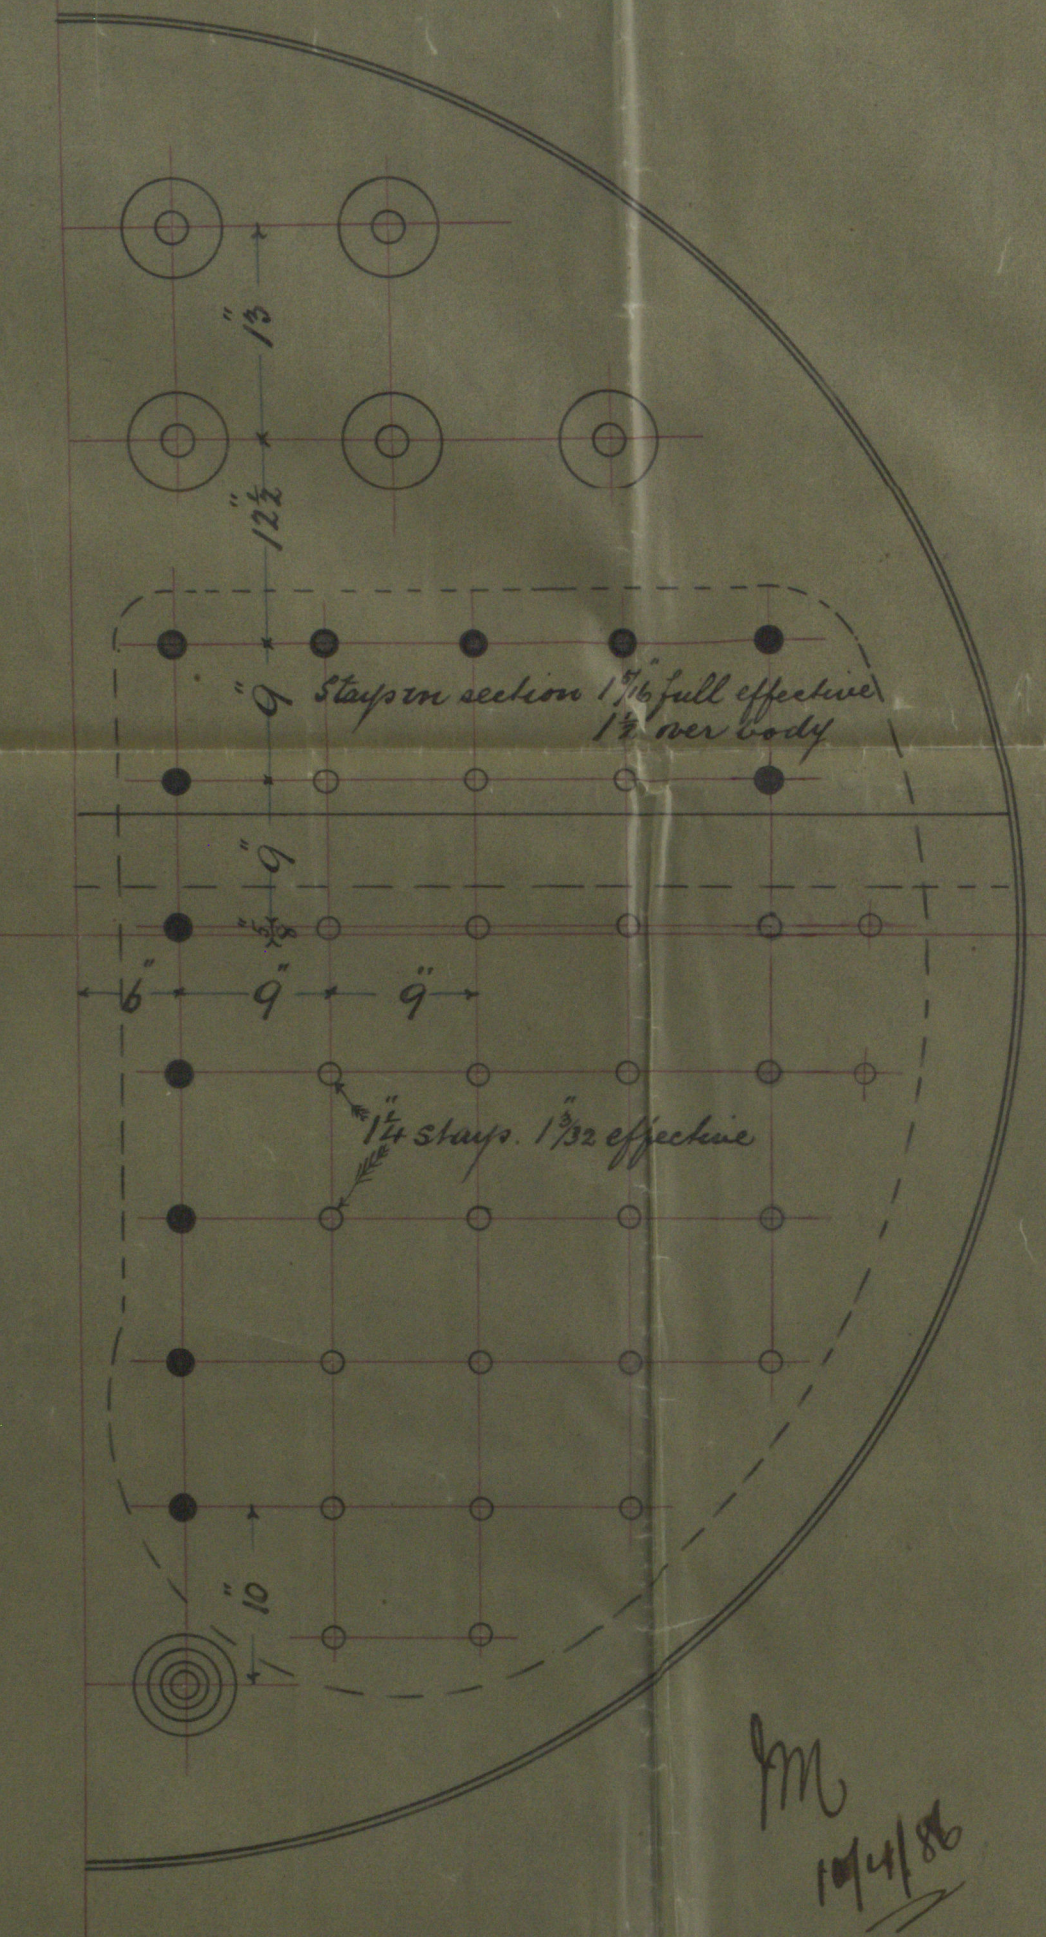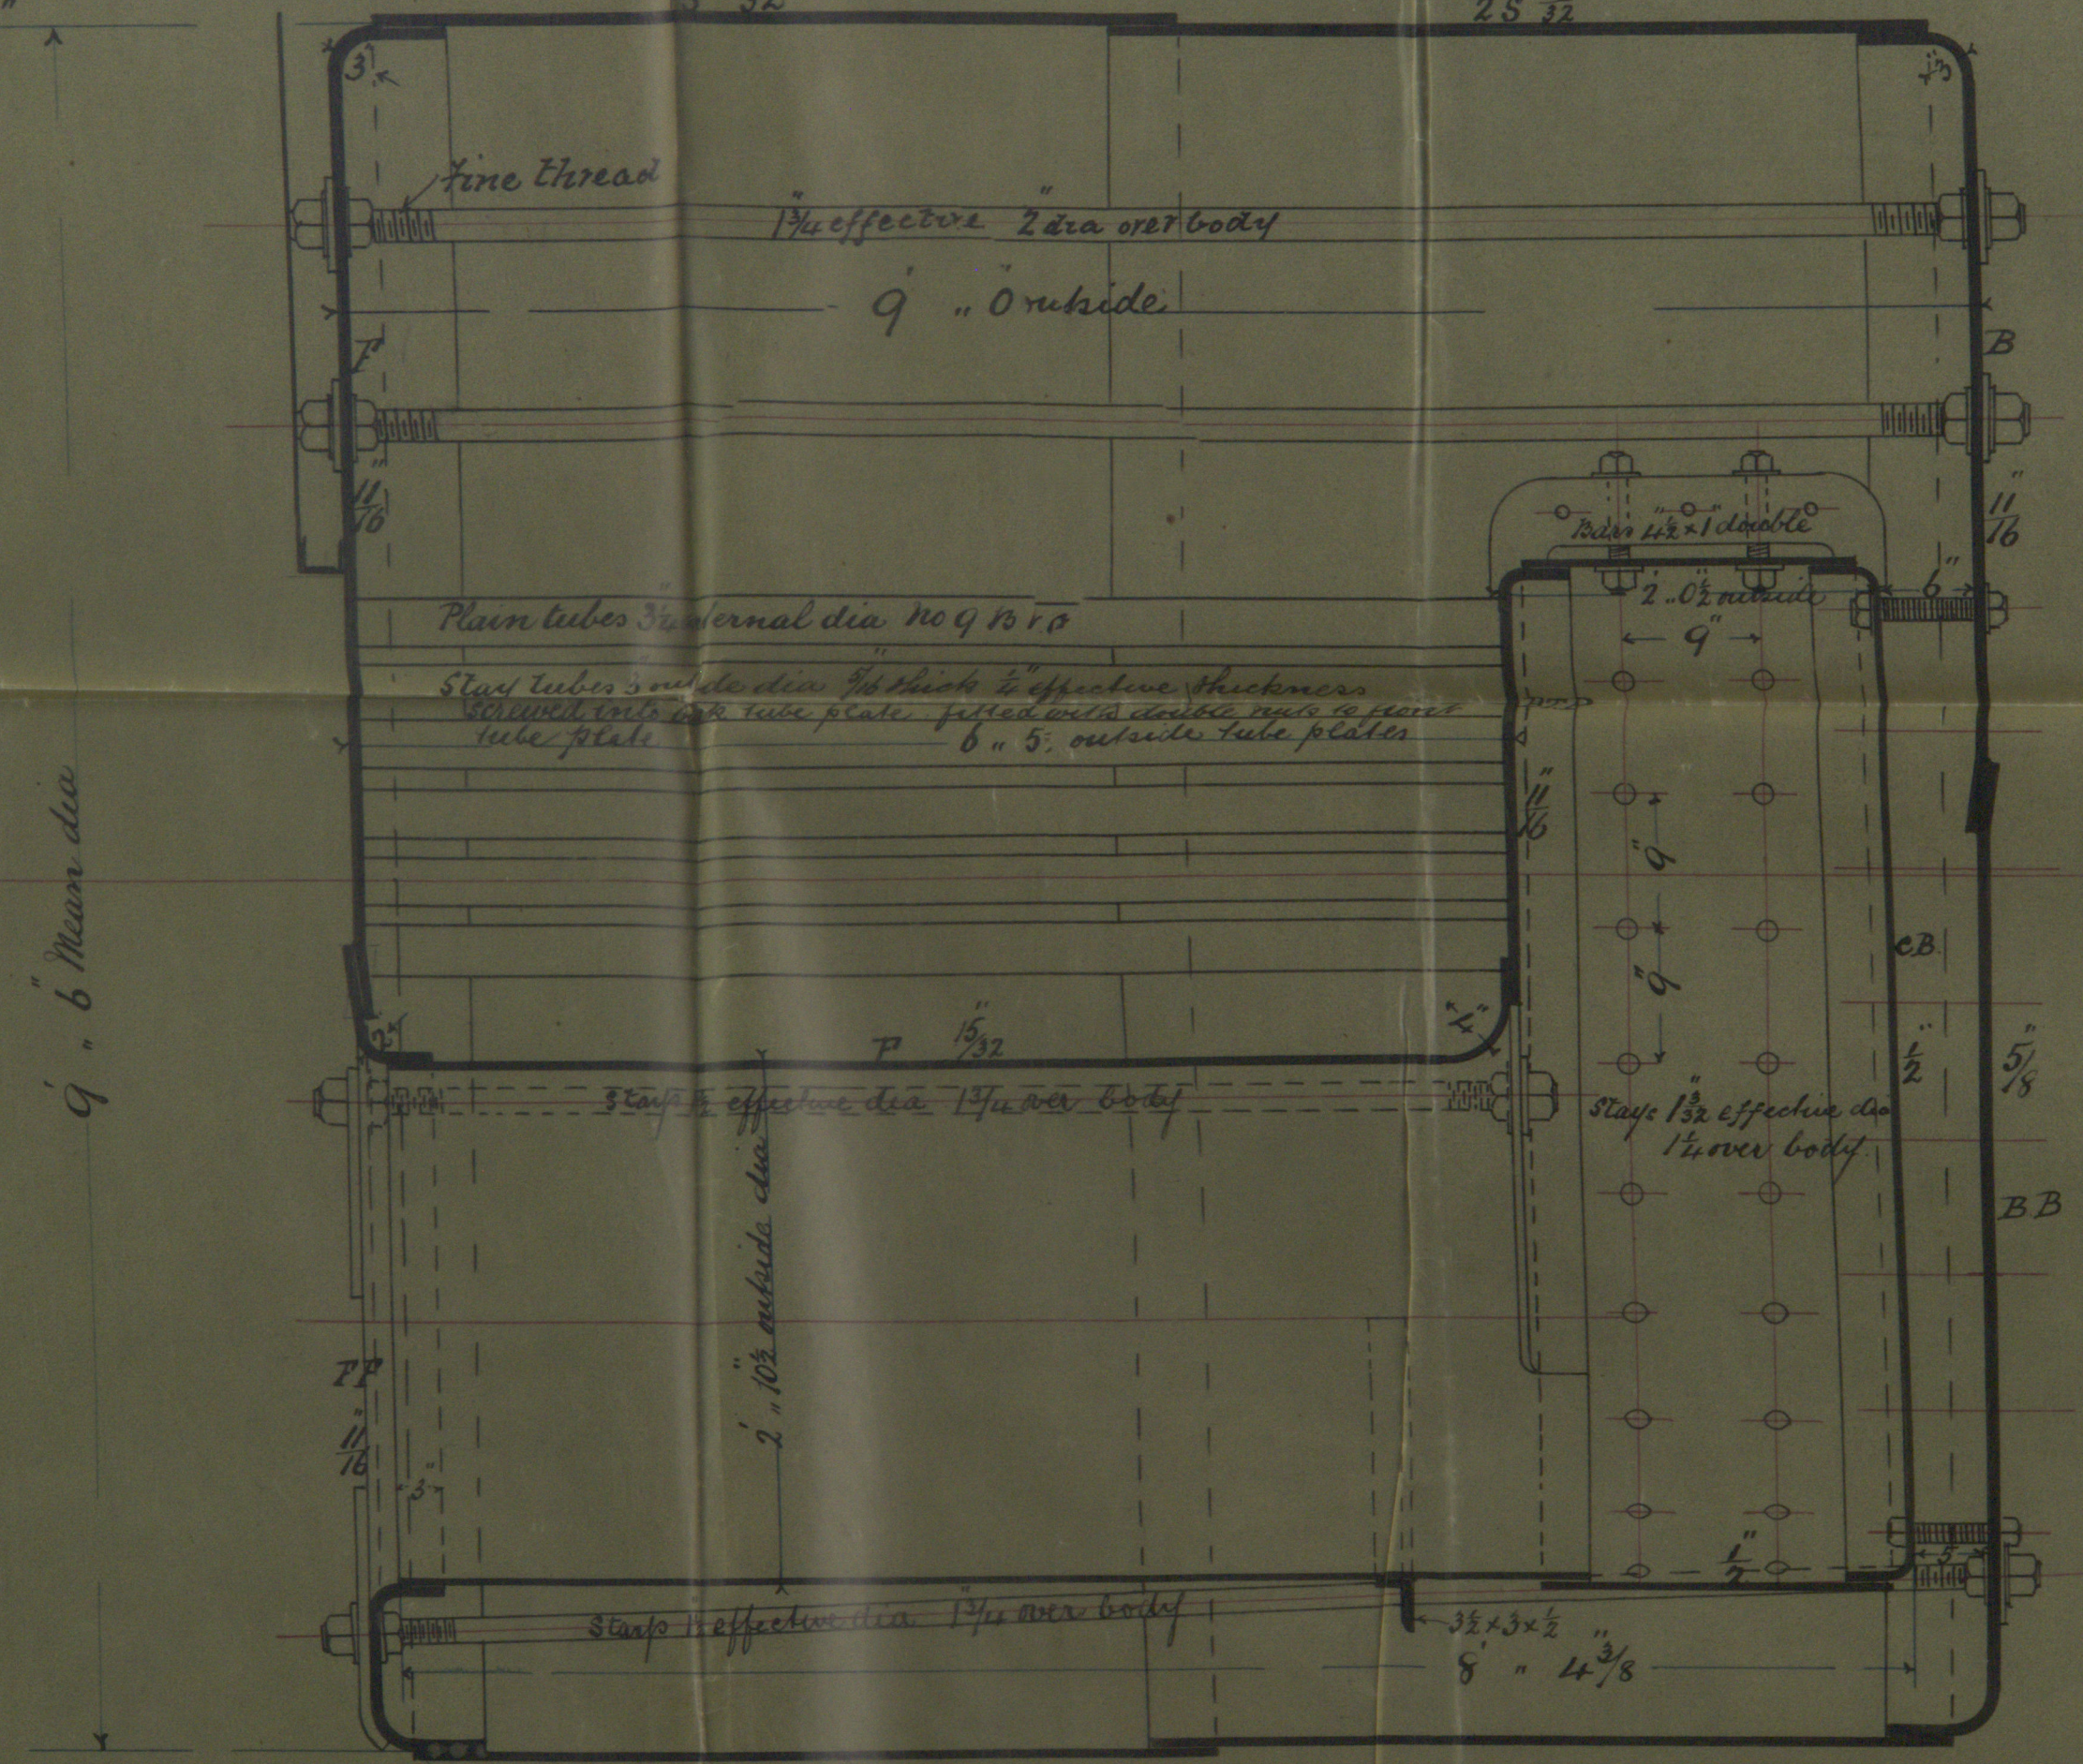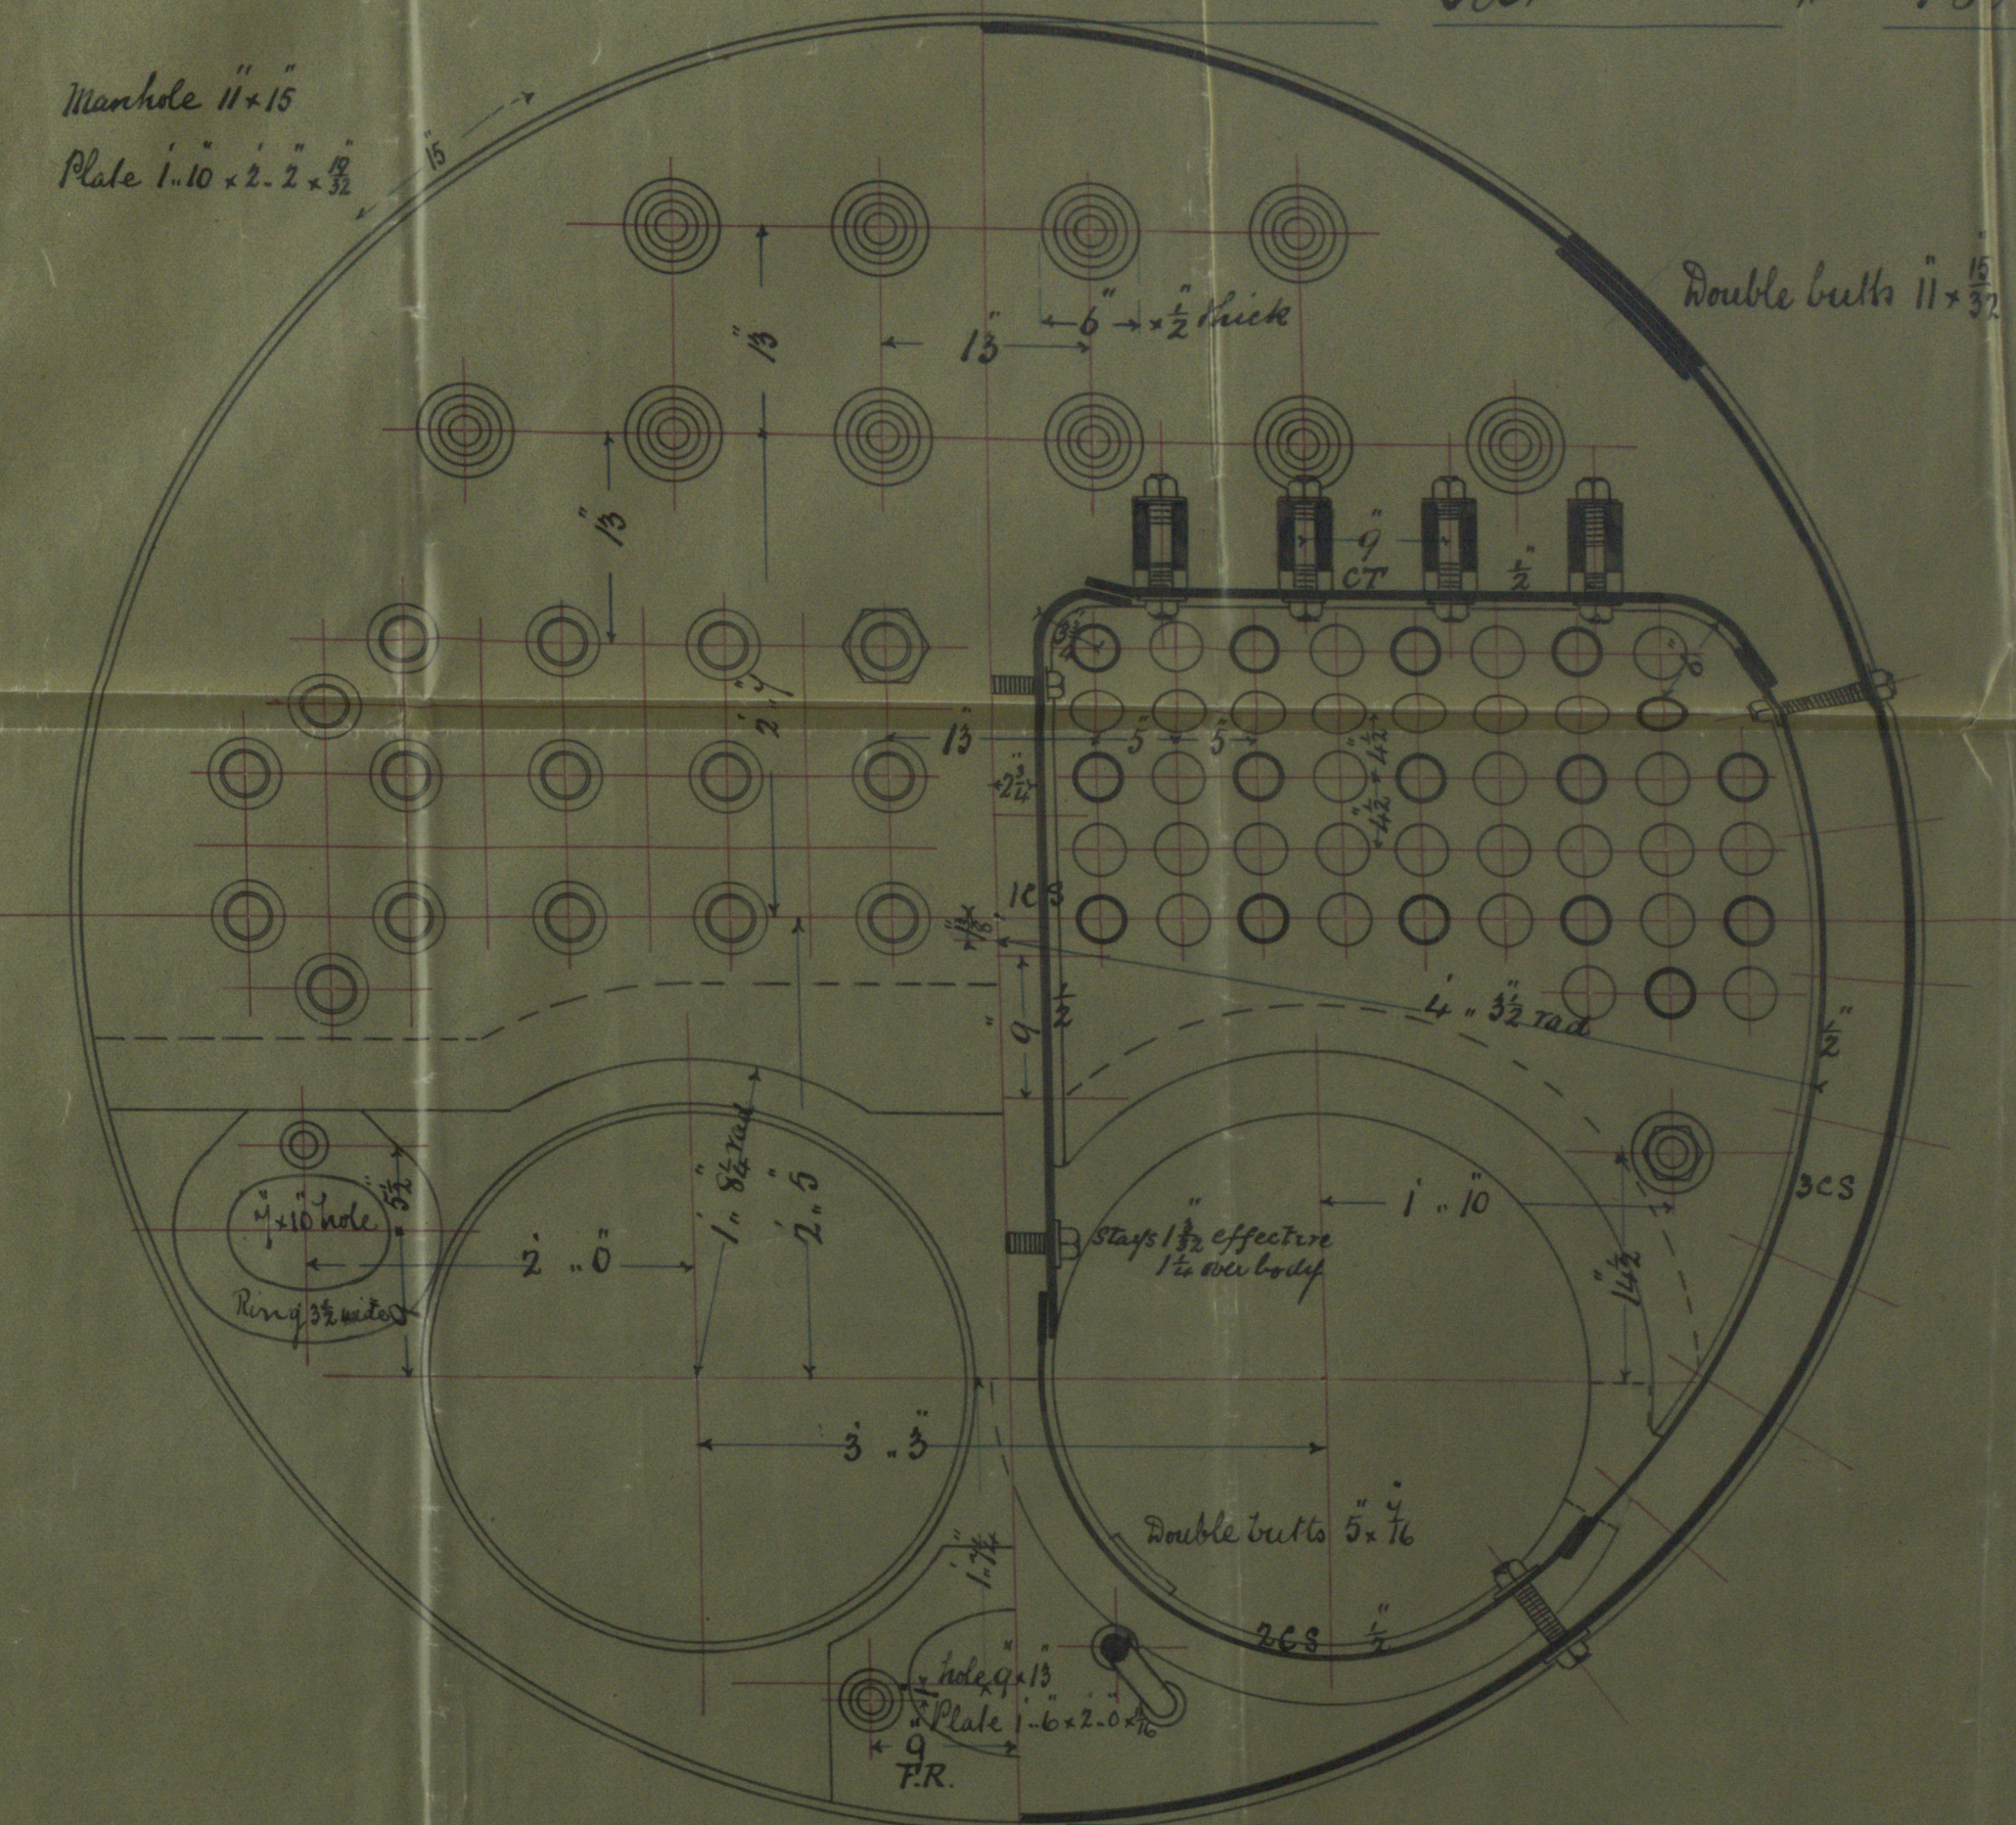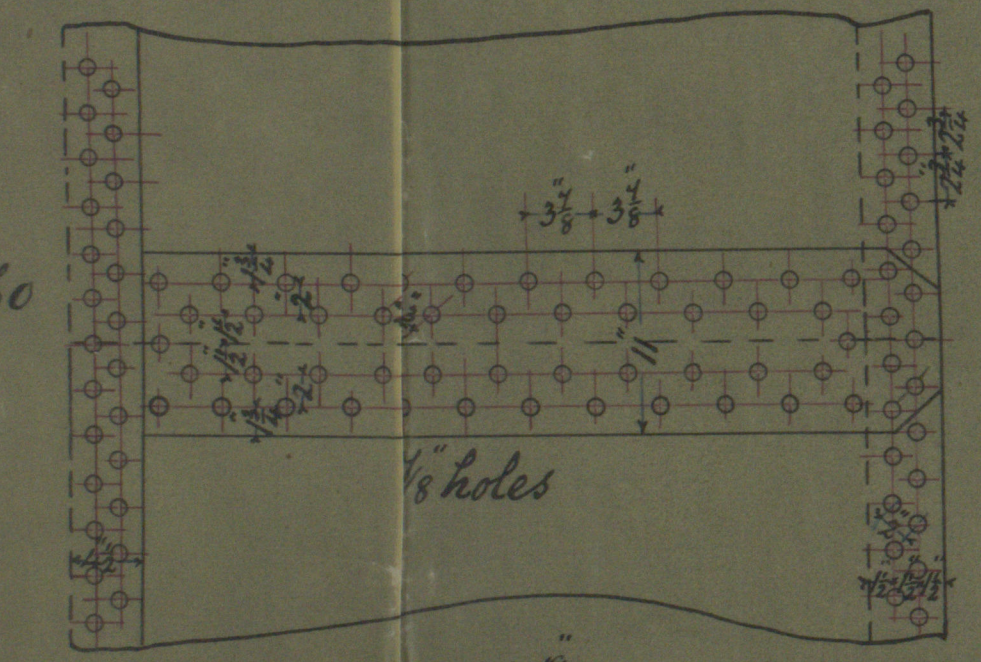


Note The plates & rivets to be of steel. Holes in shell & furnaces to be drilled in plate after bending. All plates to be annealed after being either punched or flanged. All stays to be of steel.



Boiler for
Messrs Cook, Wilton & Gemmels Steam Trawler No 15
Messrs Bailey & Leatham No 79 Boiler

pm
10/4/86

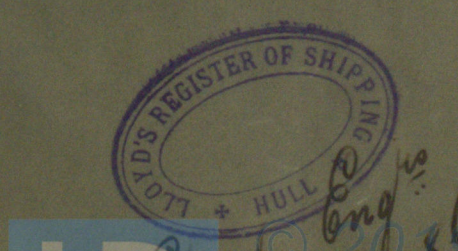

Lloyd's Register
Foundation
HVL 398 - 0298