


REGISTER OF
SHIPS

25. 1. 13

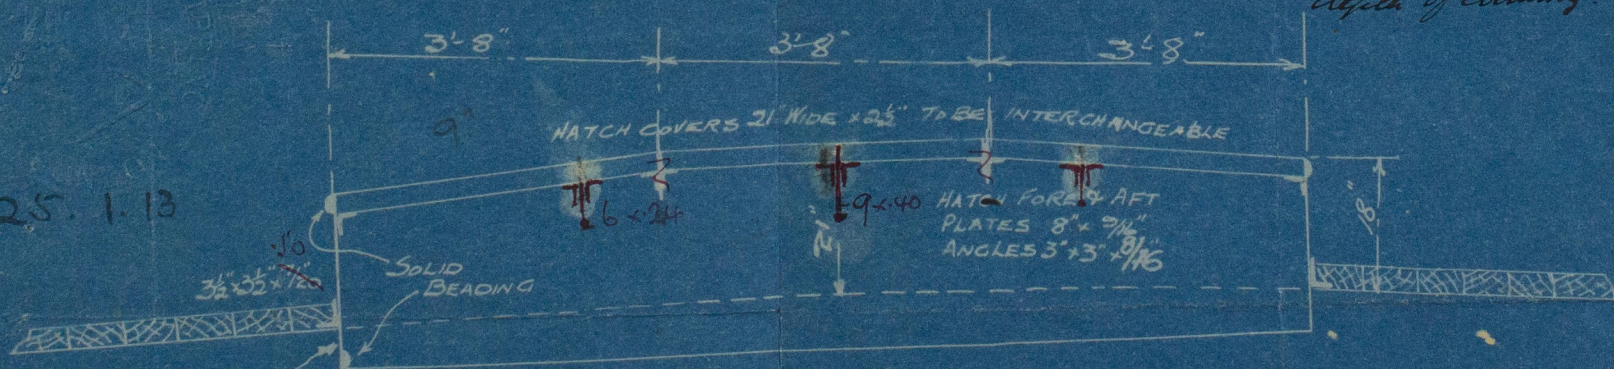

COAMING PLATES CARRIED
DOWN 6" BELOW DECK

Hatch 11'-0" x 15'-8"

Hatch Coaming

5/5 "RUGBY"

Repanners propose hatch web plate
7/20 thick, double 3 1/2" x 3 1/2" x 7/20 angle
on top & 2 half rounds on bottom
edge.

LR

24/1/13
ESSA

25. 1. 13

HVL401-0313

S.S. 'Rugby'

NEWCASTLE - ON - TYN

Report No 63853

HVL401-0313



© 2020

Lloyd's Register
Foundation