

THU 8 NOV 83

323

S. S. Kugly
Hull Report No.

MIDSHIP SECTION

RULE DIMS. 86'4" x 20'0" x 11'75"


SCALE 1/2" = 1'

CLASS 100A IRON

for fishing purposes

Half Breadth 10.0
" Girth 17.33
Depth 11.75
39.08
86.4

3376.51

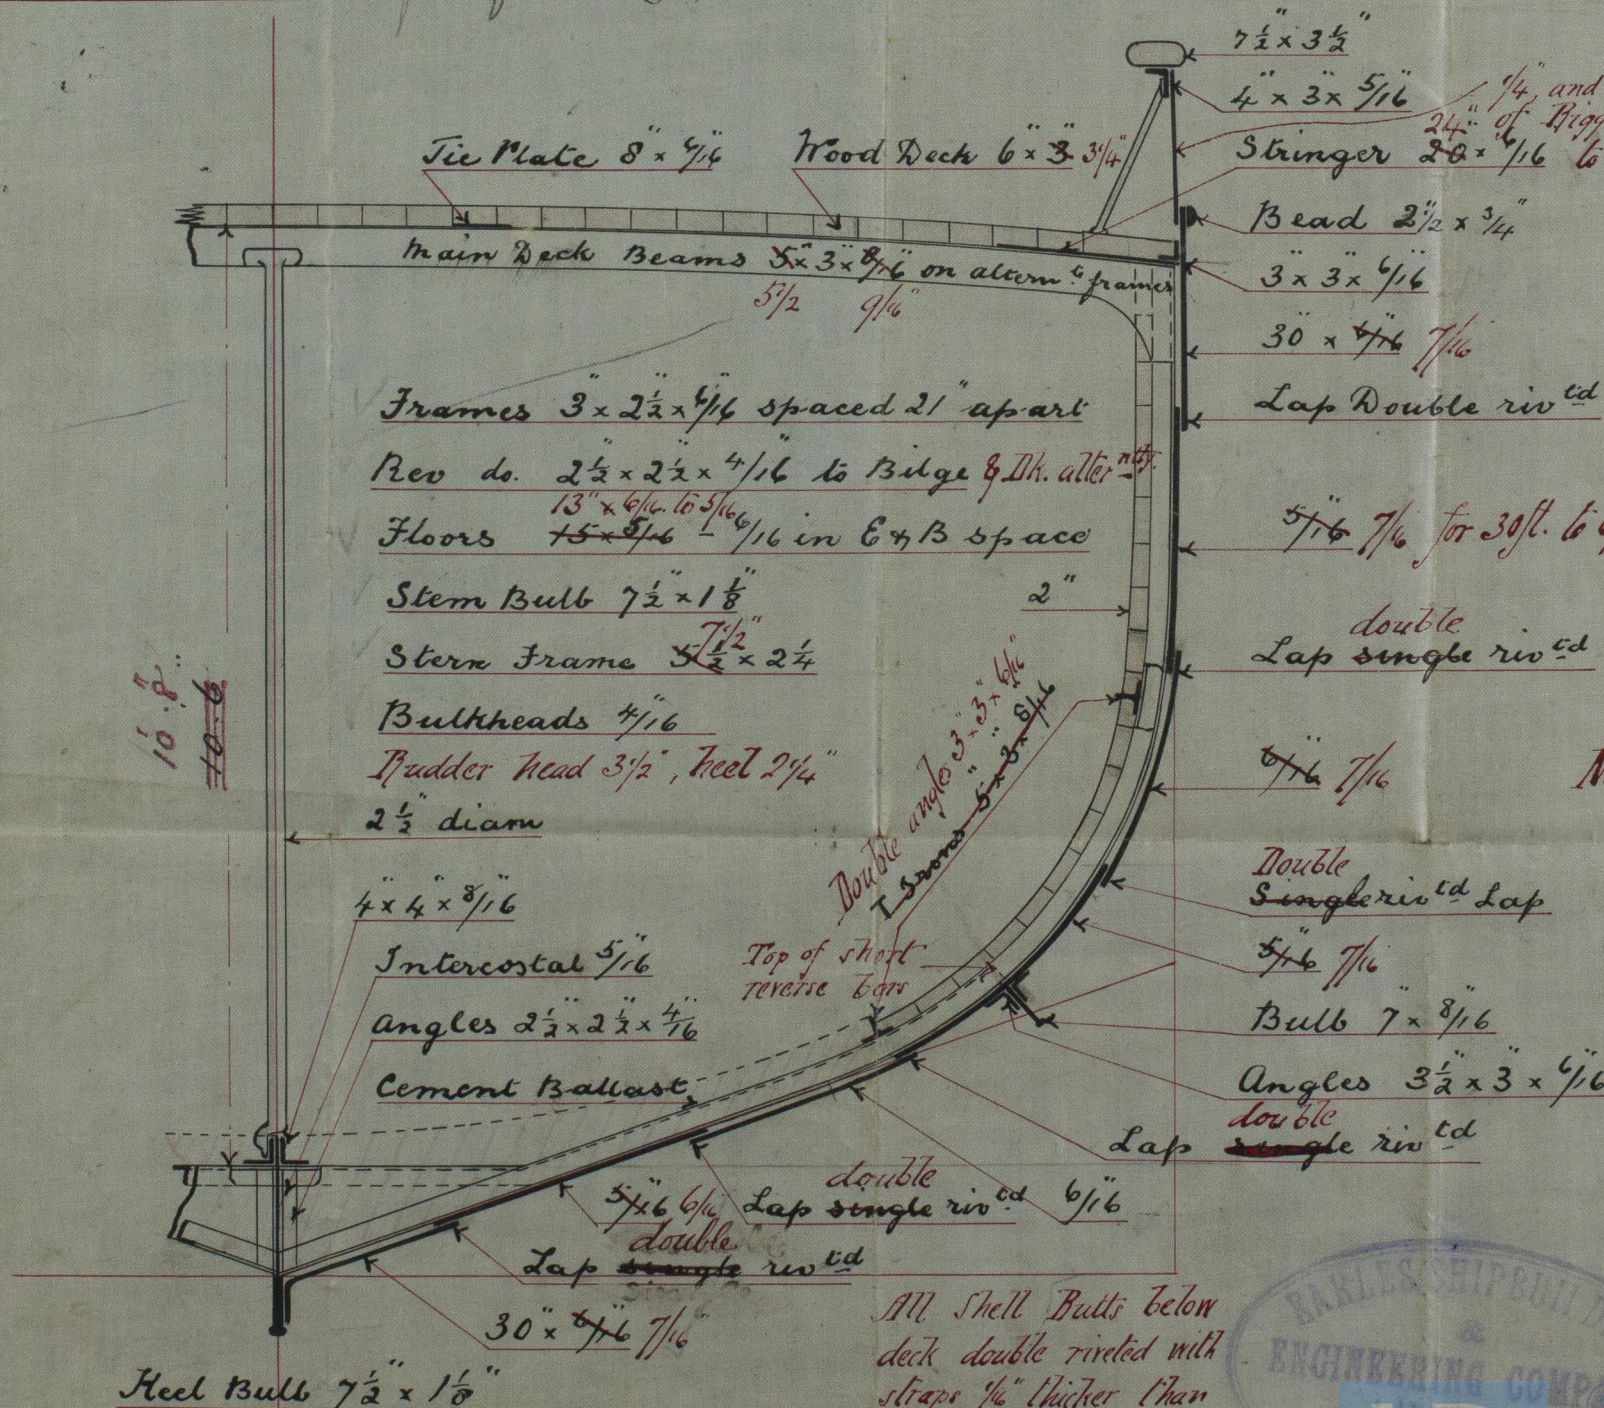

Note. Scallings in red are as in ship

All Shell Butts below deck double riveted with straps 1/4" thicker than plates


7-2-11-88

W.M. J.H.

7/11/88



Lloyd's Register
Foundation

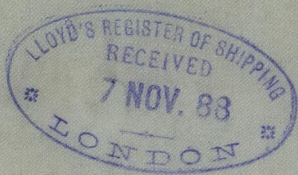

HVL 401-0315

© 2020

Lloyd's Register
Foundation