


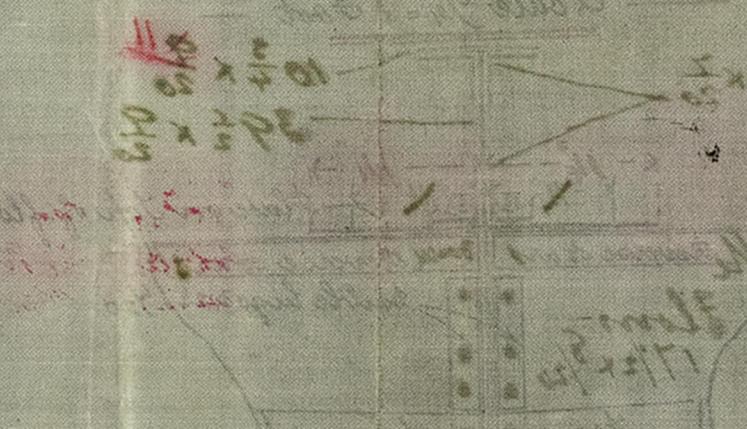

© 2019
Lloyd's Register
Foundation

HUL402-0116.1



2/7/1871

TUE 23 JUL 89


See letter

Copy b/w, double mounted

- No 330 -


Sketch of Centre Heelson in way of Engines & Boilers

— Scale $\frac{1}{4}$ " - One Foot —

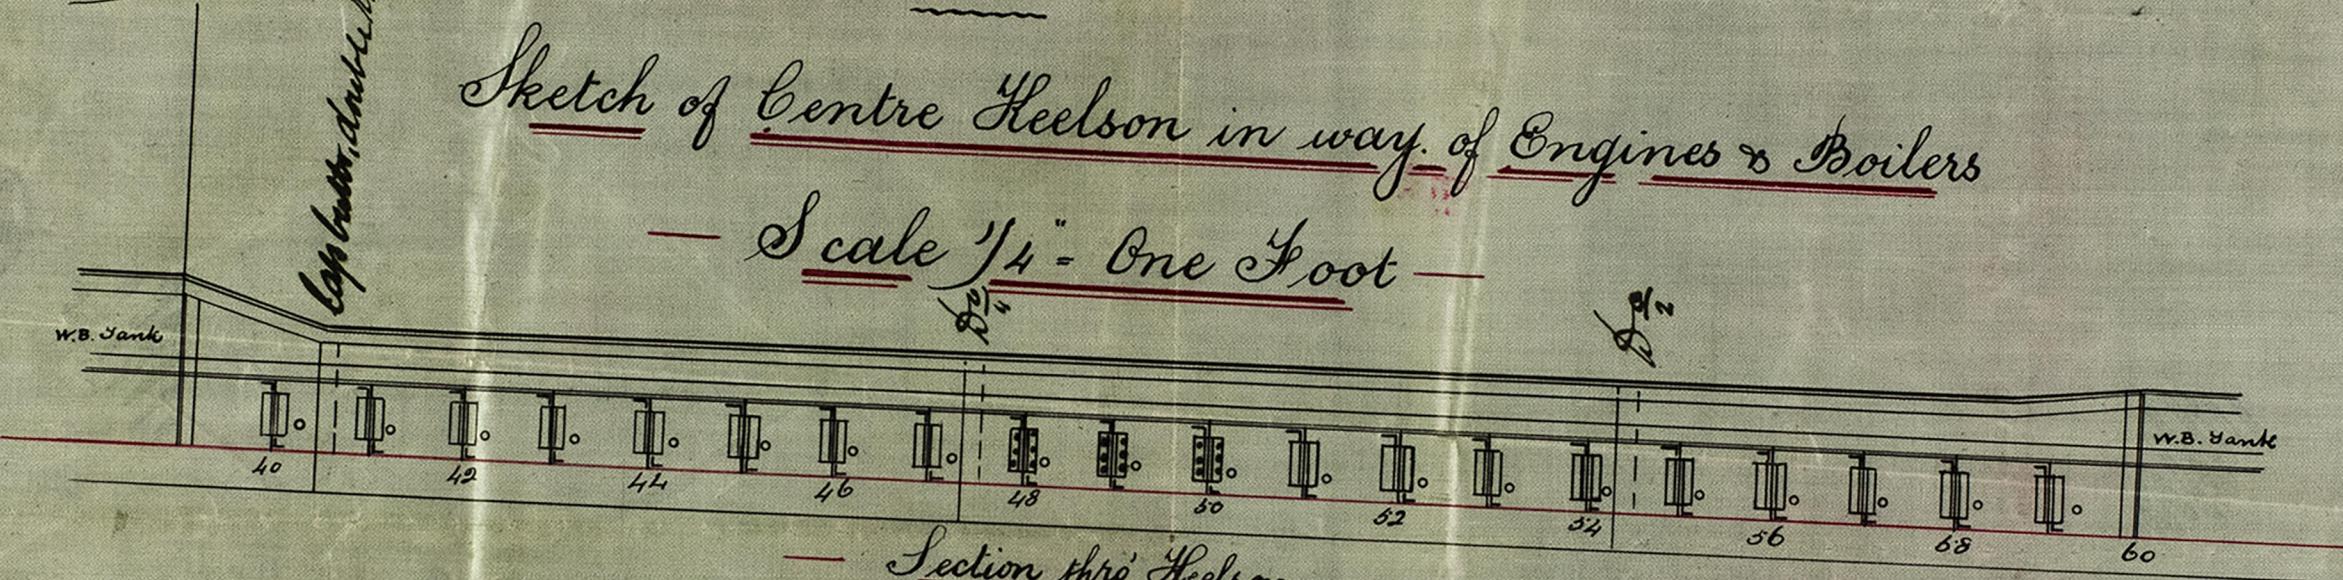

— Section thro' Heelson —

— Scale $\frac{1}{4}$ " = 1 Foot —

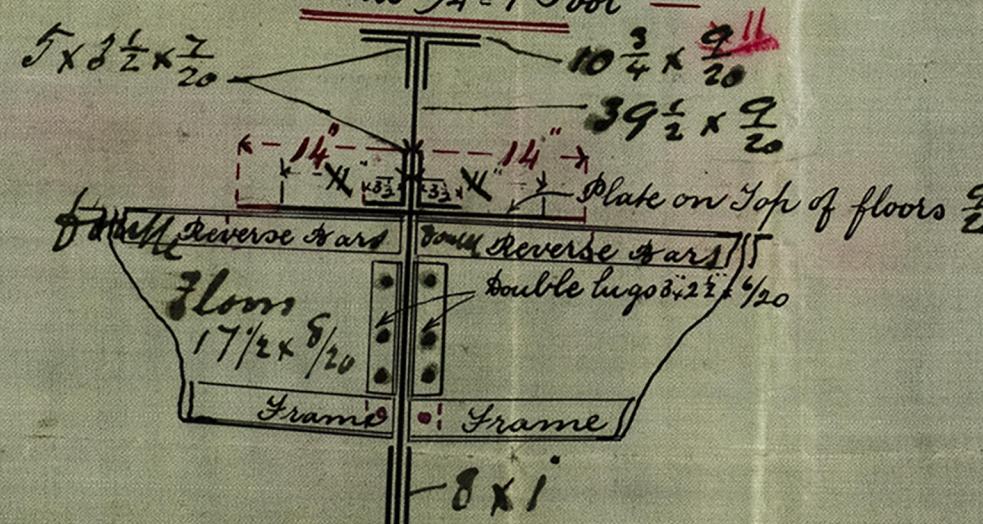

Note! This sketch shews Rider plate
on top of floors extending 3" in
lieu of floor lugs being carried
full depth.

7/23/17-7-89



J.T.H.
23/7/89



© 2019
Lloyd's Register
Foundation

HULL02

Q116.1