

Ltr. 15/8/89


S.S. Liberty
Hull Report No.

— No 330 —


— PUMPING ARRANGEMENT —

— SCALE $\frac{1}{8}$ " = ONE FOOT —


— DIMENSIONS 225' 0" x 33' 0" ex x 13' 11" TO FLOORS —

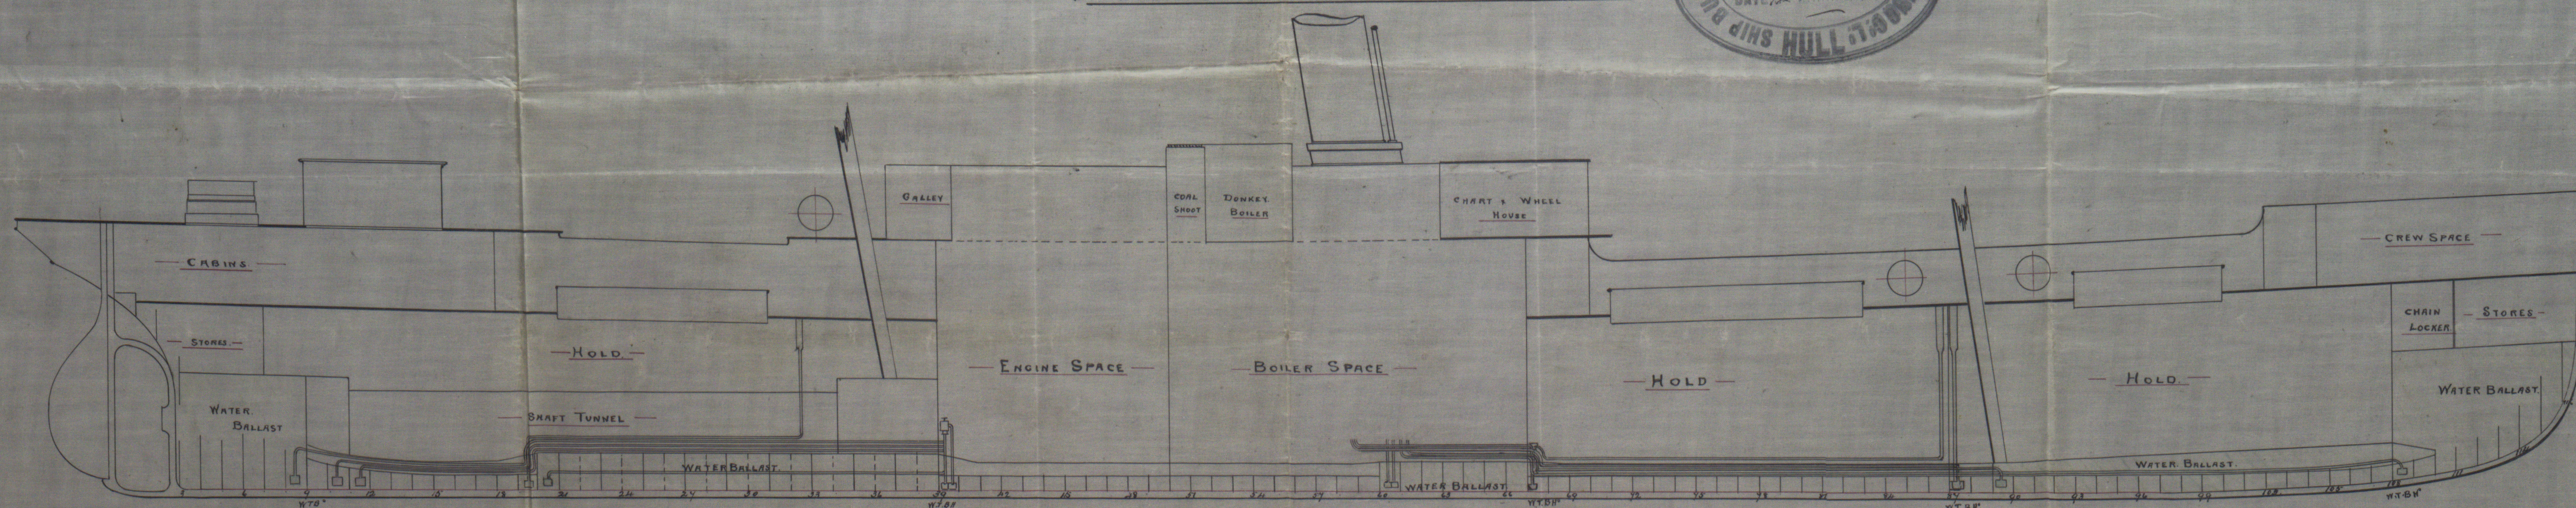

— DECK PLAN —

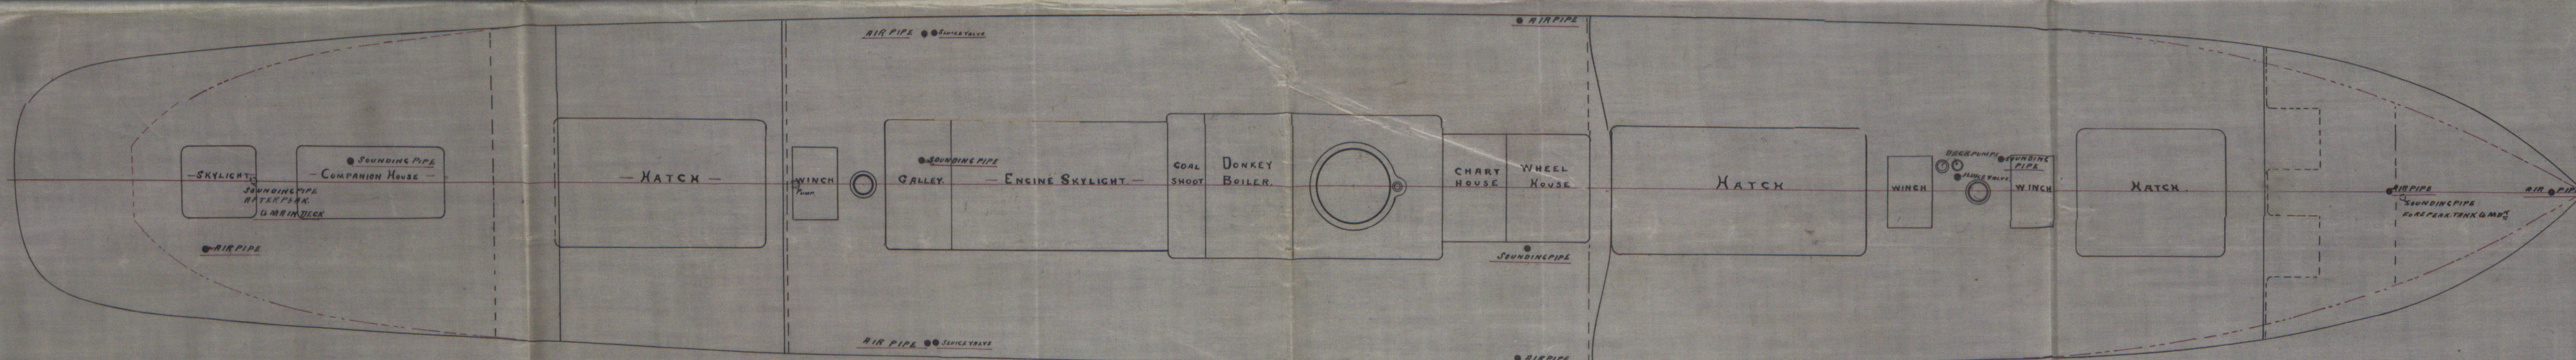

— PLAN OF HOLDS AND TANKS —

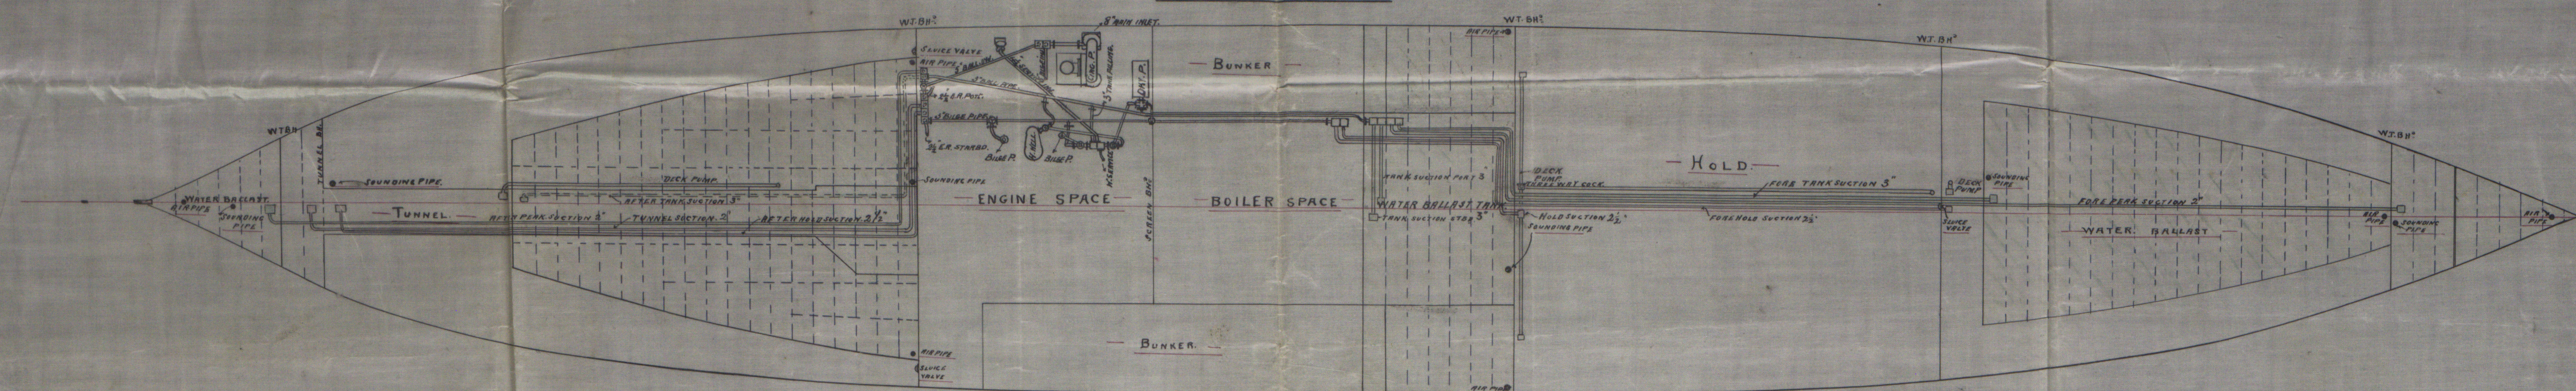

N.A.
12.8.89



HULL 02-01