

THU 1961  
MED 12001 83

3/5 "Liberty"  
Hull Report No.


No 330

Sketch showing alteration to Boiler Hatch


compensation in way of same

Scale  $\frac{1}{4}$ " = one foot

Elevation


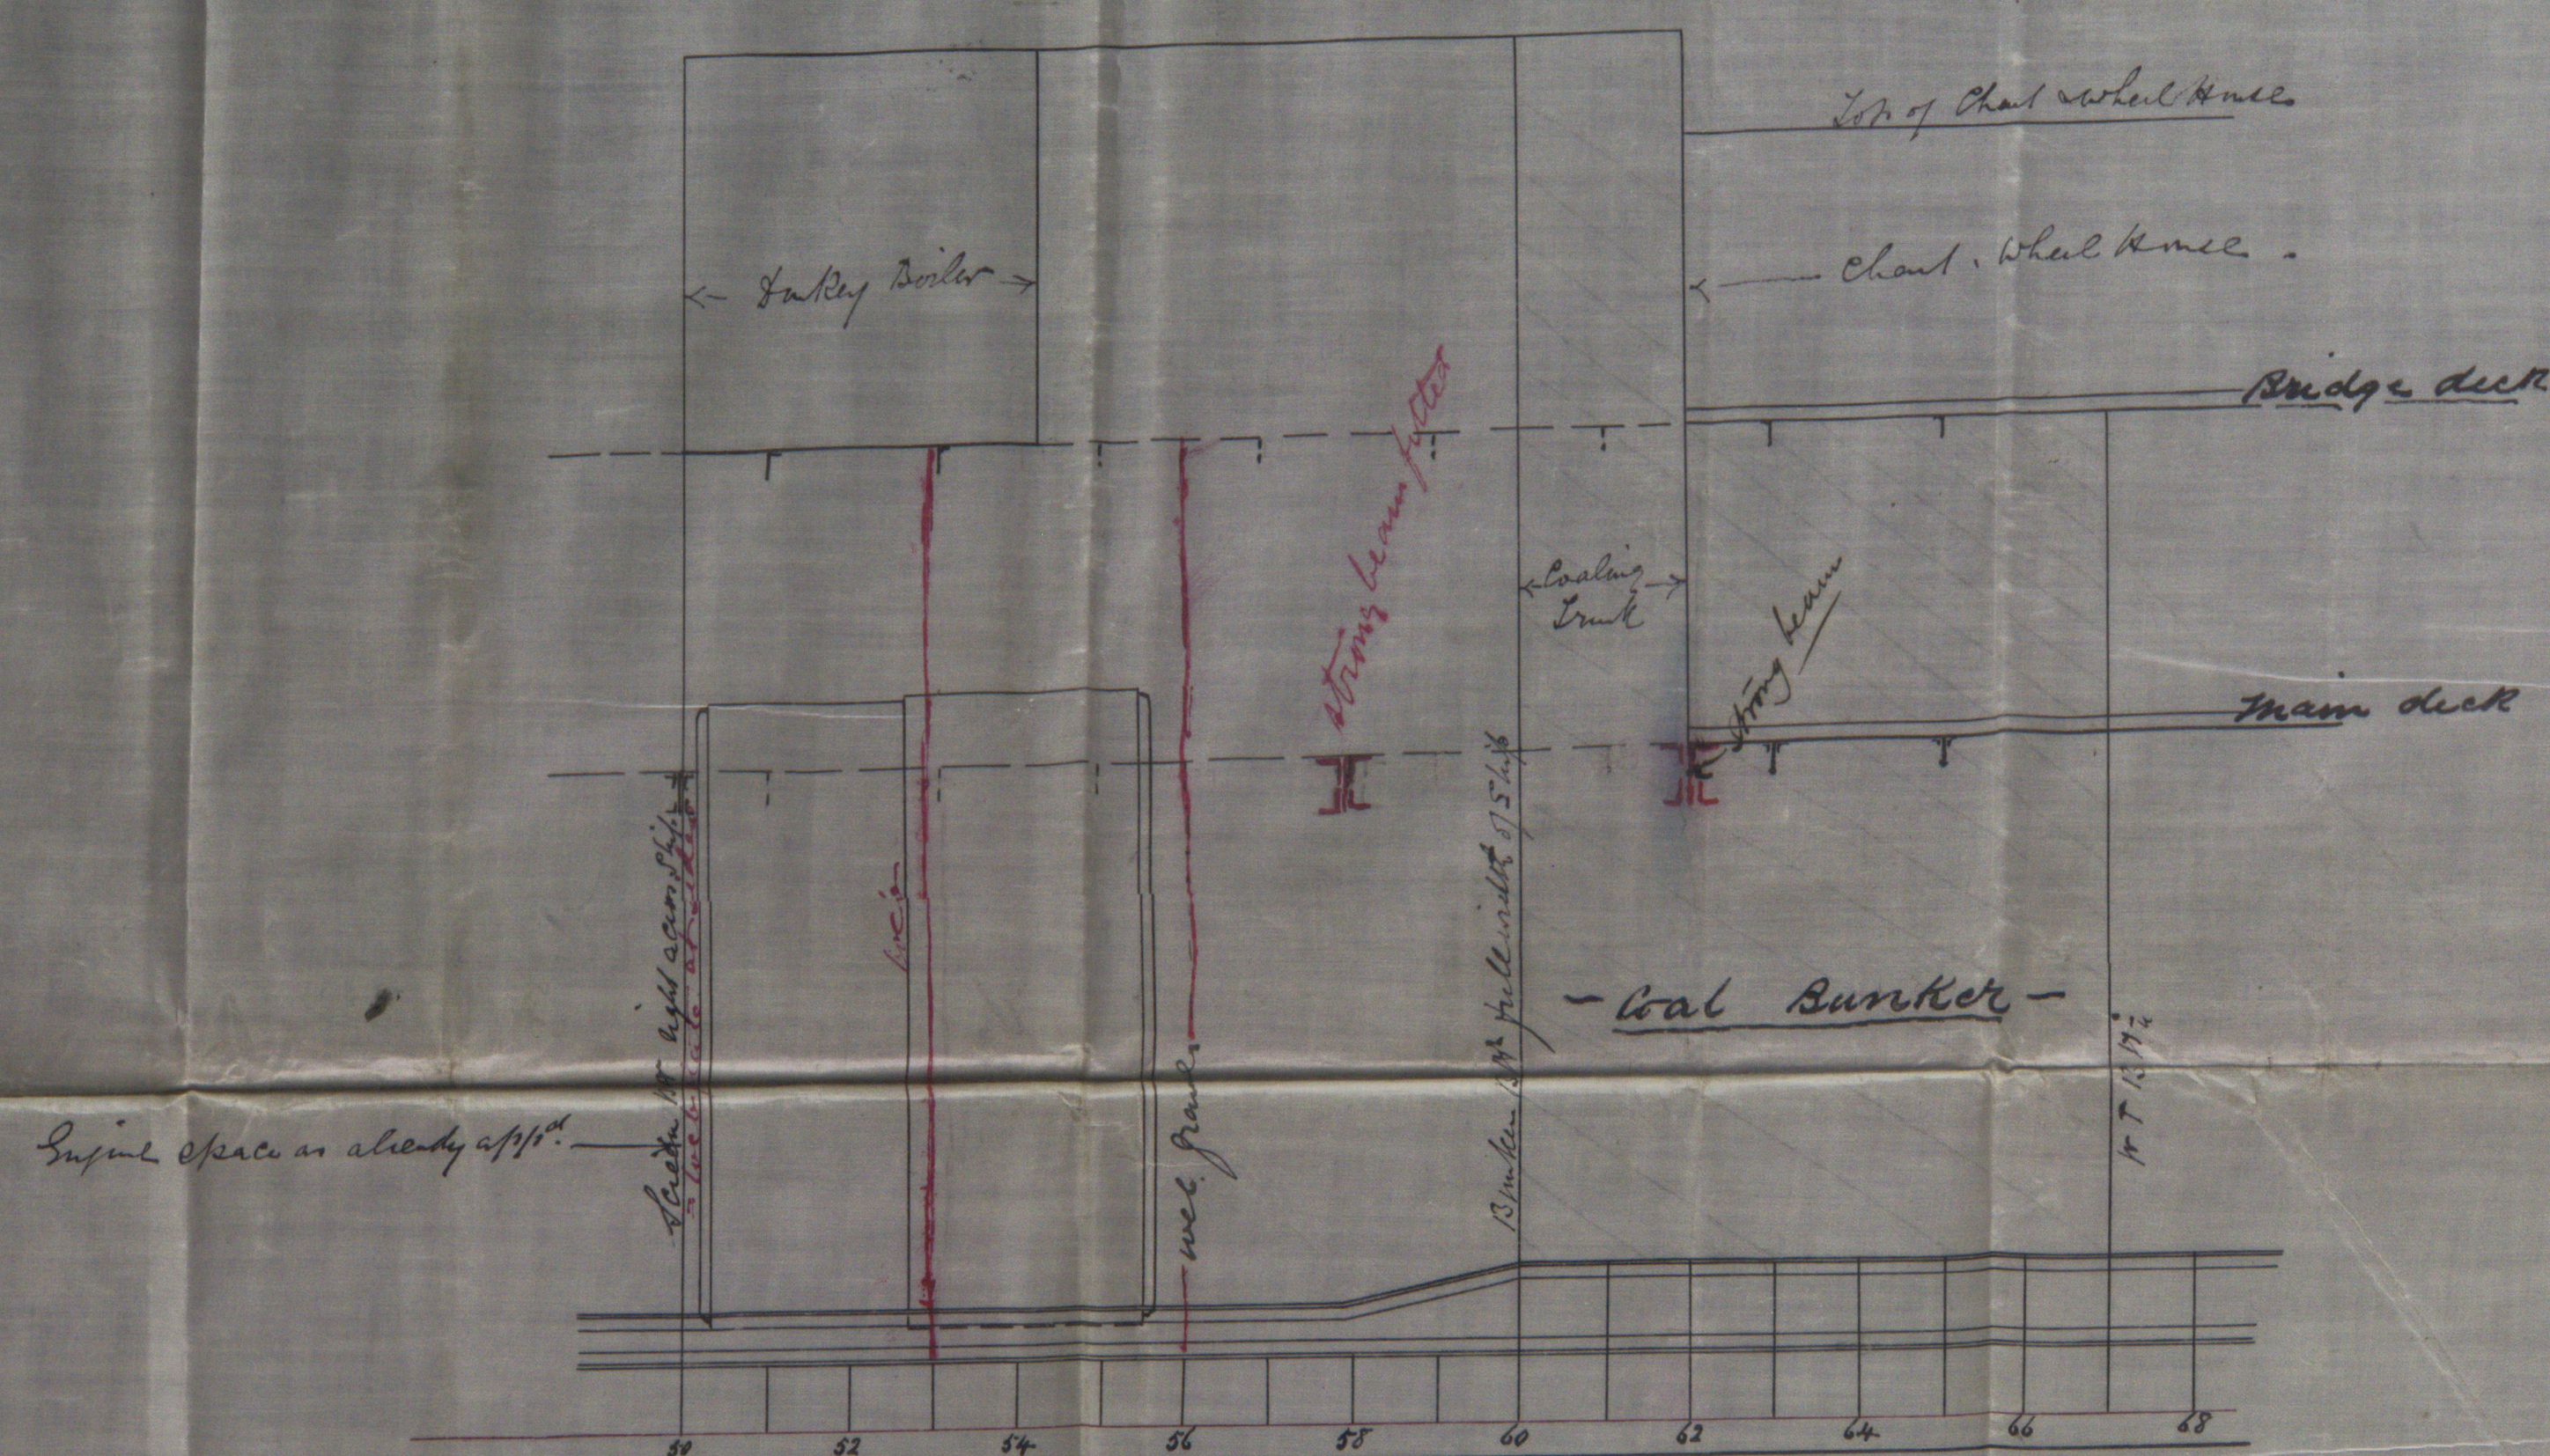


Plan of main deck

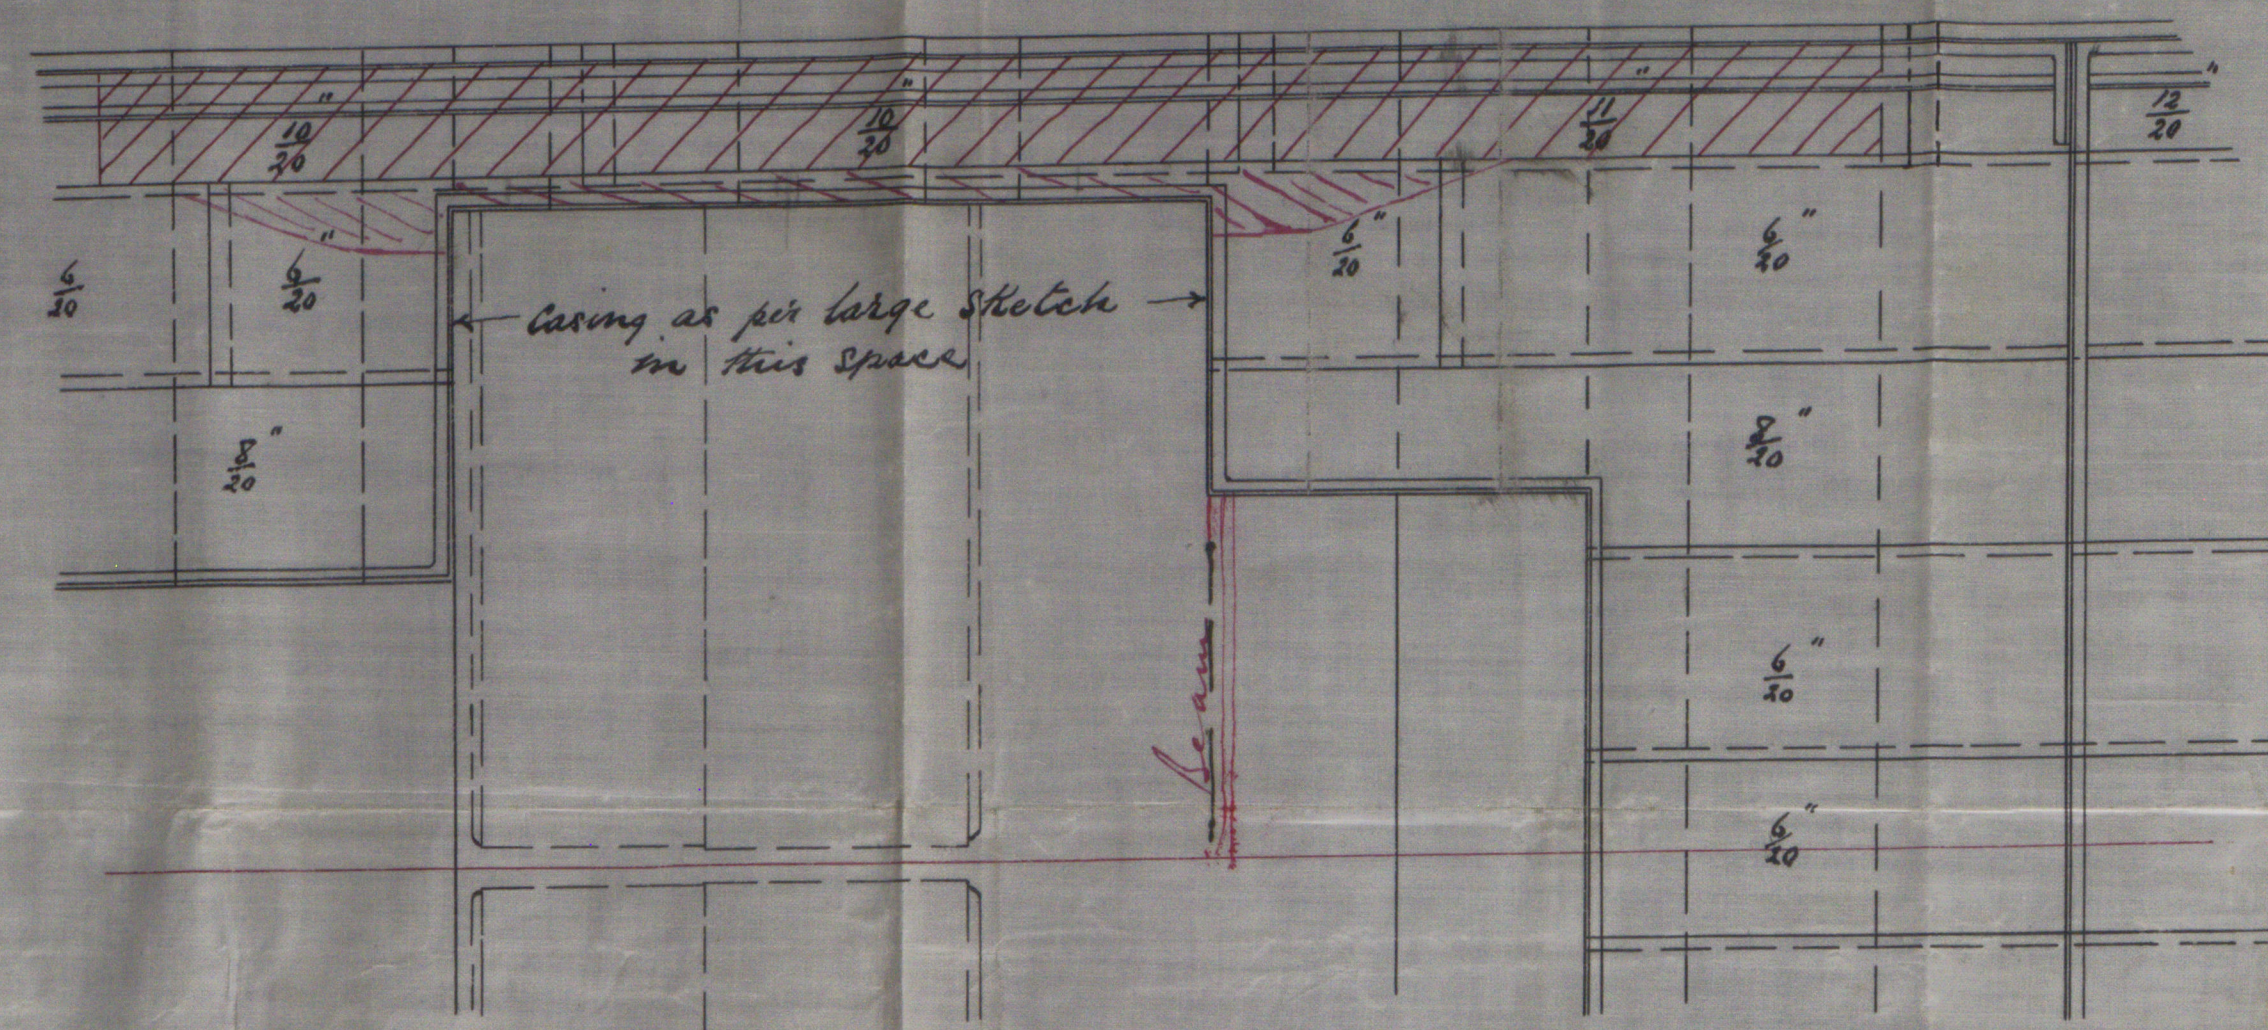

Section at frame 52

Scale  $\frac{1}{2}$ " = one foot

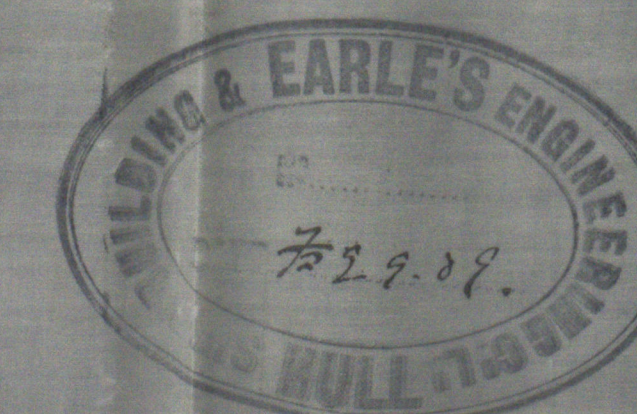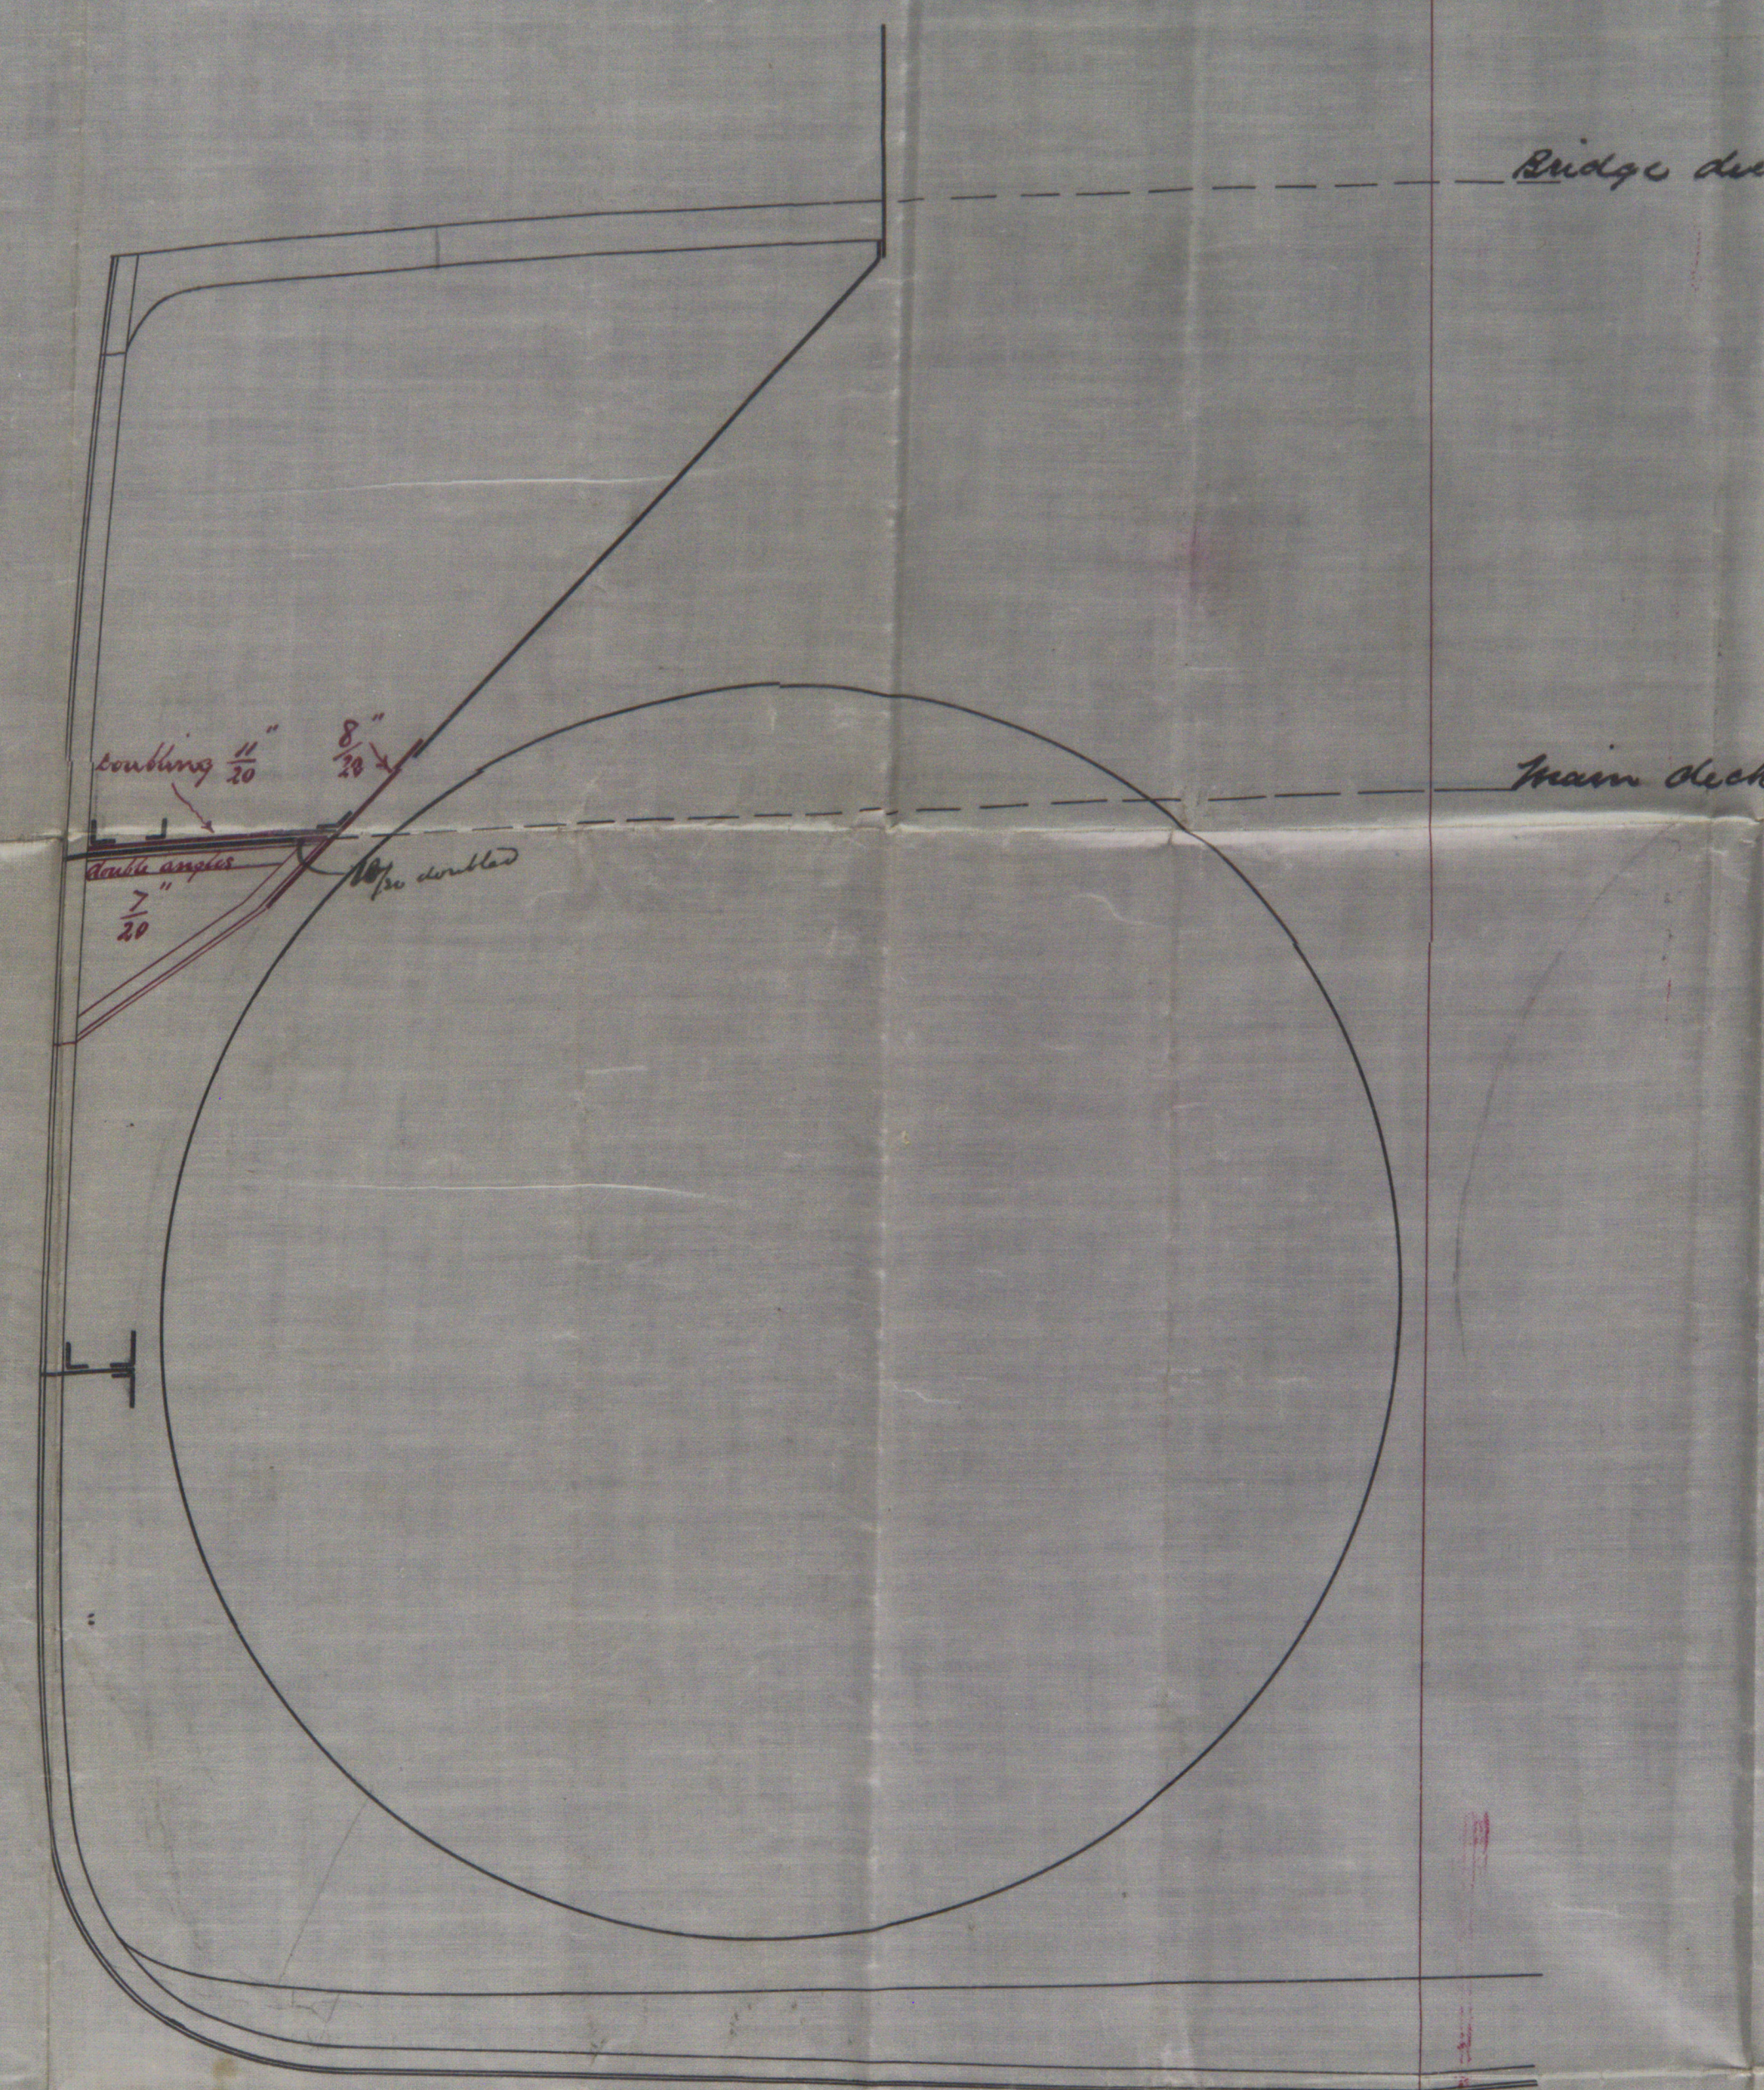

Letter  
1949/54

HULL 2135